
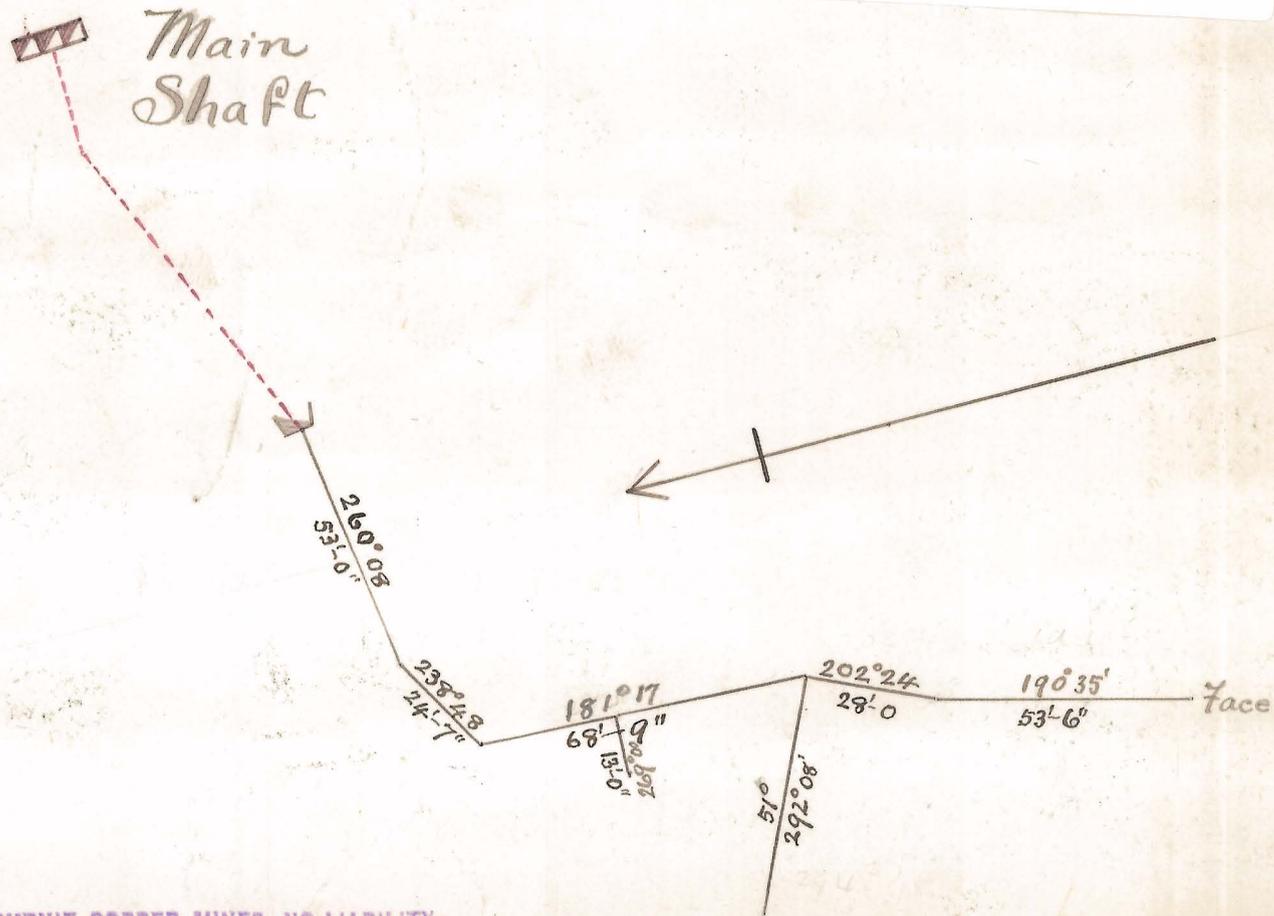


342
05

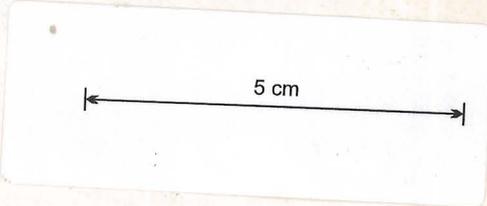

BURNIE COPPER MINES, NO-LIABILITY

Showing Traverse Lines
of N^o 1 Tunnel
24.6.08

Legd Hancock

Scale 40' = 1"