
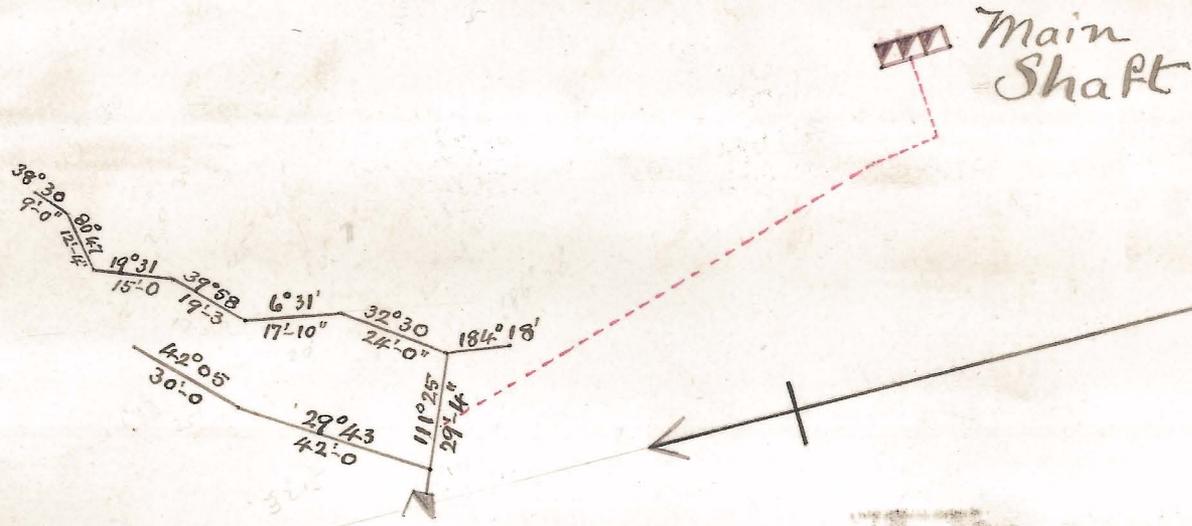


342
06

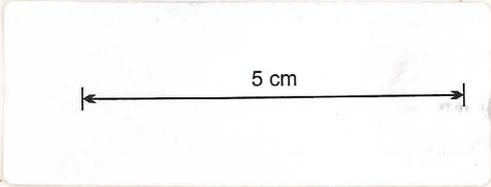

BURNIE COPPER MINES, NO-LIABILITY

Showing Traverse Lines
No 3 Tunnel and
Connection with Shaft

24. 6. 08

Lefy D. Hancock

Scale 40' = 1"