
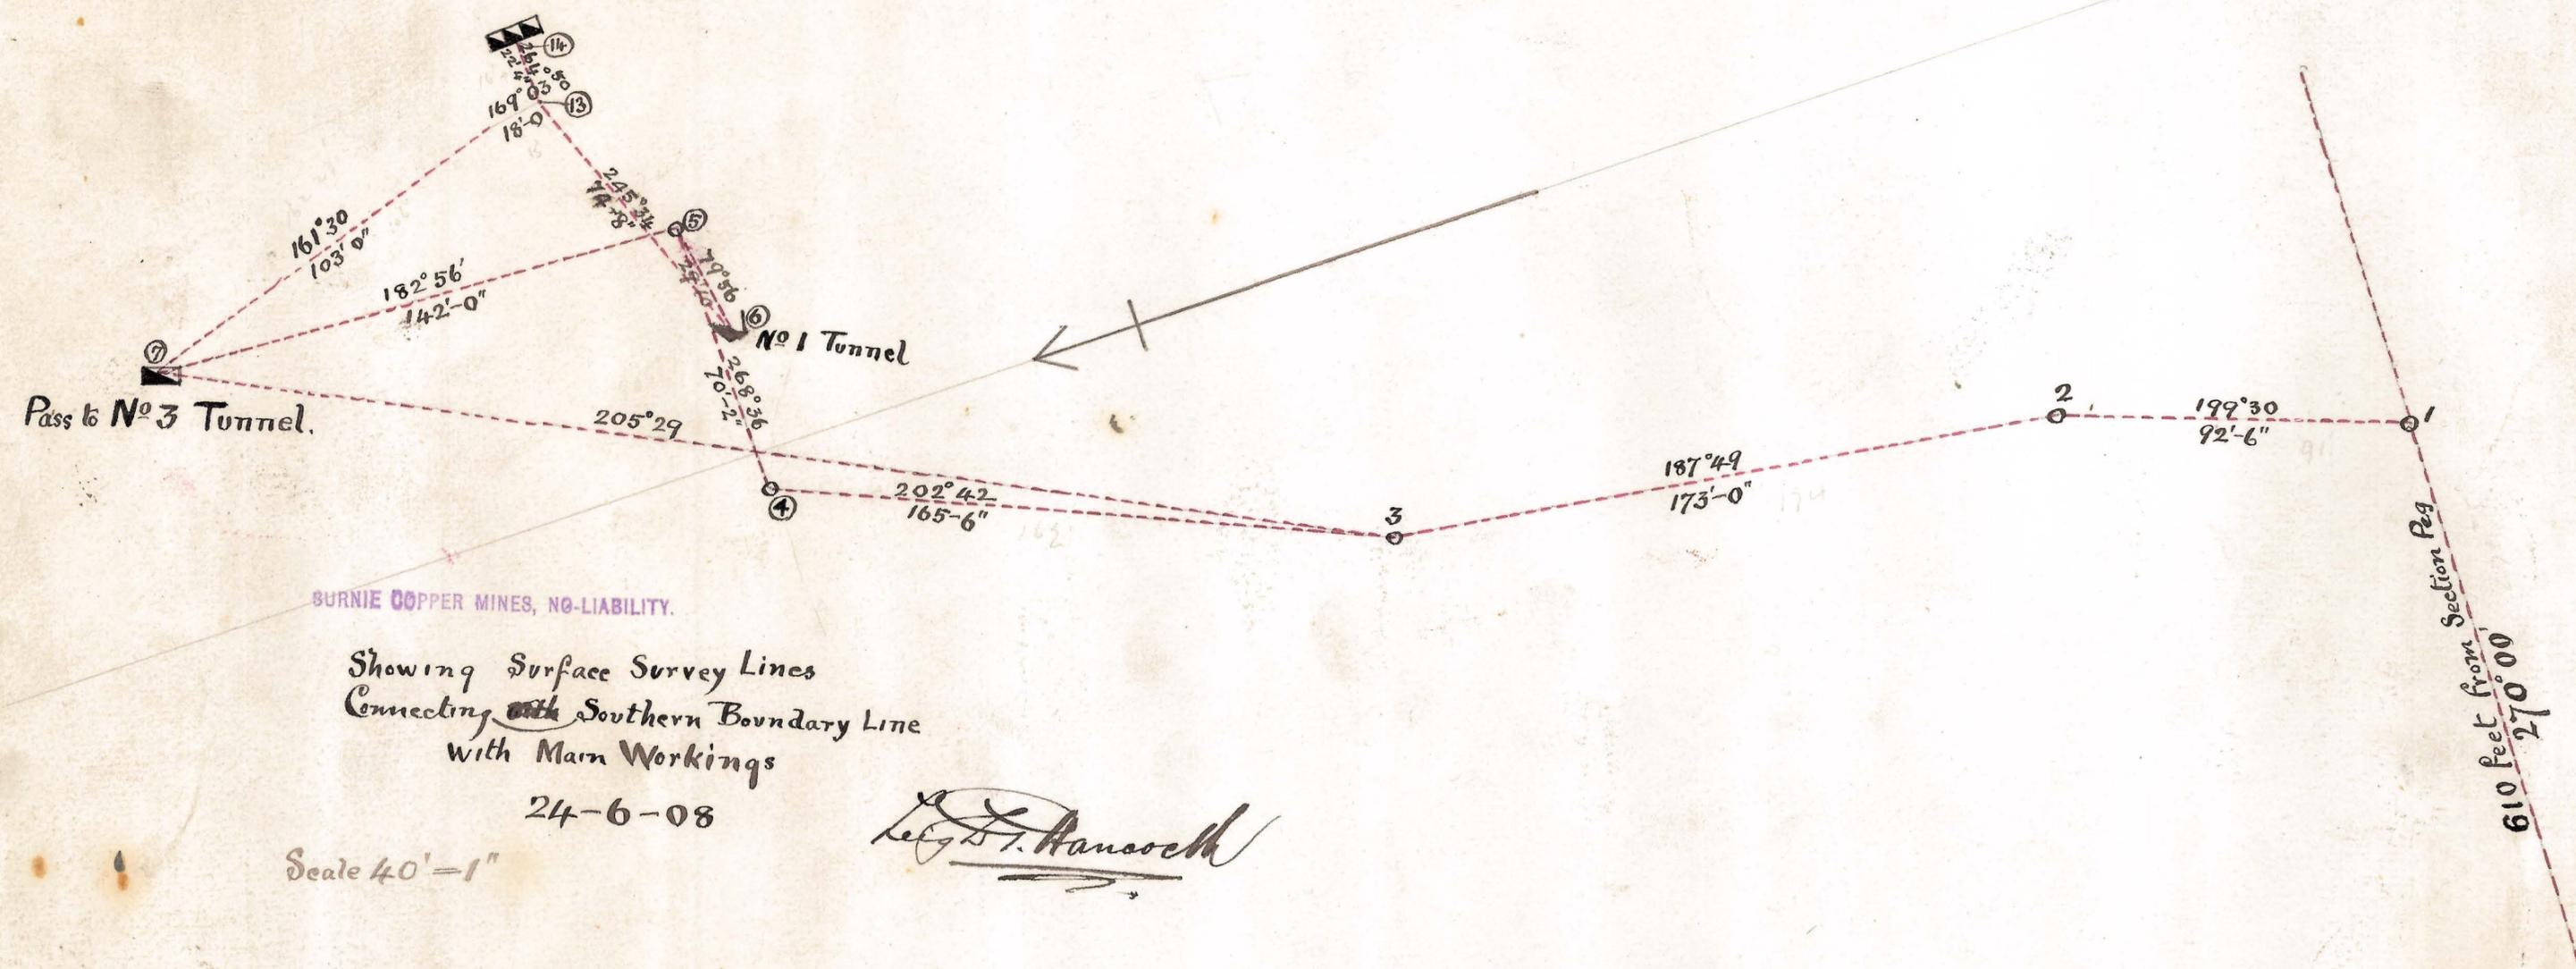


342
07

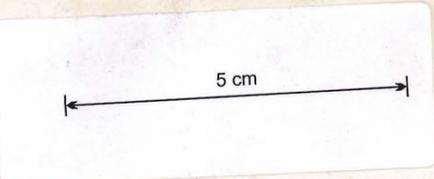

BURNIE COPPER MINES, NO-LIABILITY.

Showing Surface Survey Lines
Connecting with Southern Boundary Line
with Main Workings

24-6-08

W. L. Hancock

Scale 40' = 1"