


343
02

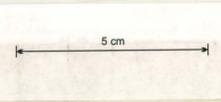

Gross Section

Longitudinal Section

GOLDEN POINT & CROWN



G. M. C.

Scale 25 feet to an inch

References

- No 1 190 feet
- No 2 270 feet
- Ground Sloped

Boundary North

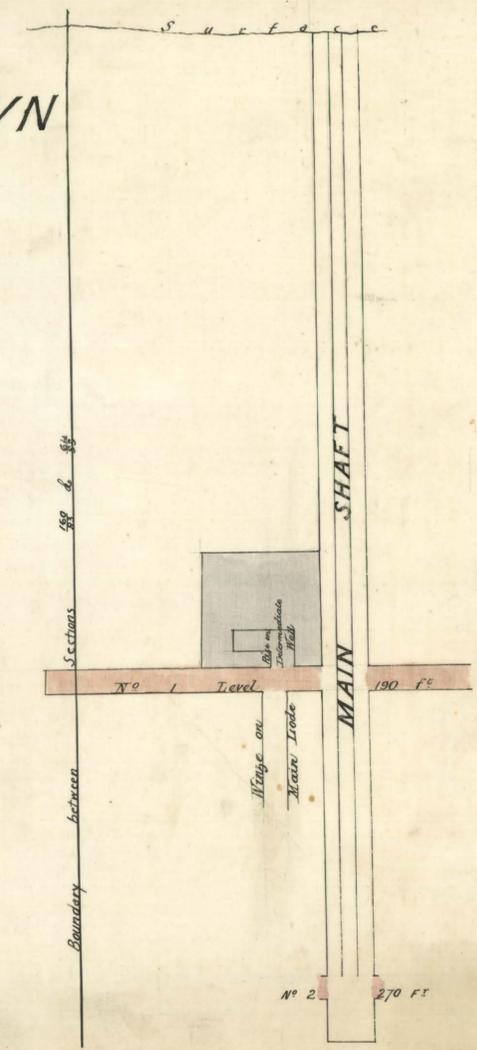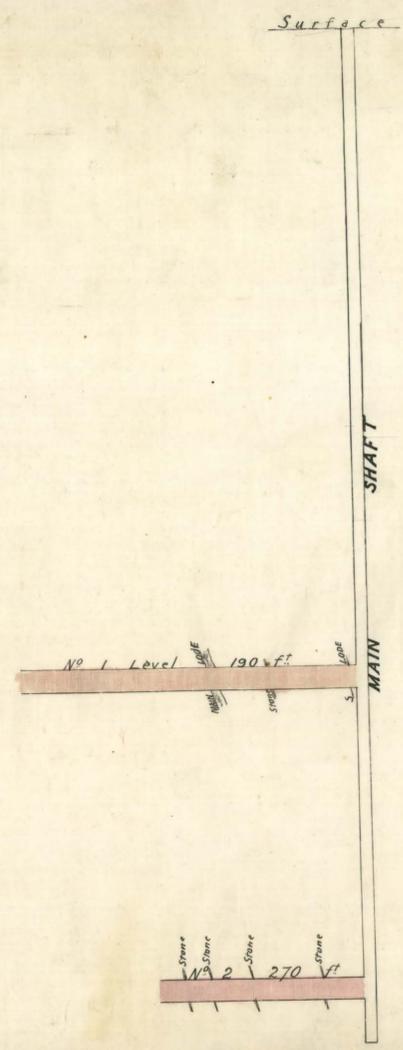

A. P. Miles.
Surveyor
Launceston
Mar '96

A. P. Miles.
Surveyor
Launceston
Mar '96

To send 7 lines of notes
to east wall
Mar 1896