

343  
03

24


2008/11/11  
2008/11/11

# Golden Point and Crown G M Co

Scale 25 feet to an inch

### References

- No 2 270 ft
- No 1 190 ft

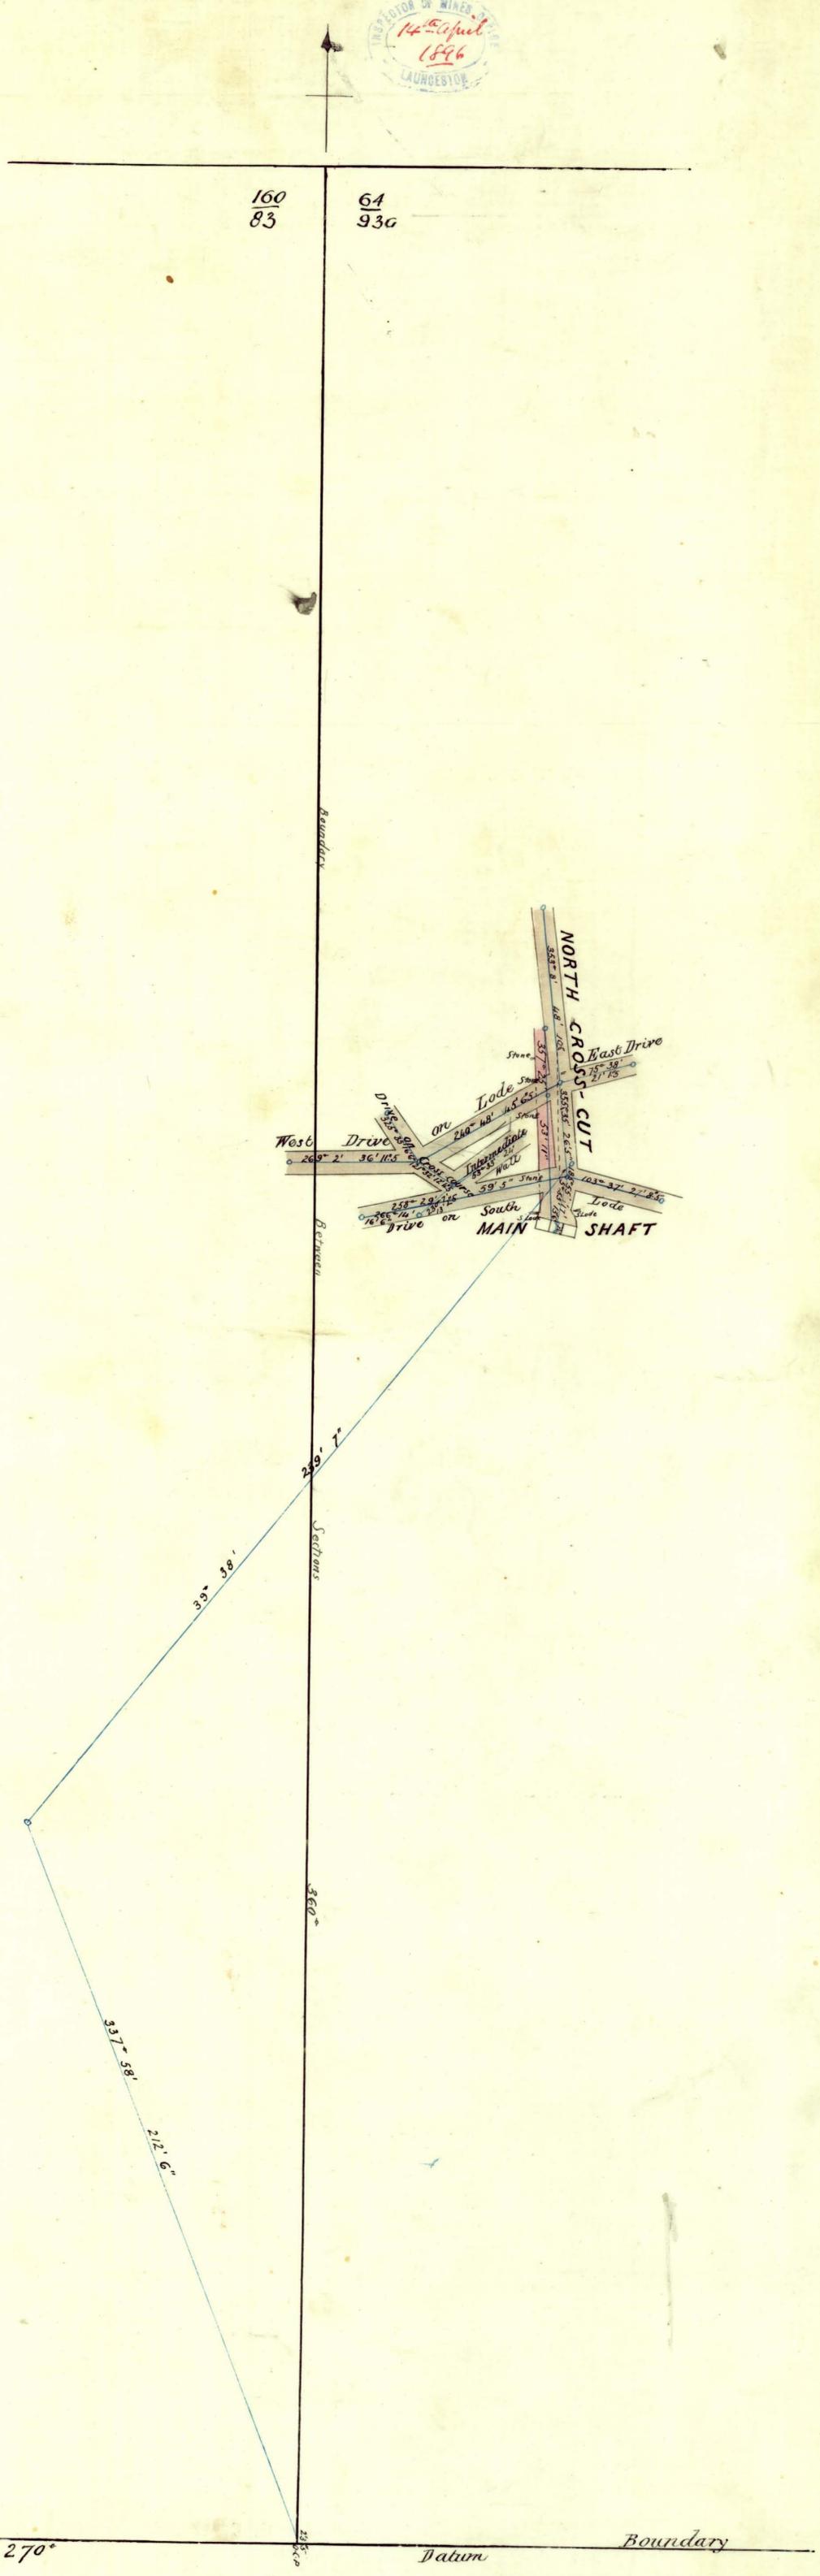

H. J. Miles  
 Surveyor  
 Lefroy  
 Year 96.