
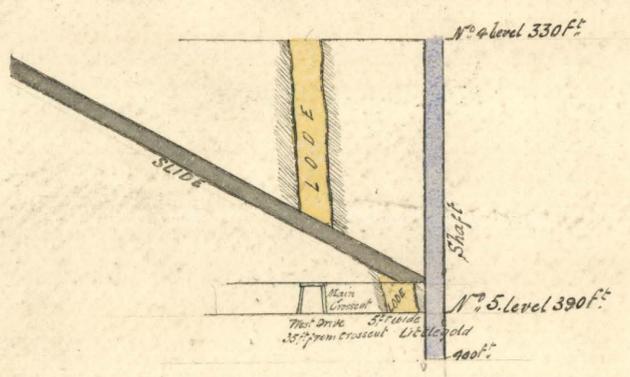
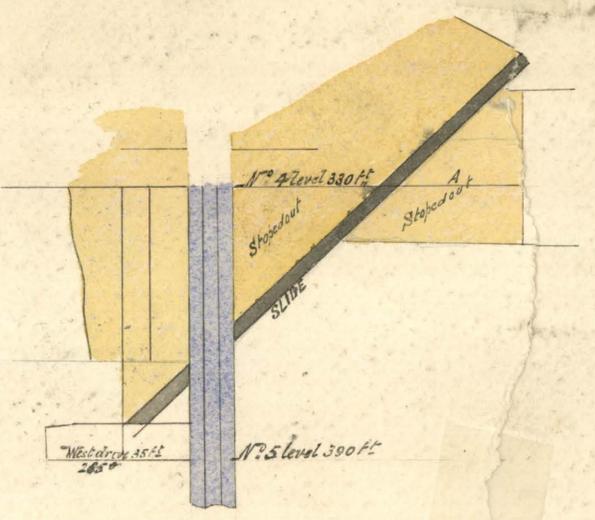
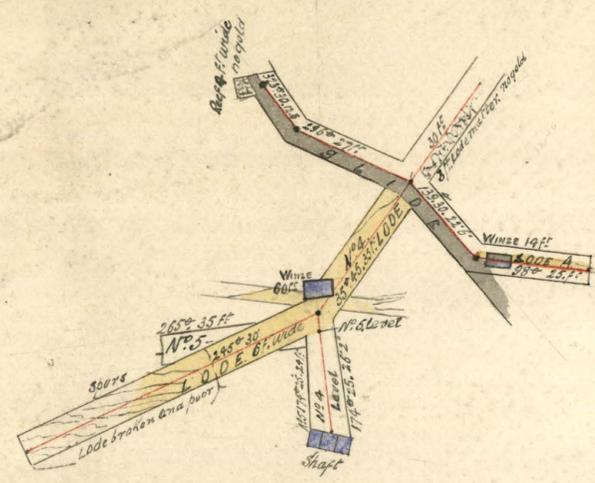


343
04

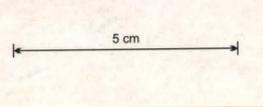

PLAN OF THE GOLDEN POINT & CROWN GOLD M^o C^o LEFROY

Scale 25 feet to 1. inch. 1.8.98

Alfred Jarrant Mining Manager