

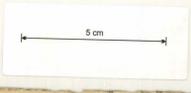


343  
05

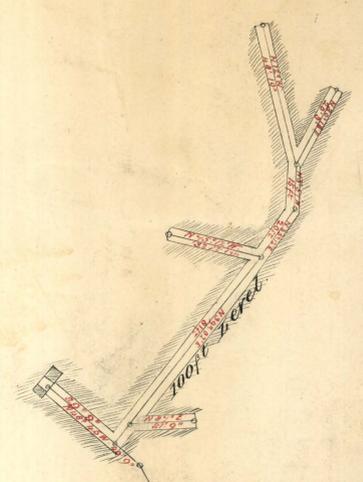

# NEW GOLDEN POINT G.M.

Scale 25 feet to an inch.

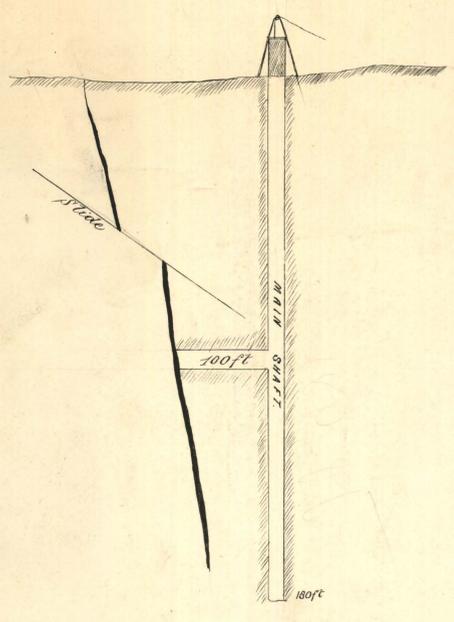


GROUND

PLAN

DATUM

## LONGITUDINAL SECTION

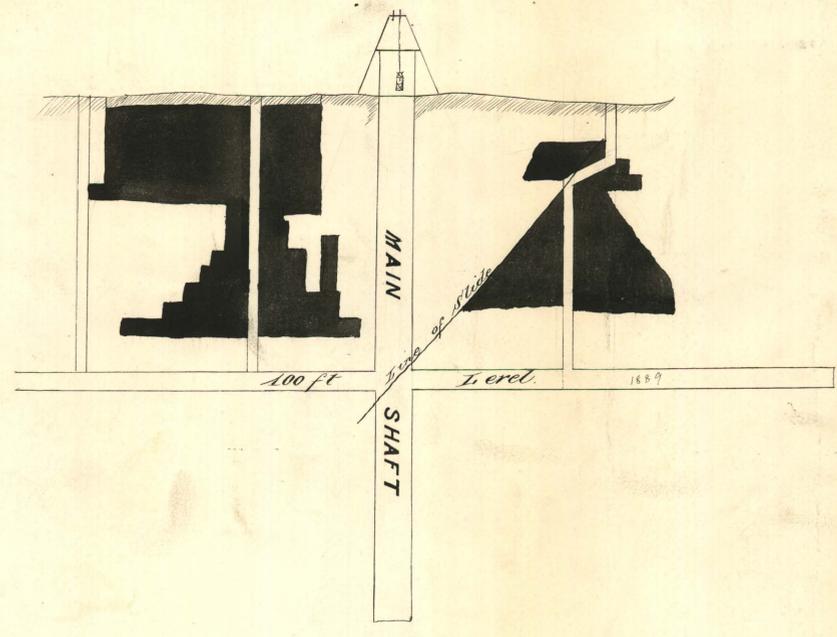

Board had correct copy of work  
done during the year 1889.  
C. B. [Signature]  
[Signature]

343