



344
-12

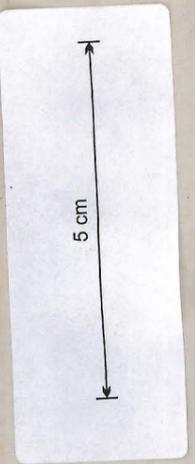

NORTH SECTIONS

PLAN

Scale 100ft to one inch

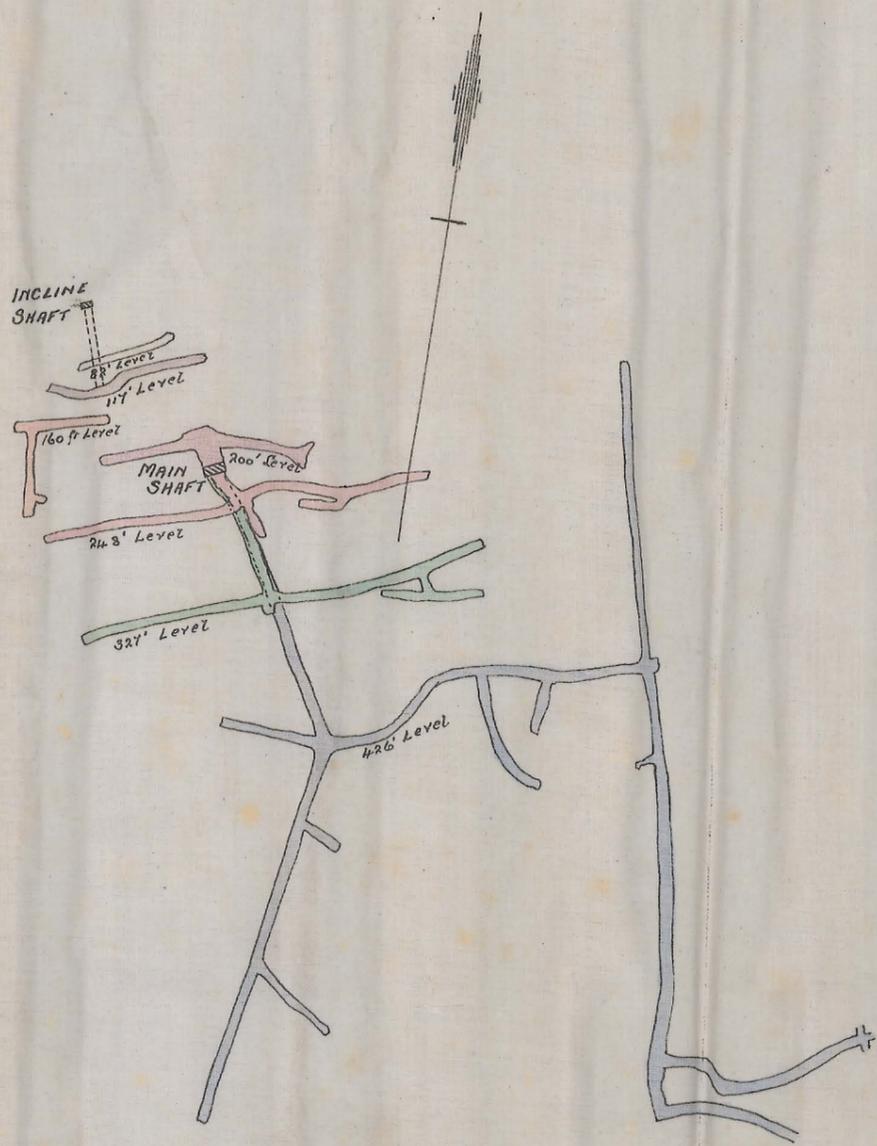

Office Copy

P 32