


THE TASMANIA GOLD MINING CO. LTD.

Showing Progress for each Financial Year from Commencement 4th June 1903

The Stoping is from 30th June 1903

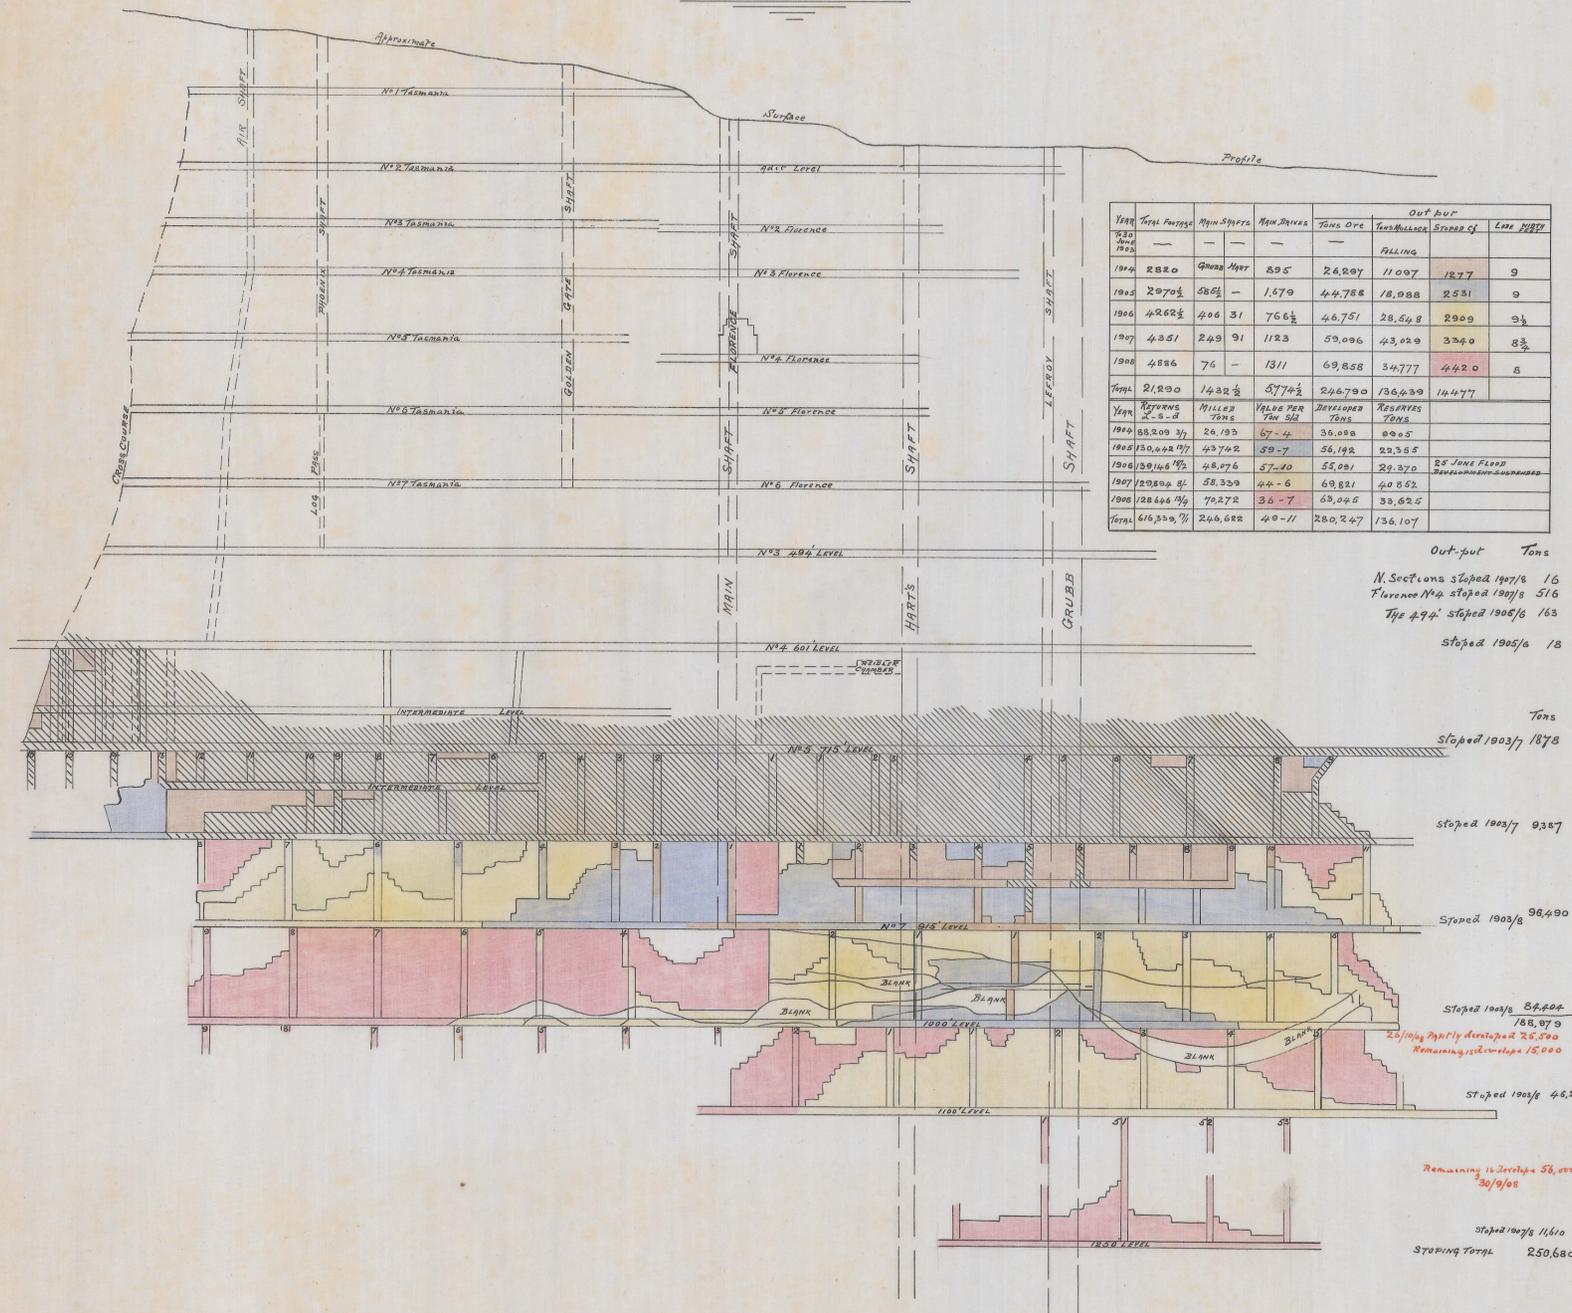

Out-put Tons
 N. Sections stoped 1907/8 16
 Florence N.4 stoped 1907/8 516
 The 494' stoped 1905/6 163
 Stoped 1905/6 13

Tons
 Stoped 1903/7 1878
 stoped 1903/7 9387
 Stoped 1903/6 36,490
 Stoped 1903/6 84,202
 188,873 [up to 188,000 were
 Expected over the 1903/6
 24/10/03 fully developed 25,500
 Remaining is develop 15,000
 29/9/08
 Stoped 1903/6 46,201
 Remaining is develop 56,000
 30/9/08
 Stoped 1903/6 11610
 STOPPING TOTAL 250,680

in Stock 188 Tons Surface
 33457 - Mine
 Reserves 33,625 - fully developed
 + 36,500 To develop
 130,125 over the 1250

Scale - 100 FEET ONE inch.

Brought up to December (in Mining Report) 1908
 Projected Work for year ending 30 Sept 190 in broken lines
 10
 Jan 00



344
-13

344
-13