


THE TASMANIA GOLD MINING CO., LTD.

SCALE 100 FT TO 1 INCH

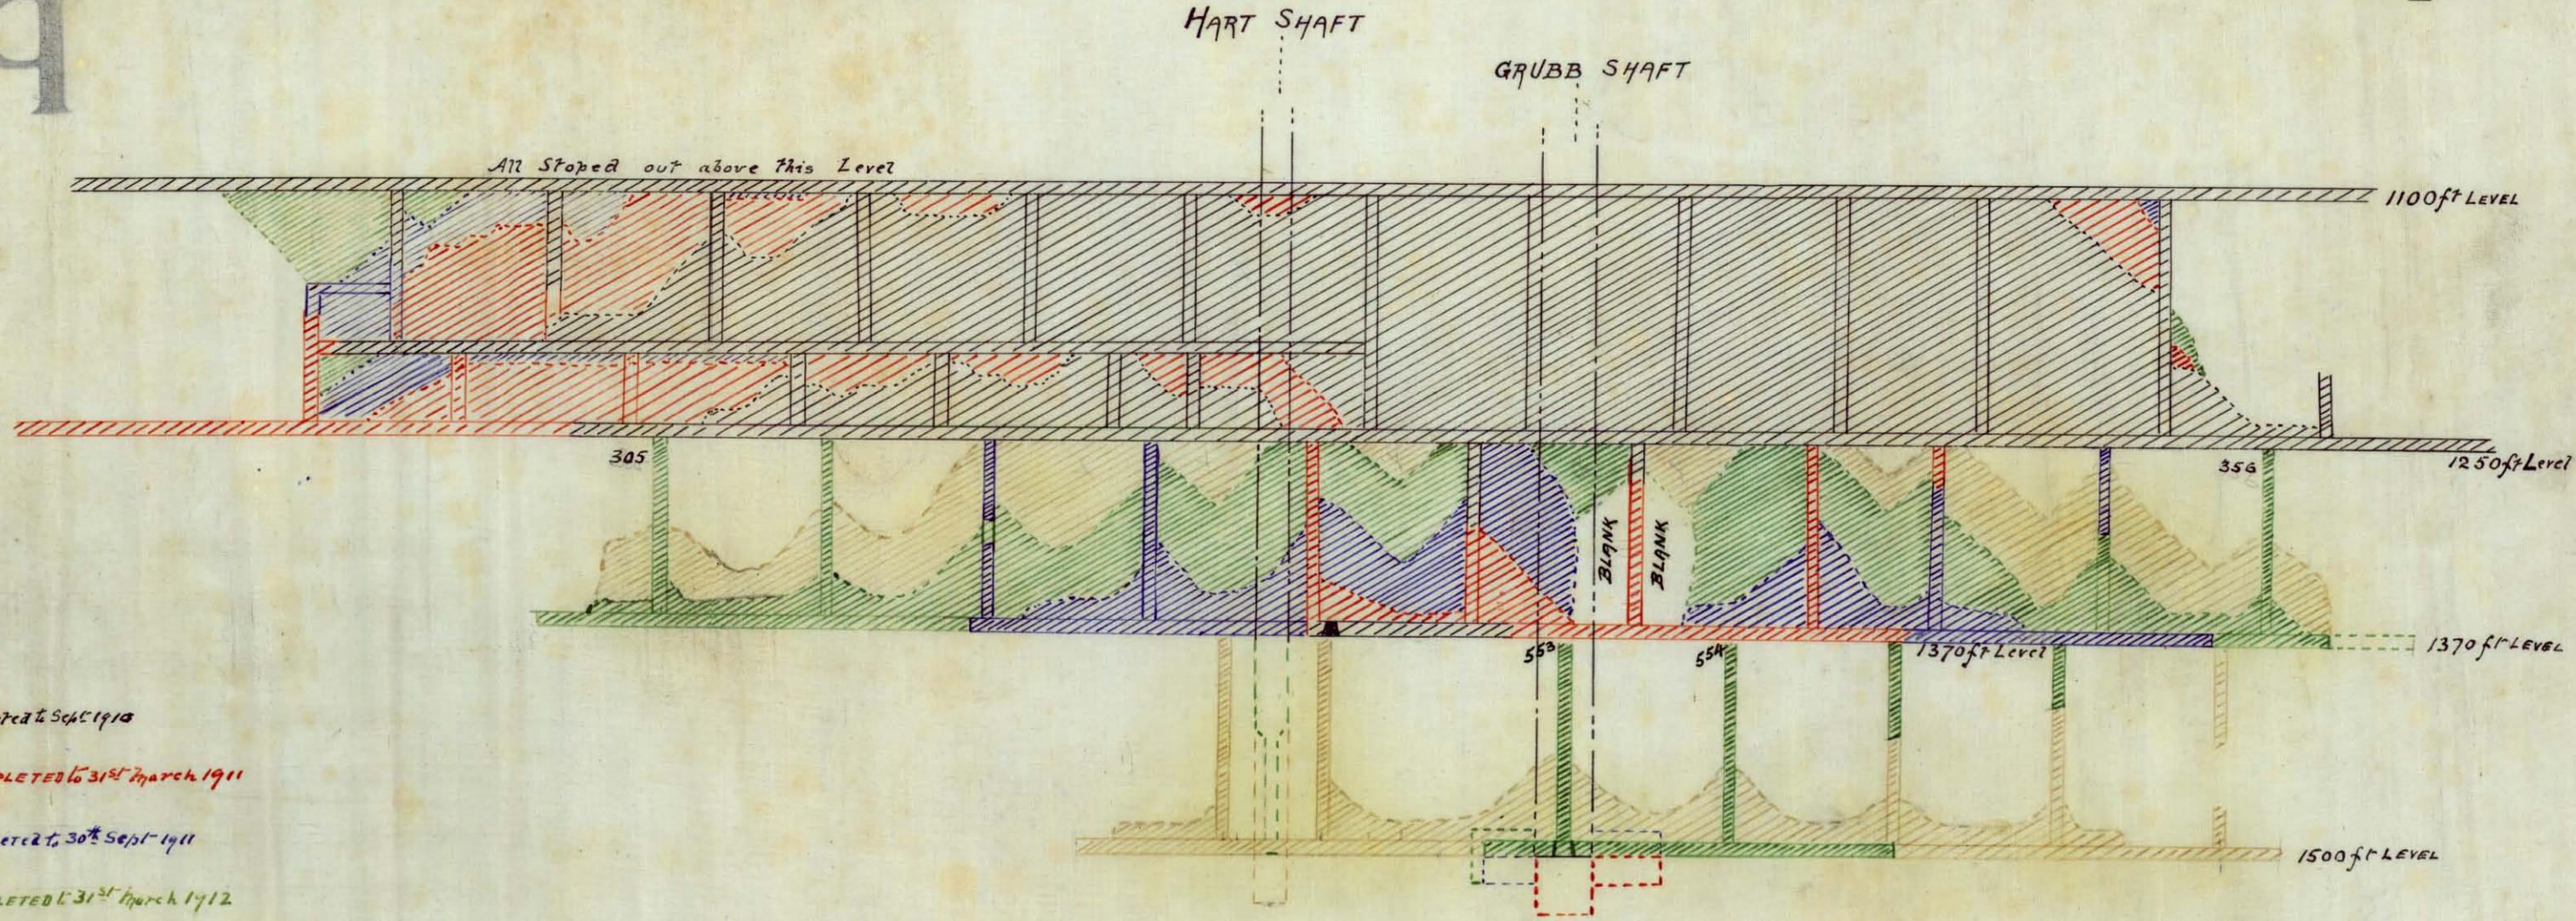

-  WORK COMPLETED to Sept 1910
-  WORK COMPLETED to 31<sup>st</sup> March 1911
-  WORK COMPLETED to 30<sup>th</sup> Sept 1911
-  WORK COMPLETED to 31<sup>st</sup> March 1912
-  WORK COMPLETED to 30<sup>th</sup> Sept 1912

NOTE:- DOTTED LINES Shafts + Pump Chambers

C. F. Heathcote *Supr*  
Beaconsfield Tasmania 24<sup>th</sup> JUNE 1911