
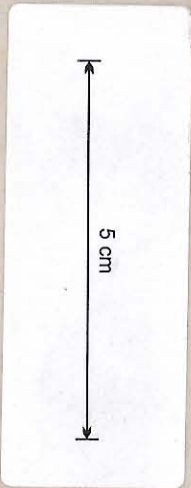


344-29

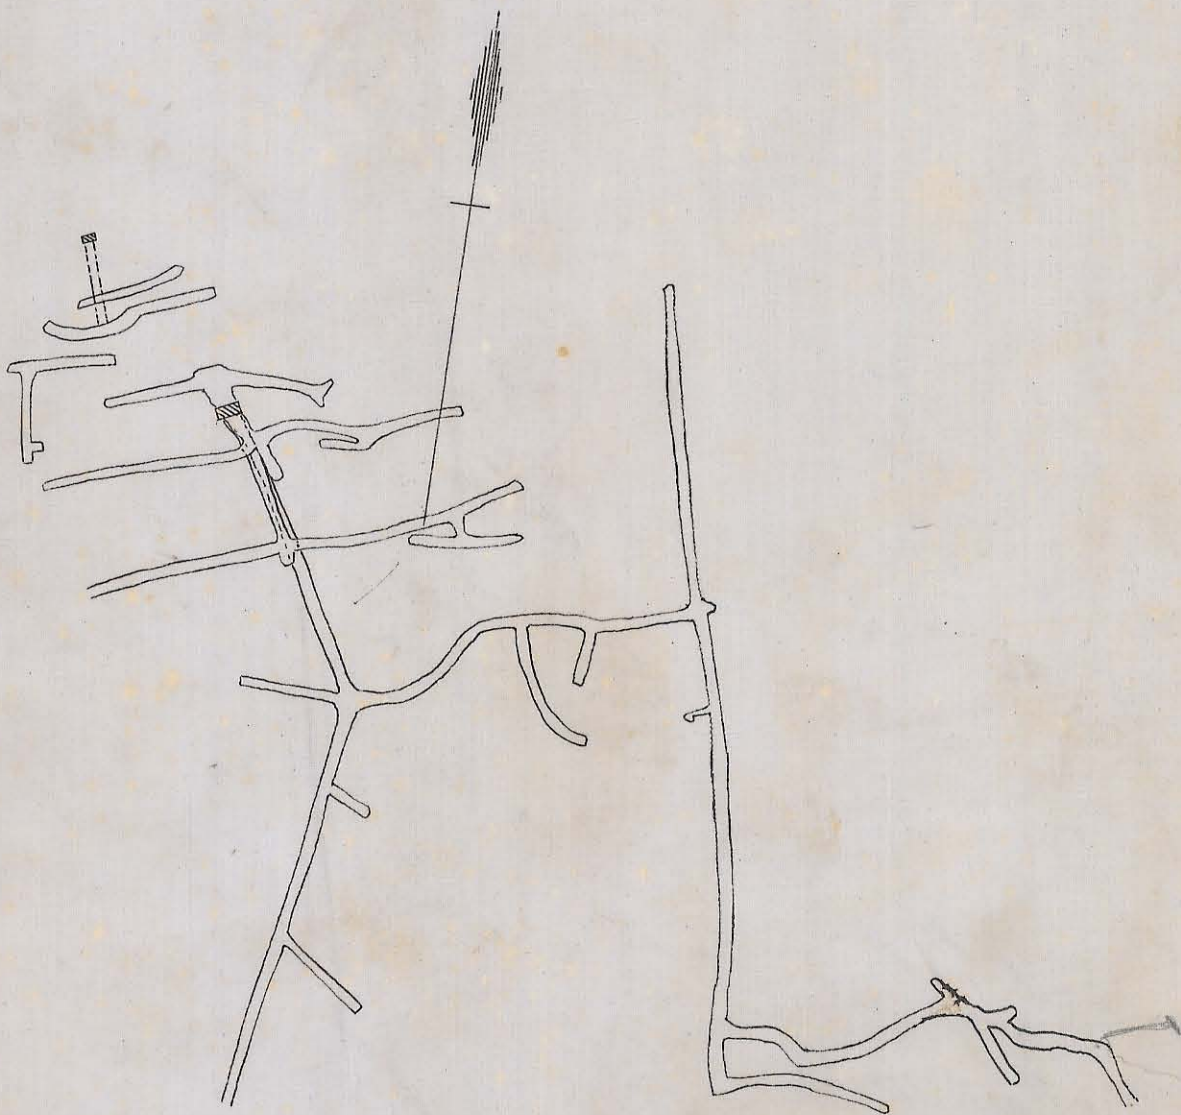

P 32

344-29