



5 cm


VERTICAL SECTION
OF MAIN SHAFT
(LOOKING NORTH WEST)
Showing cross cuts to reef

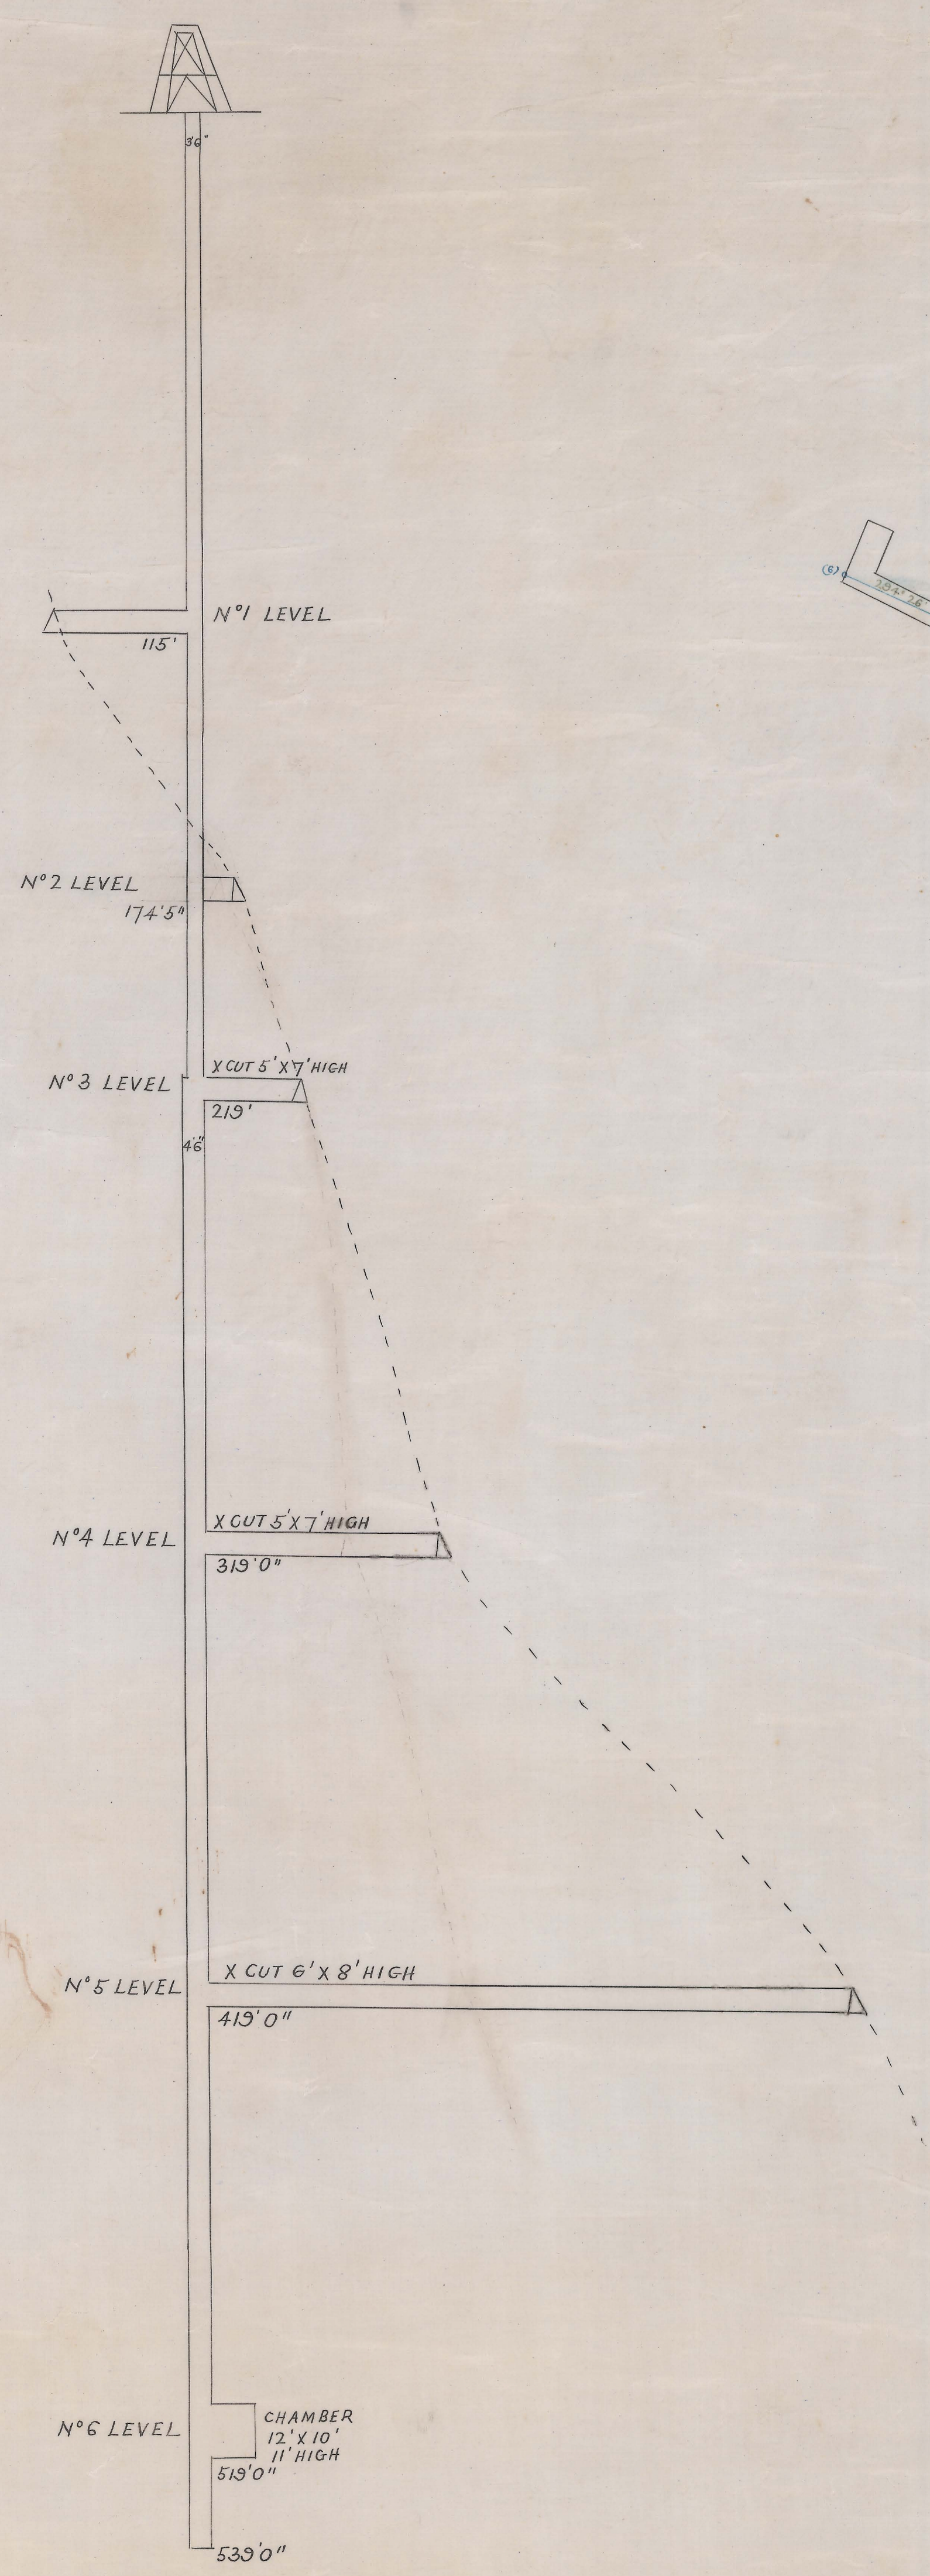


N°1 LEVEL

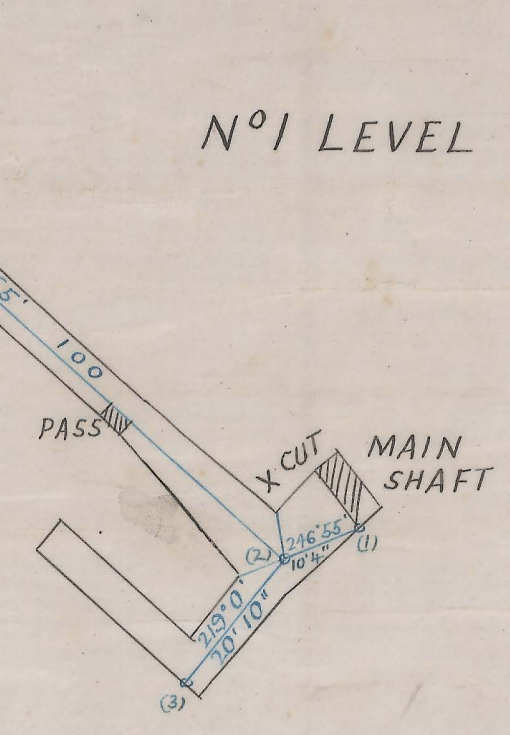


N°2 LEVEL

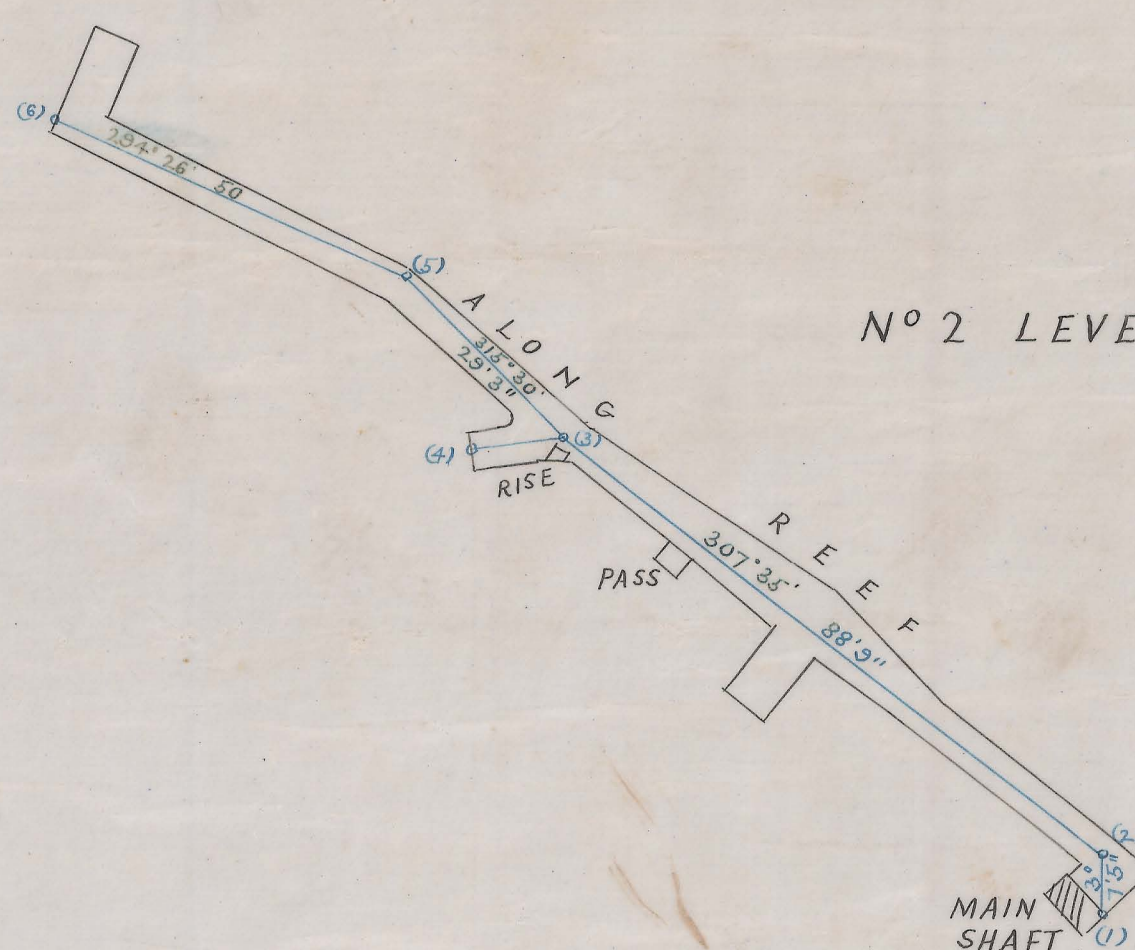


N°3 LEVEL

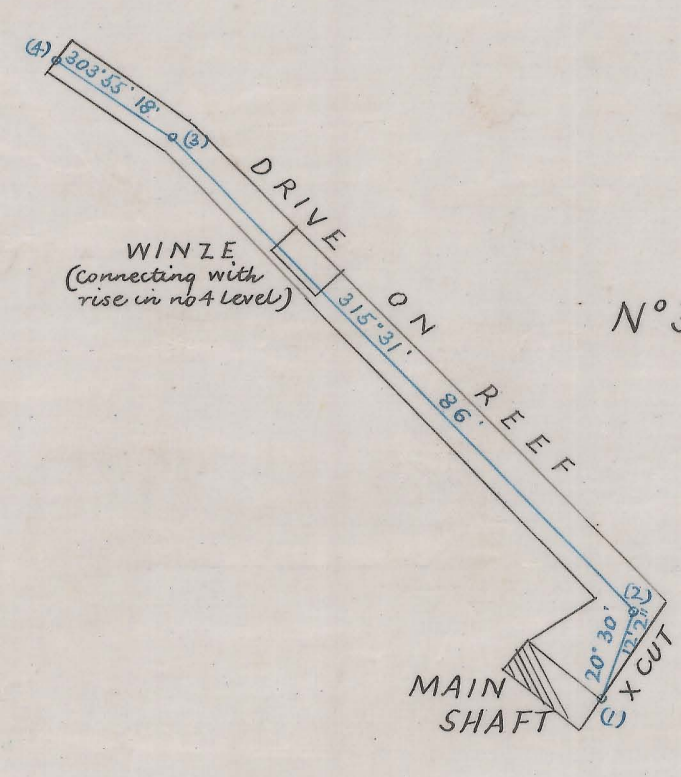


N°4 LEVEL

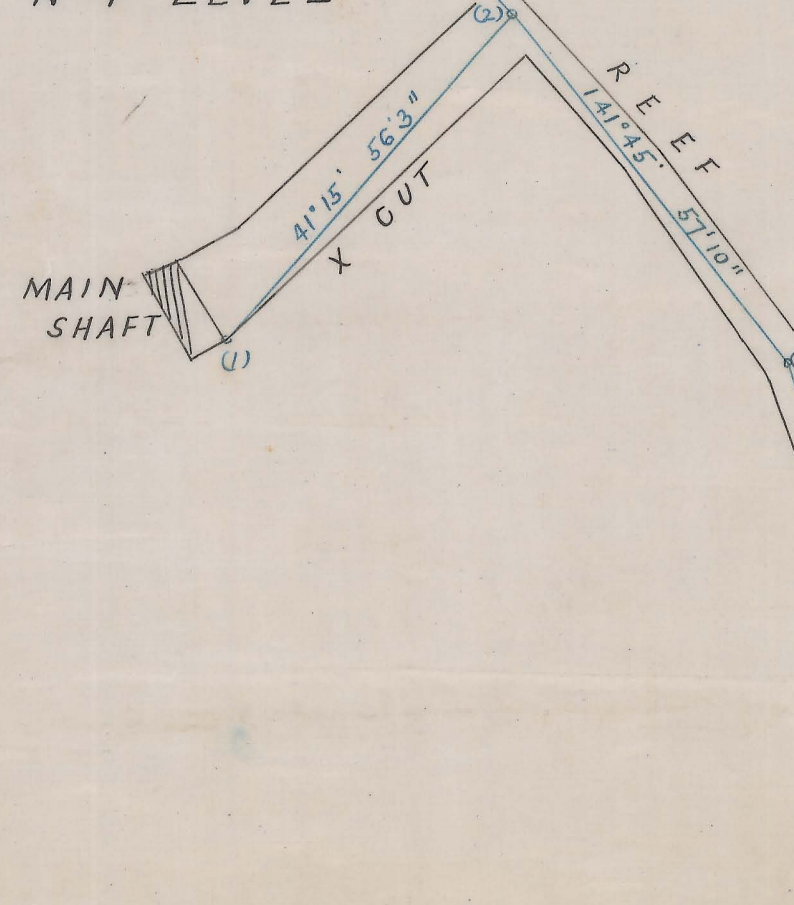

N°5 LEVEL

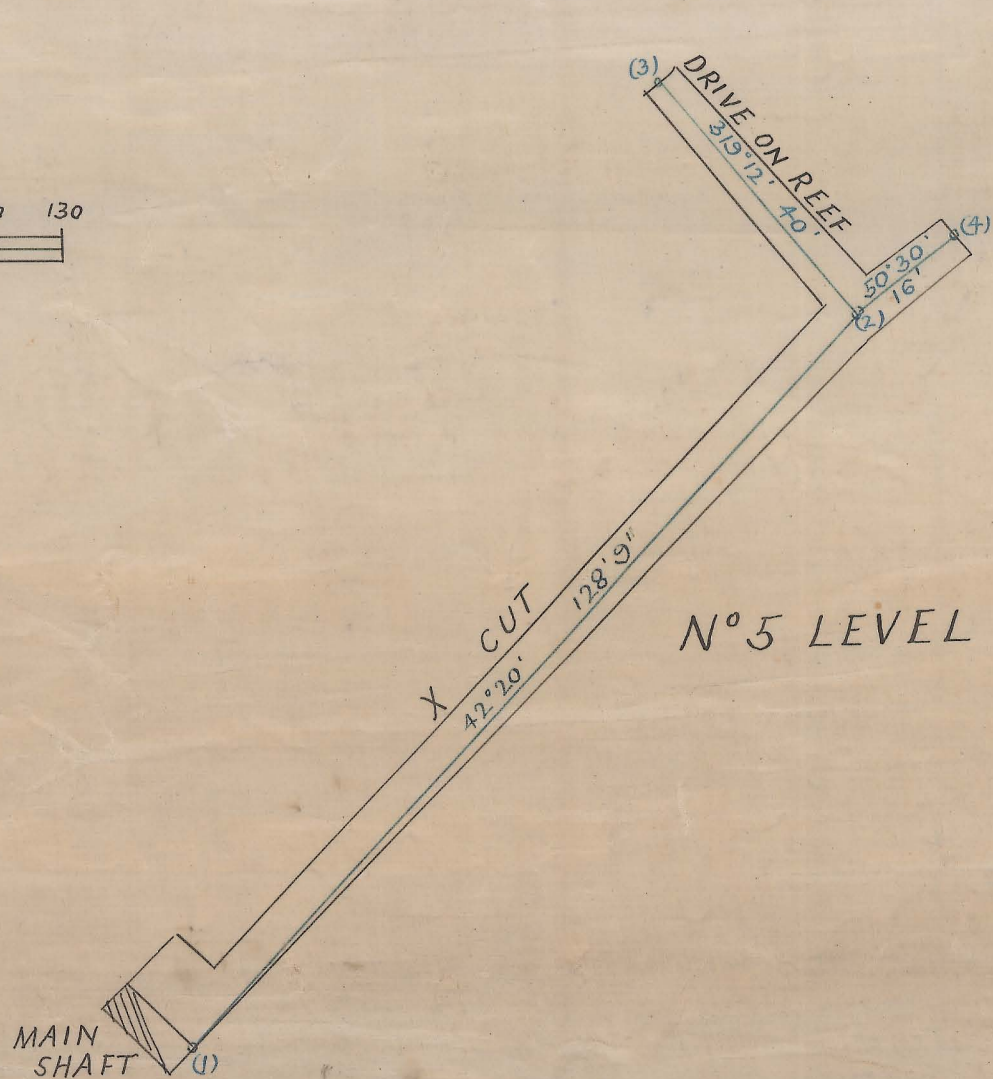



VERTICAL SECTION
OF MAIN SHAFT
(LOOKING NORTH EAST)
showing drives along reef

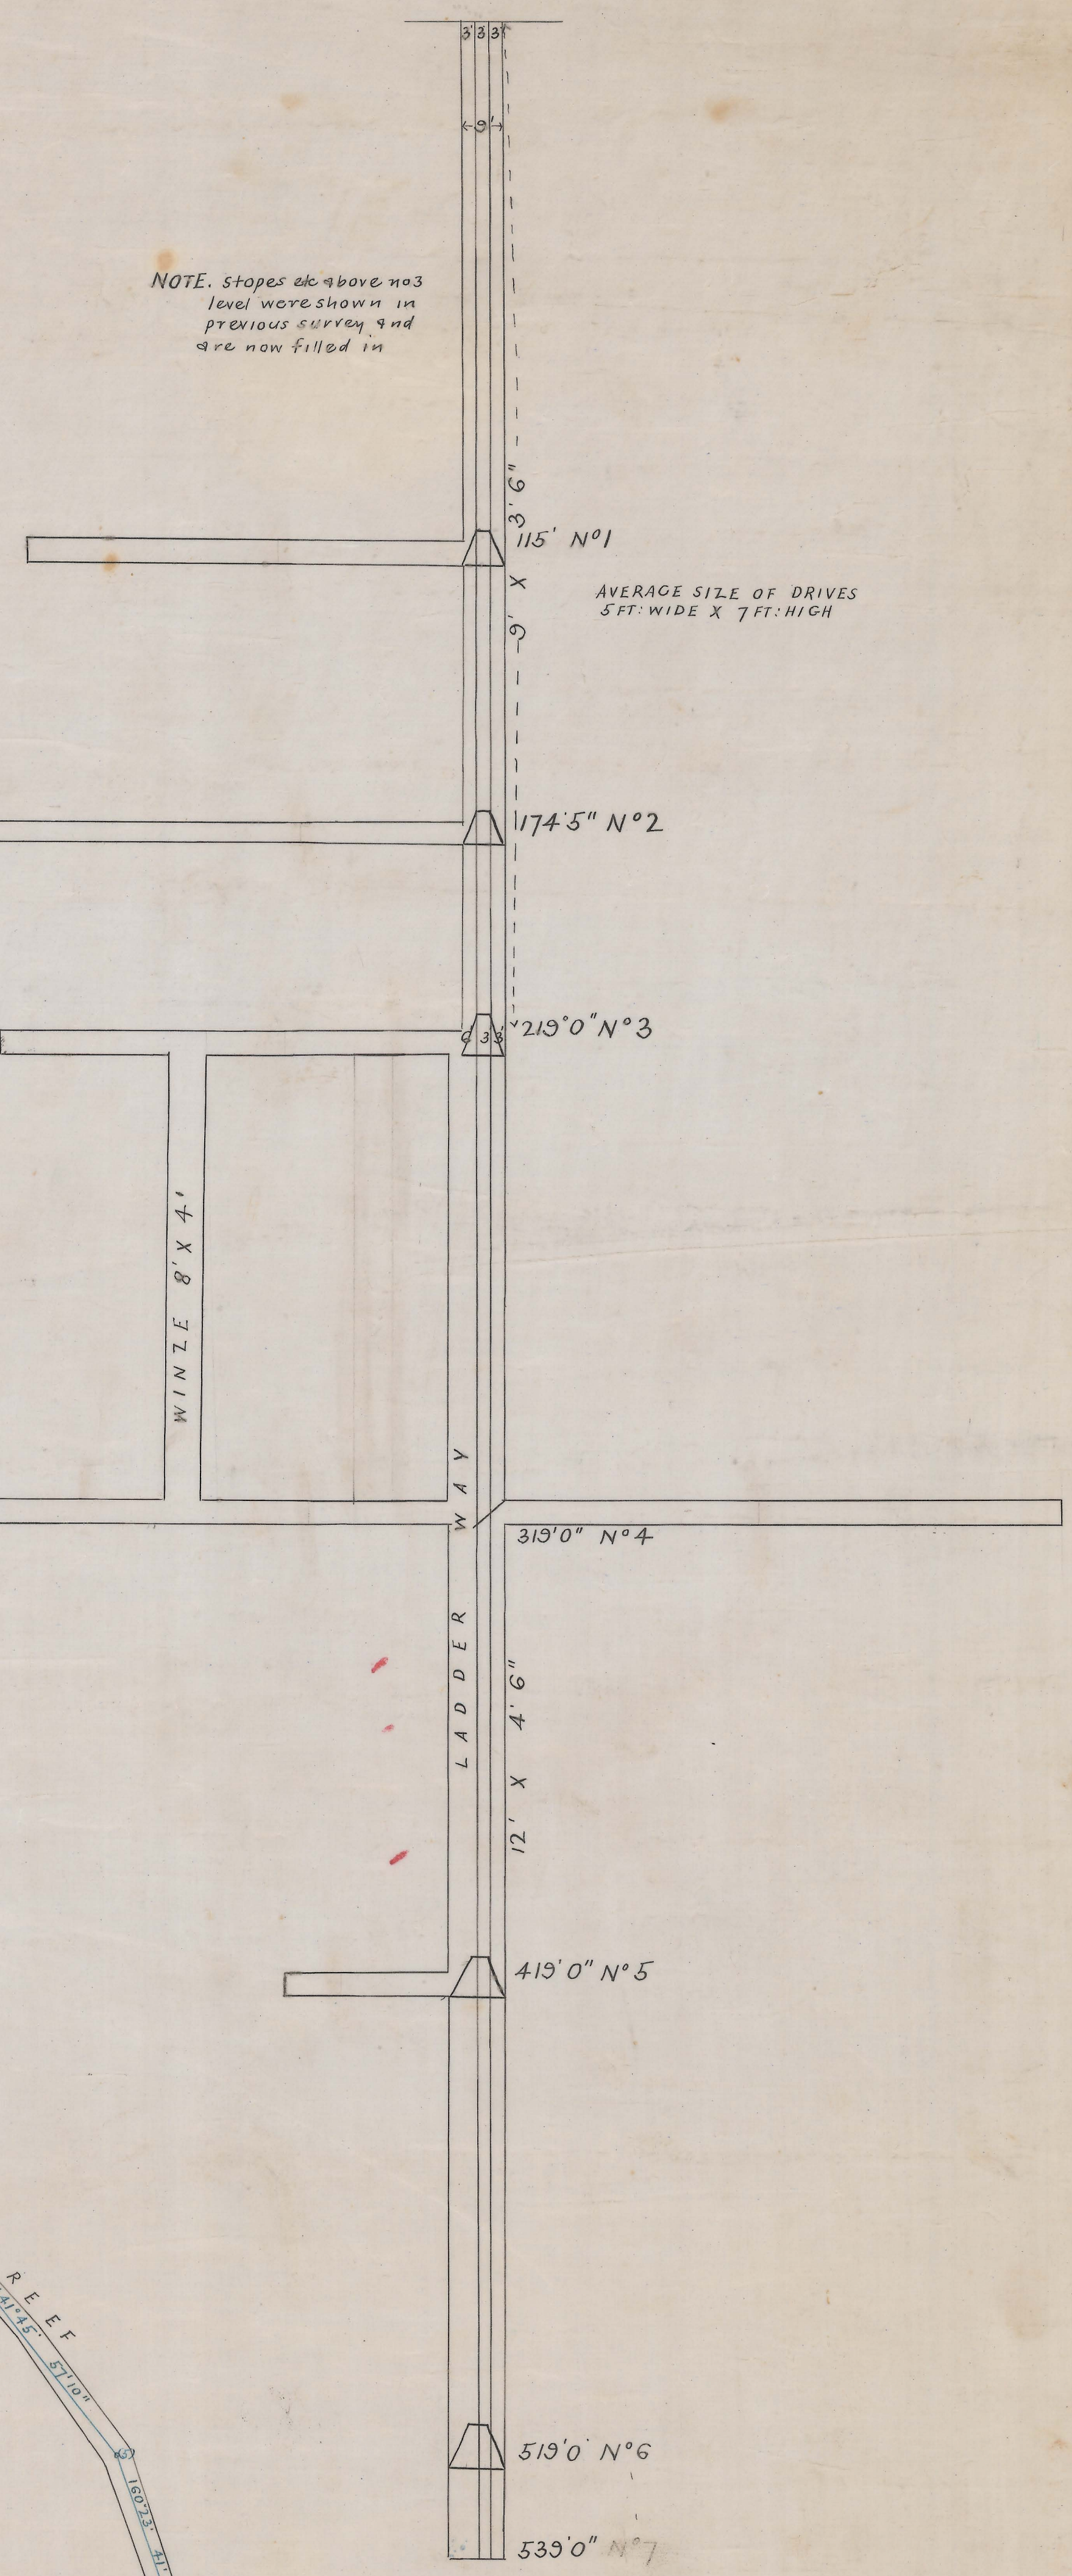

NOTE, slopes above N°3 level were shown in previous survey and are now filled in

AVERAGE SIZE OF DRIVES 5 FT. WIDE X 7 FT. HIGH

MANGANA (TASMANIA)
GOLD REEFS CO. LIM:

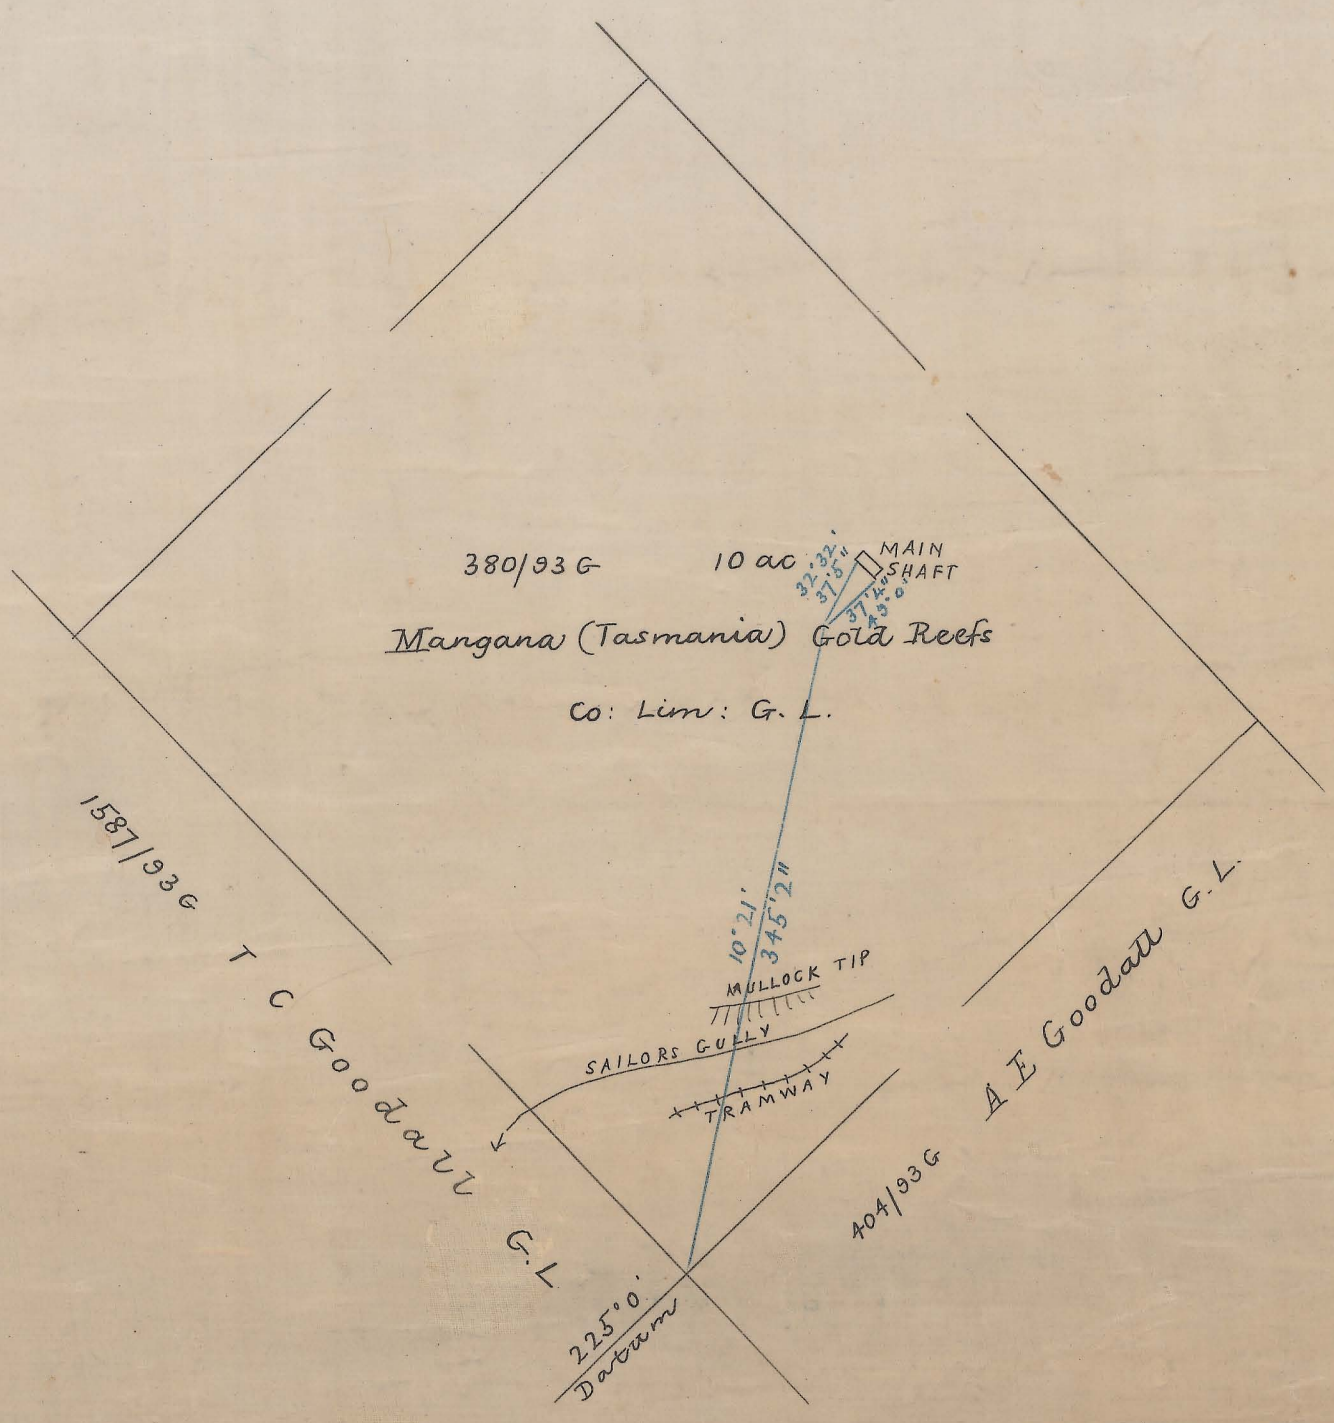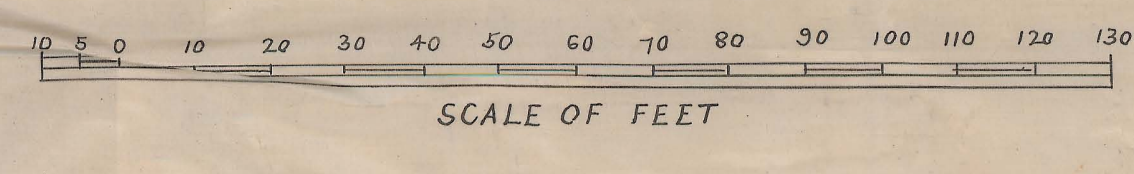

Campbell Smith
Authorised Surveyor
January 1901

