


349

02

5 cm

BRISEIS TIN MINES LTD.

Underground Workings
No 3 Tunnel
March 09.

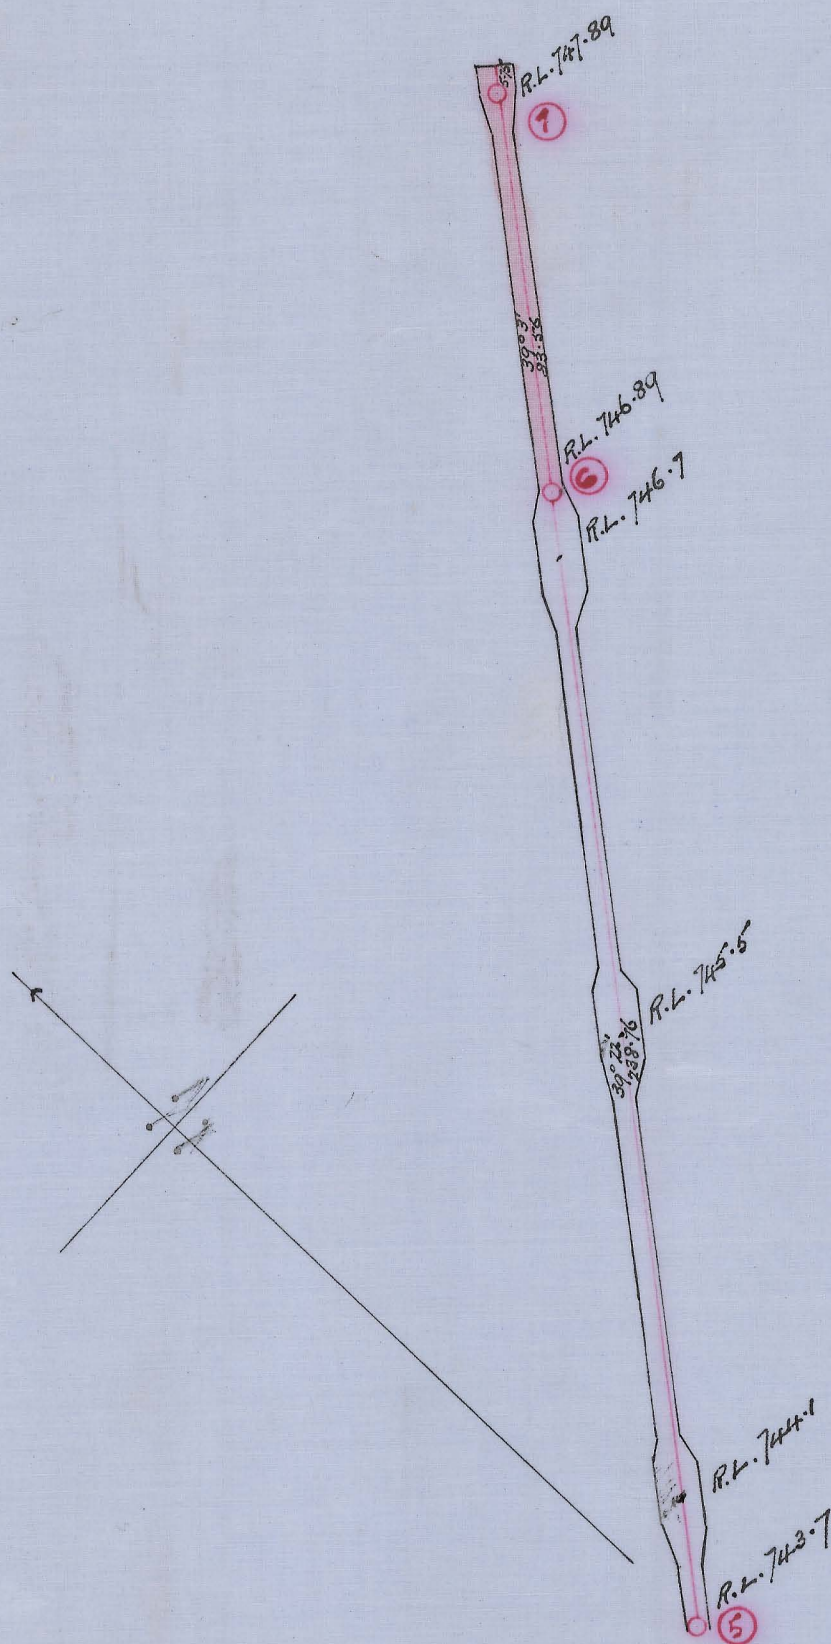

J. S. Jones
2/10/08

See plan sent March 08
J. S. Jones