


349
03

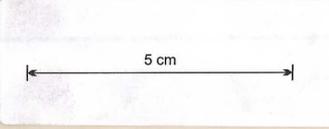

THE BRISEIS T.M.C. NO LIABILITY



PLAN

OF UNDERGROUND WORKINGS

SHEWING EXTENSION DURING 1893 - COLOURED RED -

SCALE 40 LINKS = 1 INCH

W. Morrison
Mine Manager
30/1/94

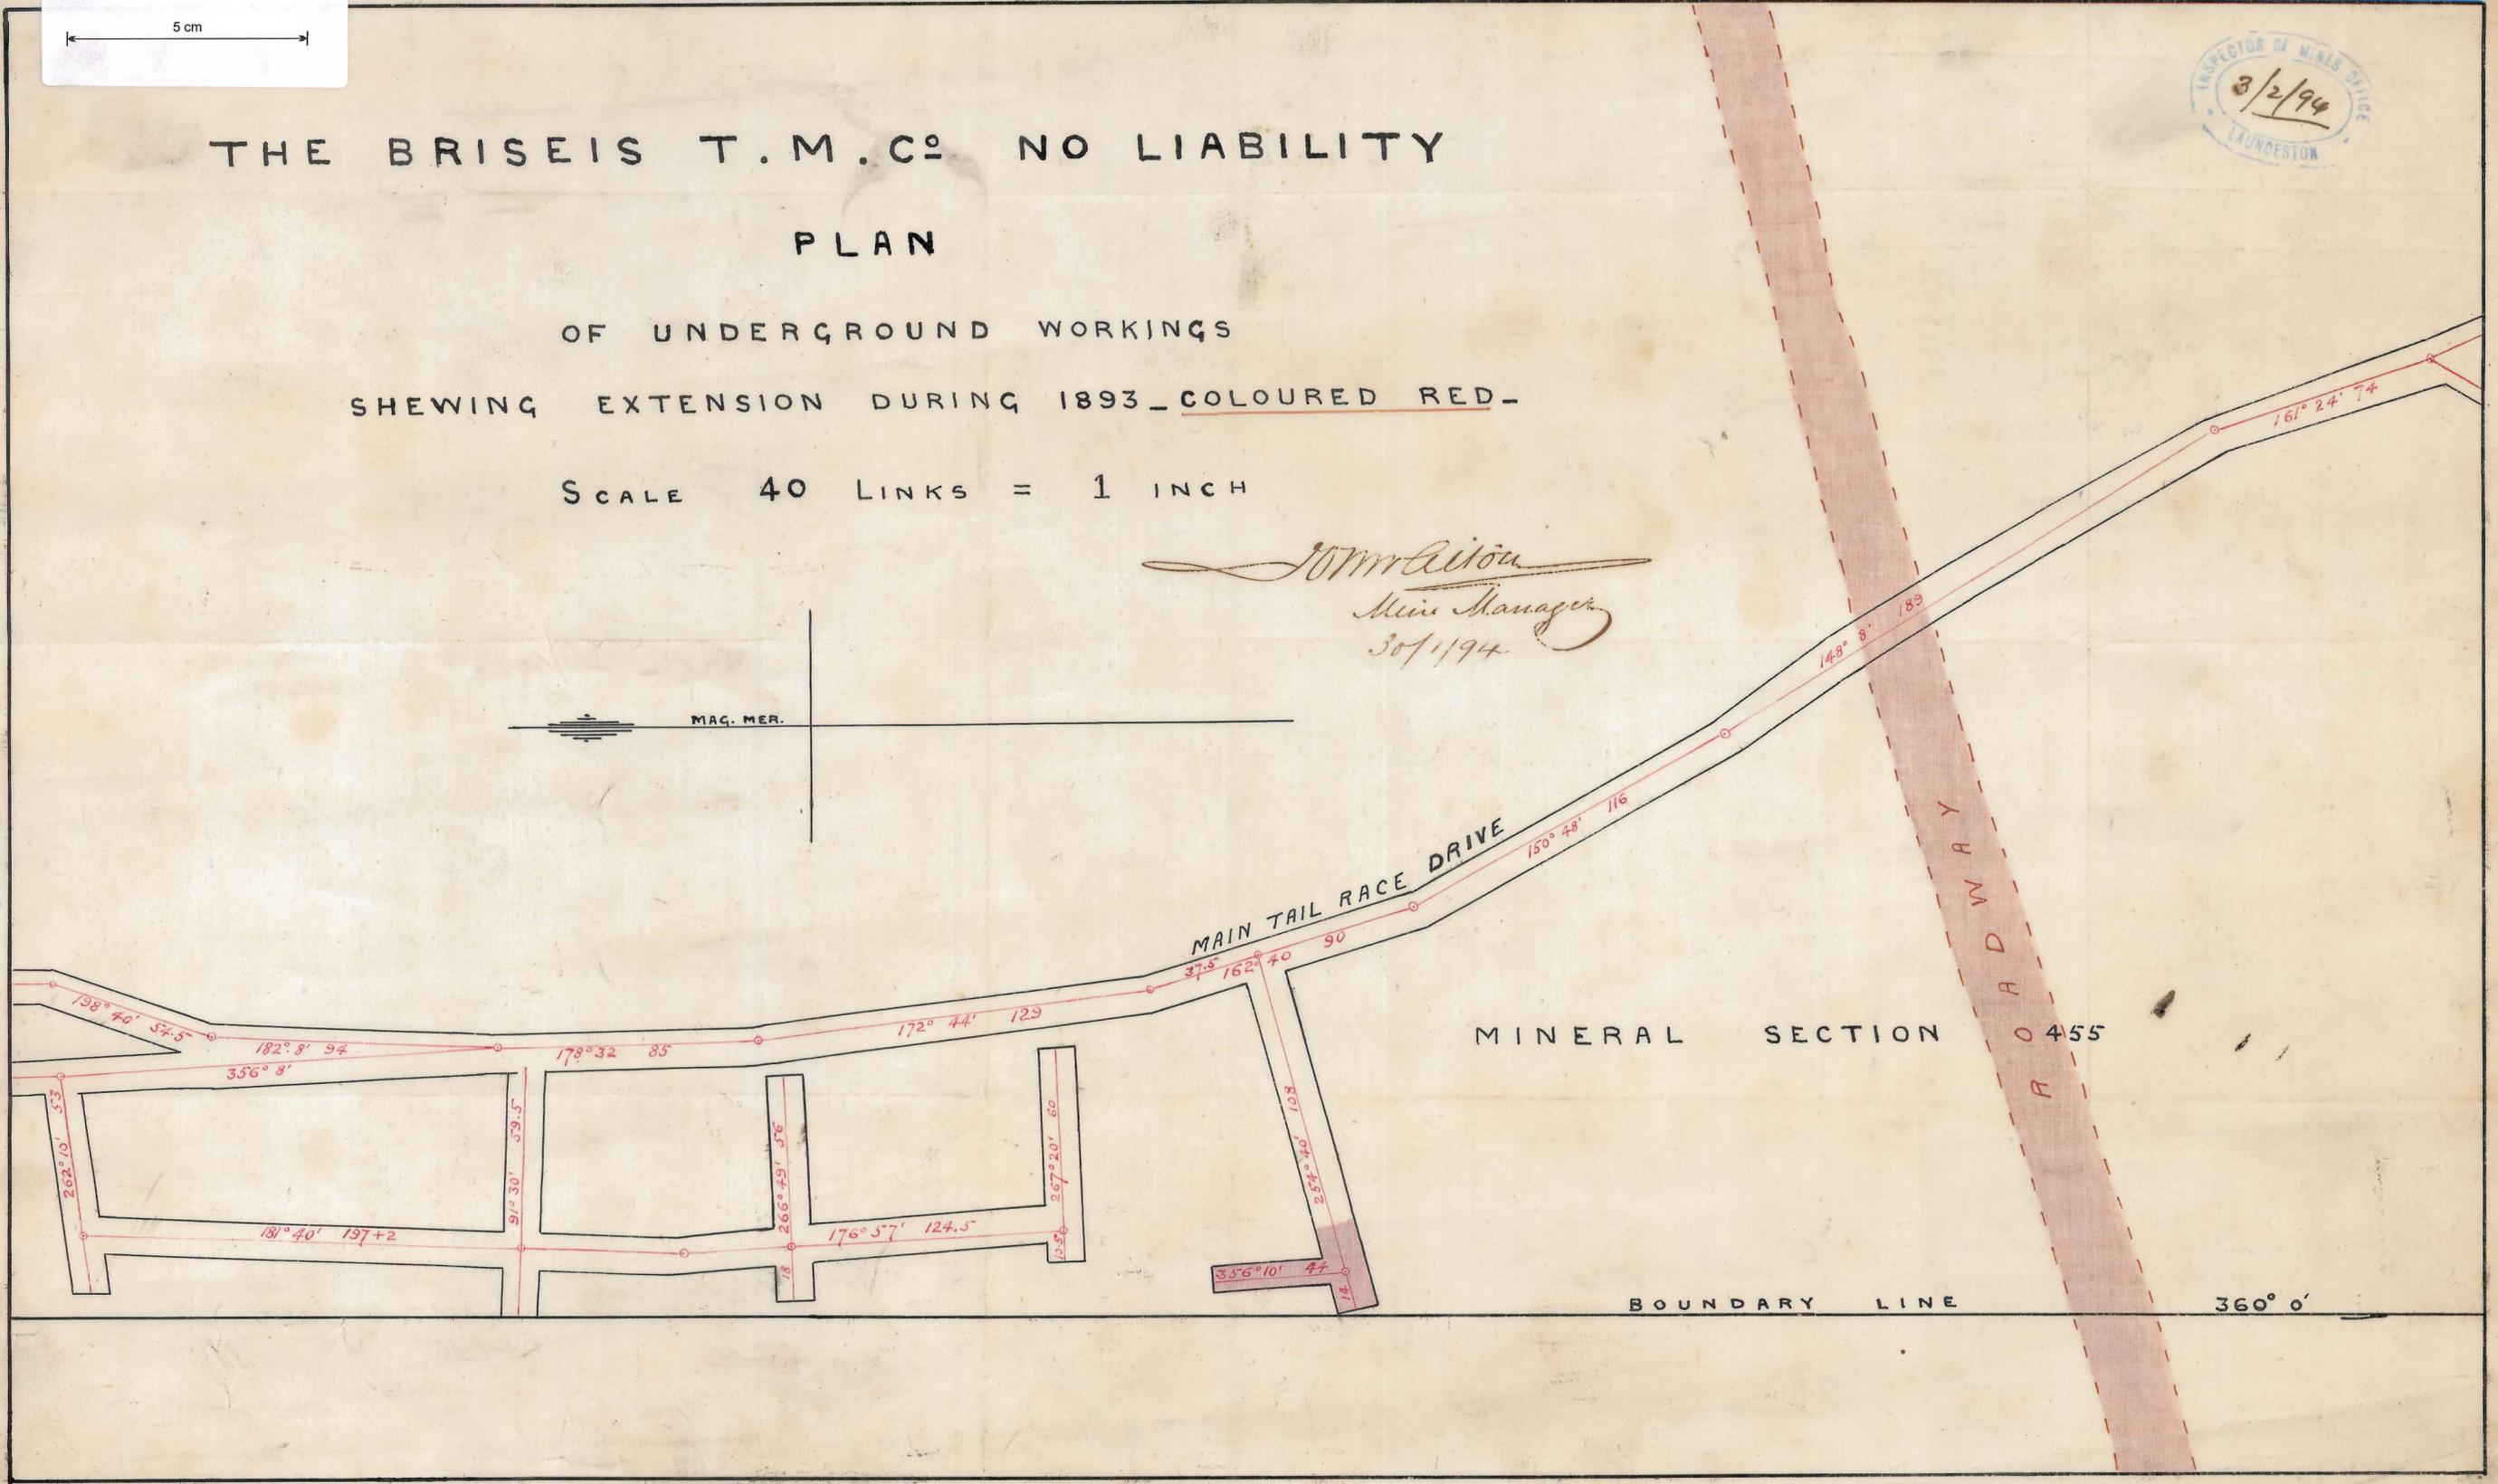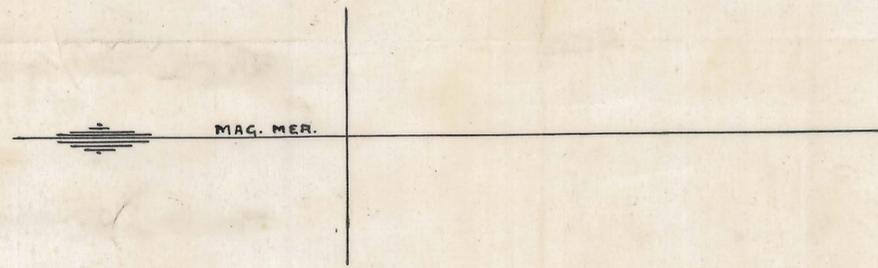

3/2/94