

A P
242 0 0

Thomas Beswick

Pur:

5303
93M
Briseis Tin Mines Limited
M. L.

94AC:

THE BRISEIS TIN MINES LTD

— PLAN —


— SHOWING UNDERGROUND WORKINGS —

— TO END OF MARCH '08 —

— SCALE: 40 FT = 1 IN. —

J. H. W. J. W.
15/4/08

5" Transit theodolite used

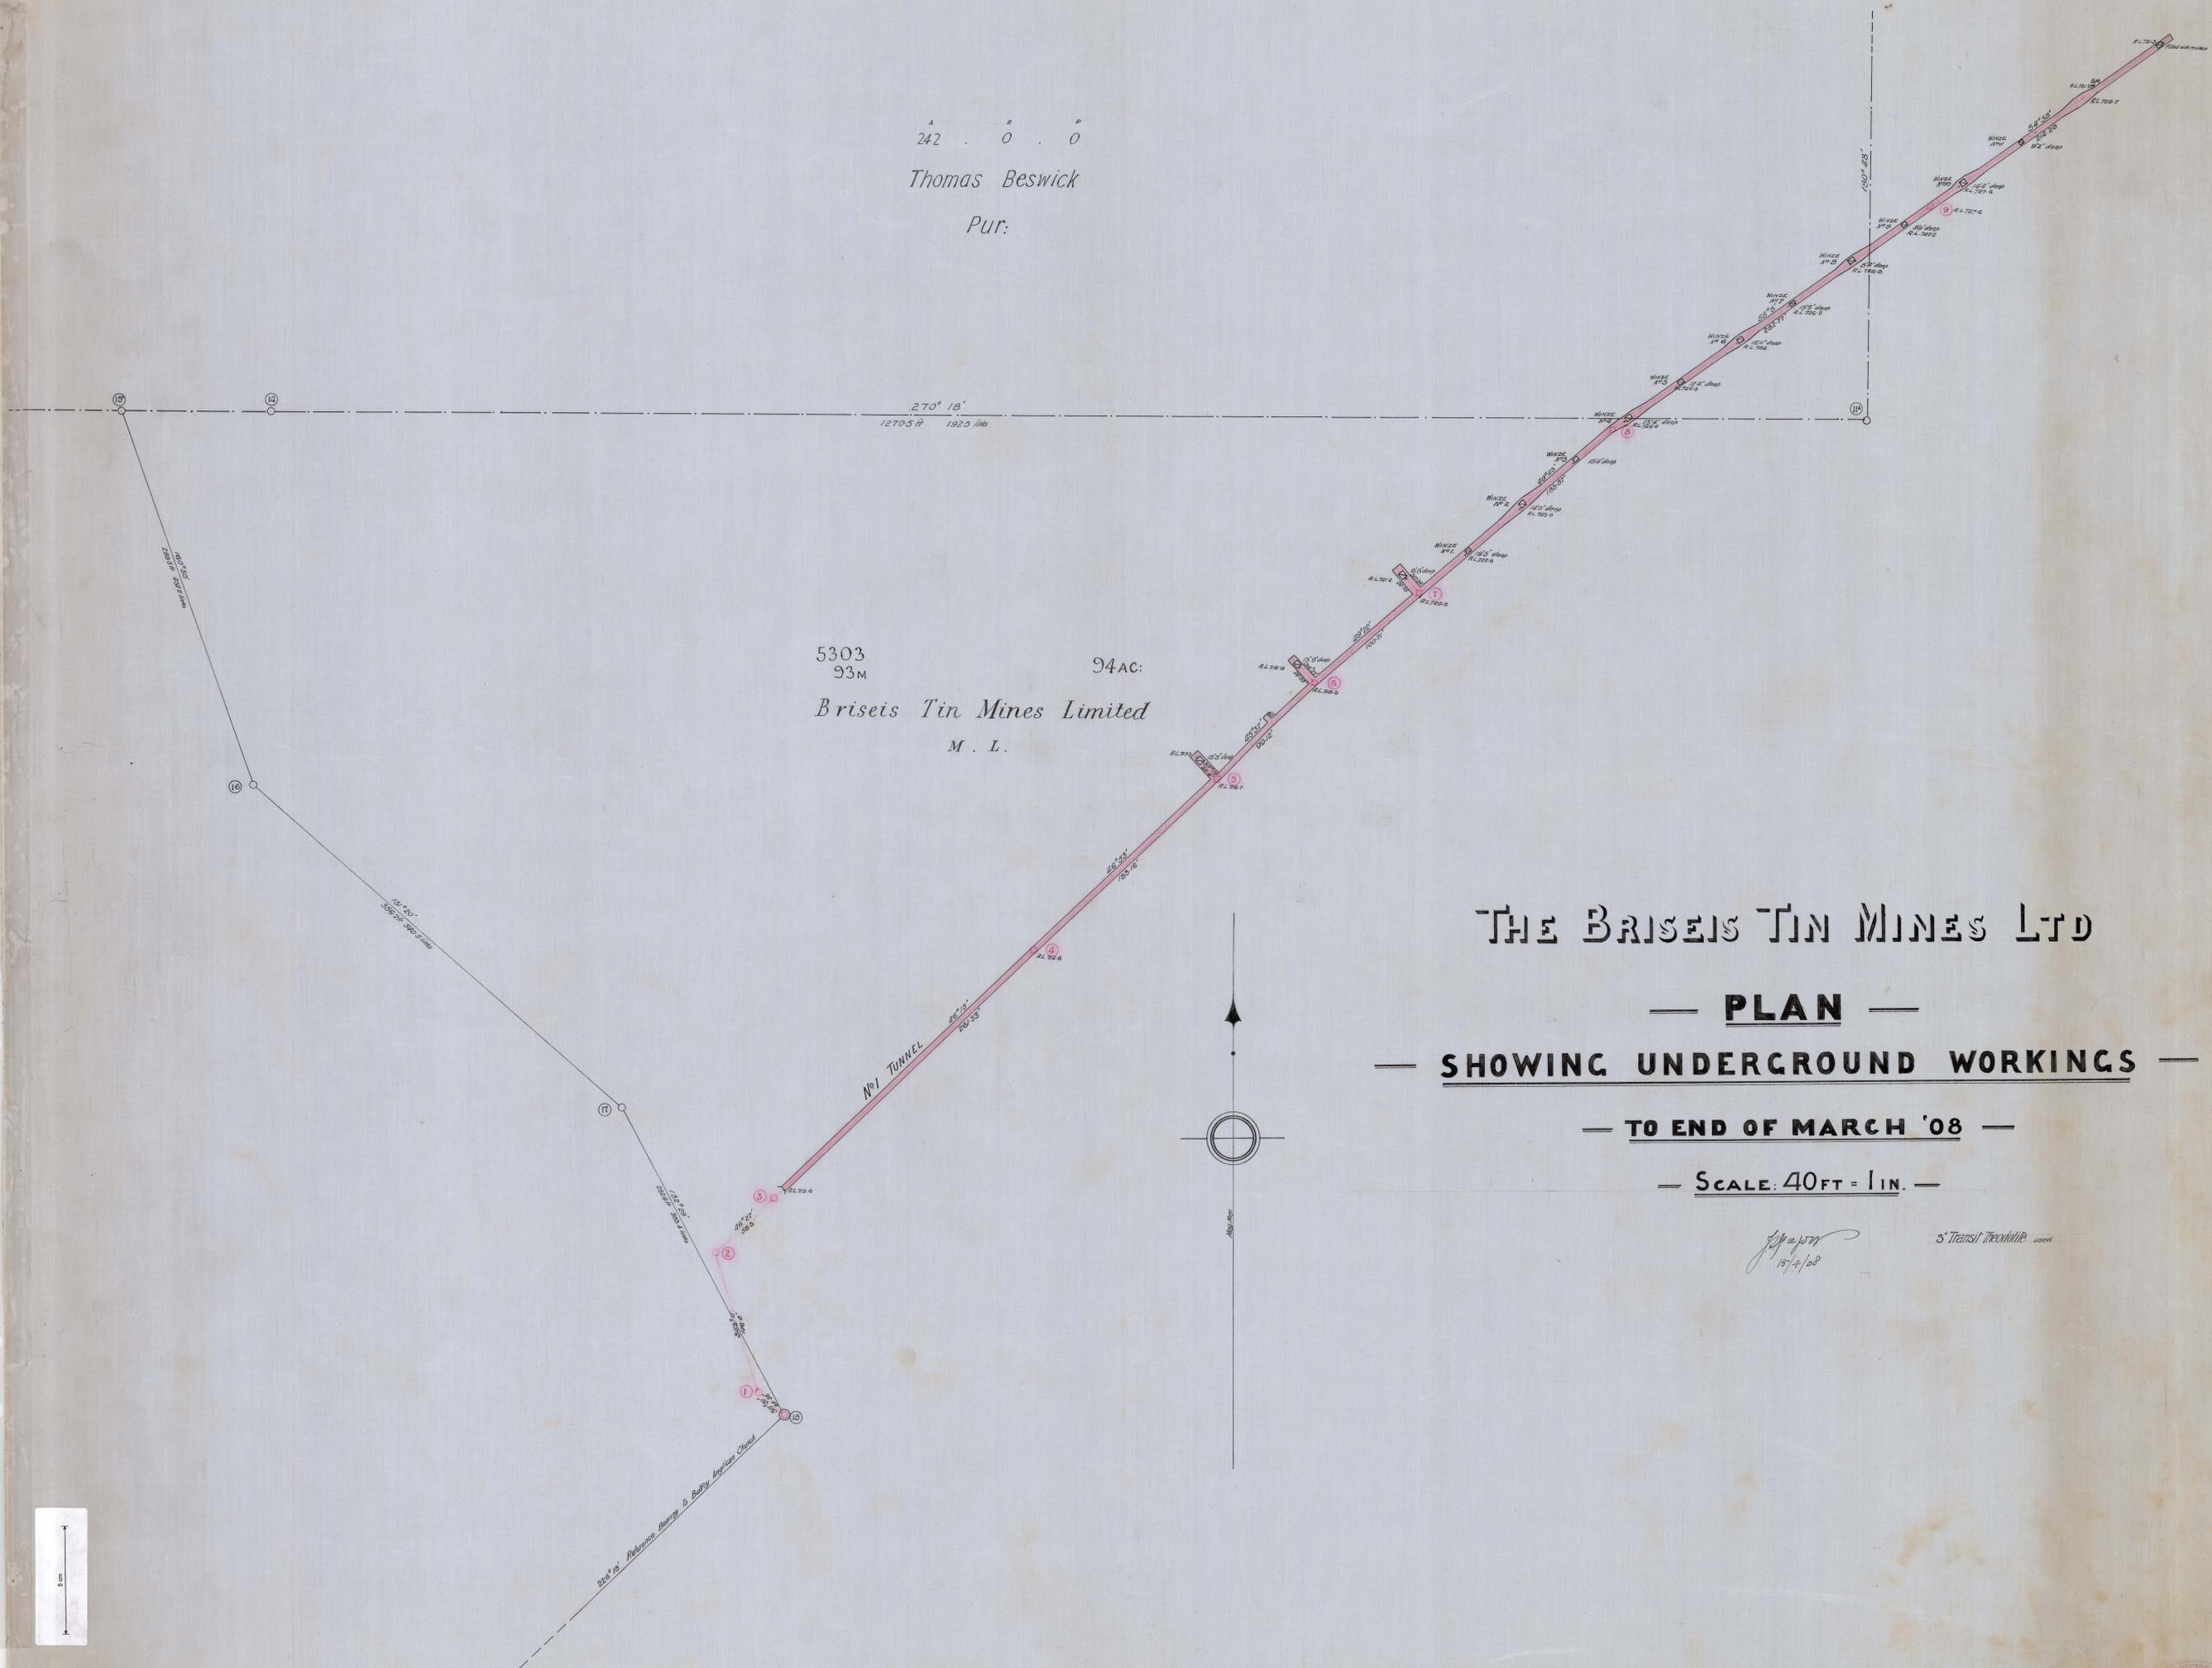

549
05

50m