


349
OK

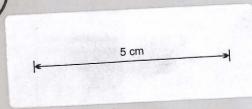

THE BRISEIS TIN MINES LTD

PROJECTION ON EAST & WEST PLANE.


Shewing Underground Workings for the Year 1903.

Scale. - 1 Inch = 25 Feet.

Hudsony Blair & Son, Min.



NEW BROTHERS' HOME NO. 1 TIN MINING CO. N.L.
Boundary 360'

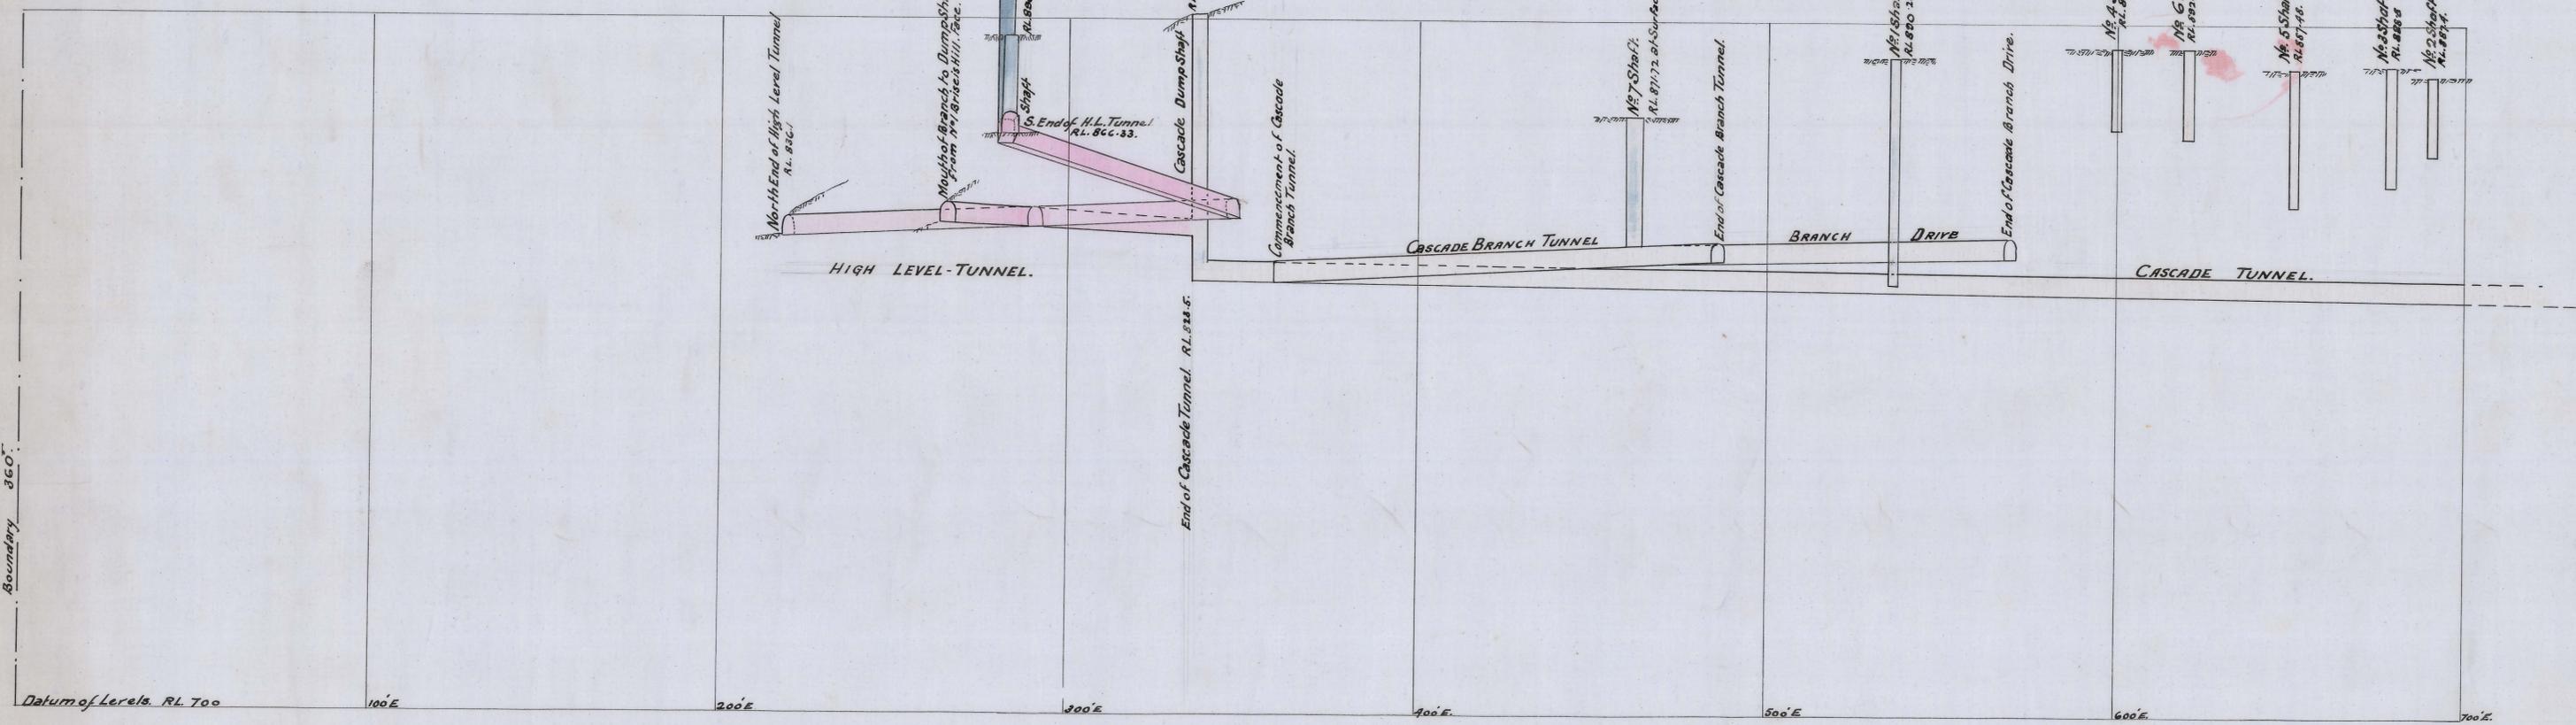

Datum of Levels. RL. 700

100'E

200'E

300'E

400'E

500'E

600'E

700'E