


THE BRISEIS TIN MINES LTD

PROJECTION ON NORTH & SOUTH PLANE

Shewing Underground Workings for the Year 1903

Scale - 1 Inch = 25 Feet

Ruddey & Clark Gen. Mgrs.

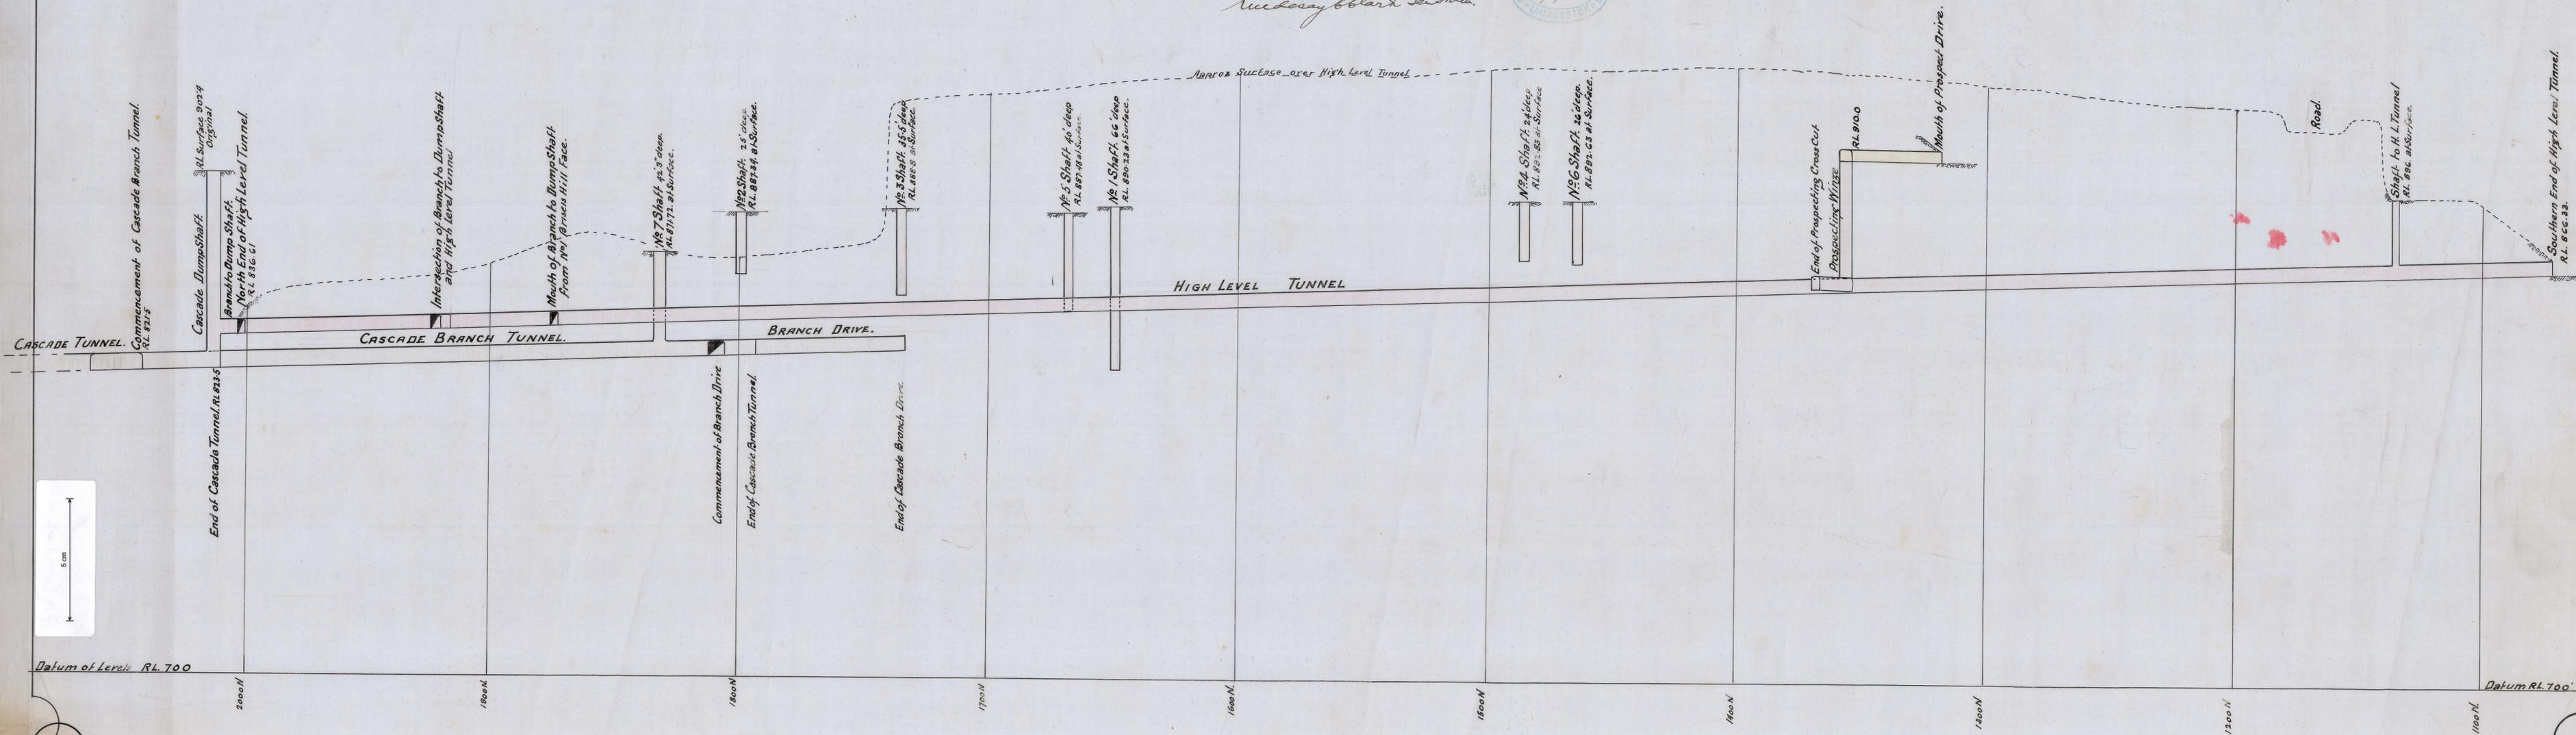

349



Datum of Levels RL 700

Datum RL 700