


170

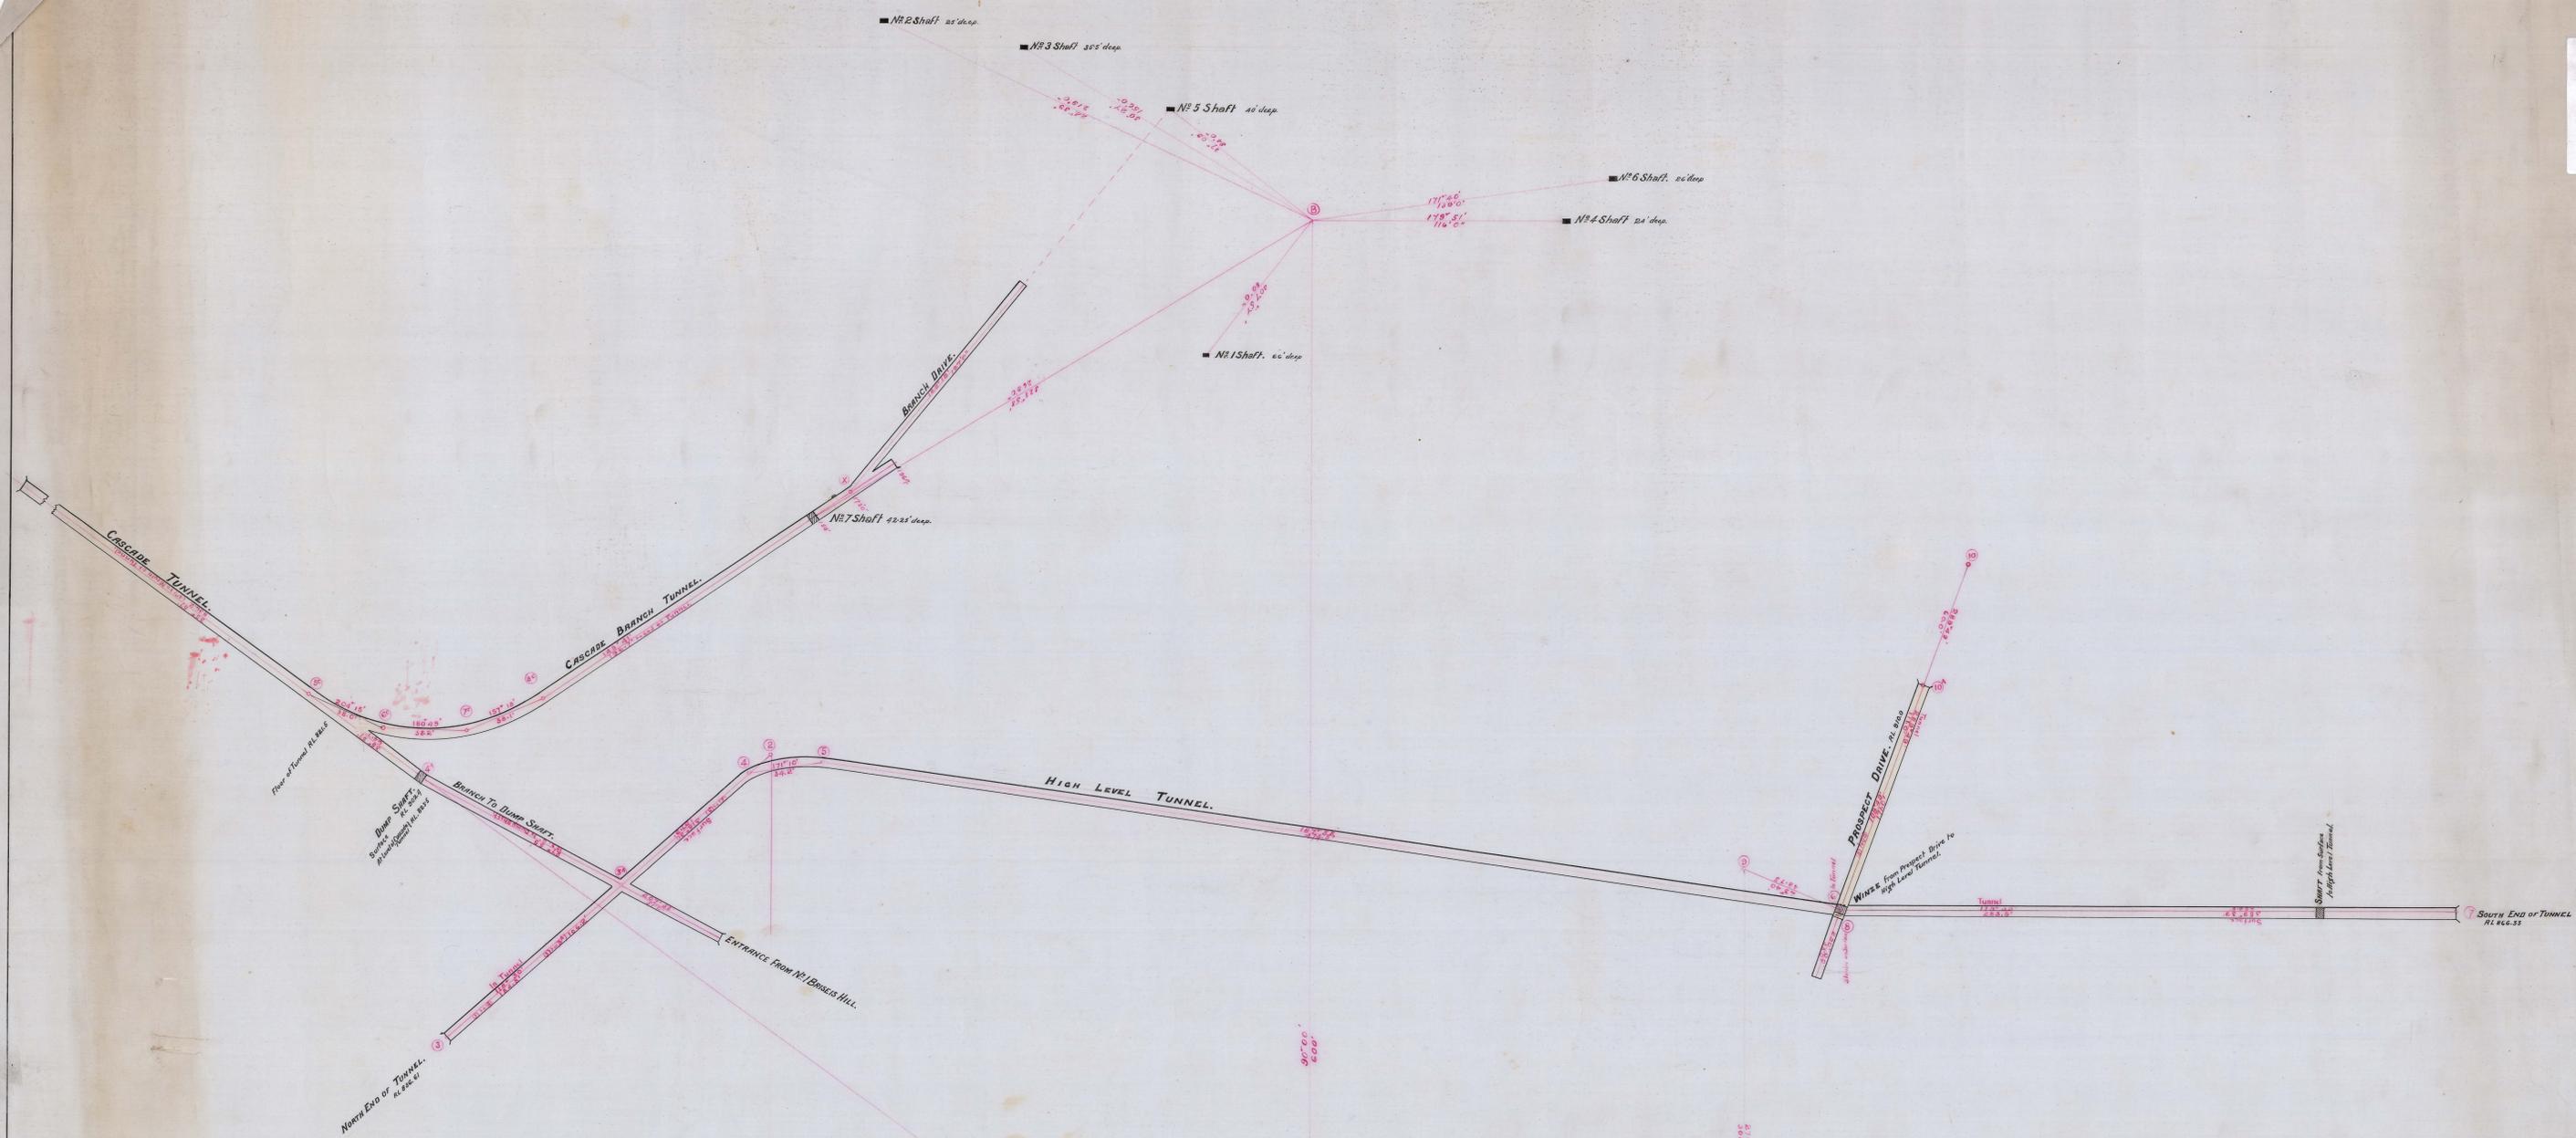

CONSOLIDATED LEASE NO 344 M 139 AC.

THE BRISEIS TIN MINES LTD

PLAN

— SHEWING UNDERGROUND WORKINGS FOR YEAR 1903. —

SCALE 1 INCH = 25 FEET.

Richard H. Allen & Co. General Managers.



NEW BROTHERS HOME NO 1 COMPANY N.L.
CONSOLIDATED LEASE NO 2214.

170