

# THE BRISEIS TIN MINES LTD

## — PLAN —

### — SHOWING UNDERGROUND WORKINGS —

— TO END OF MARCH '08 —


— SCALE: 40 FT = 1 IN. —

*Johnston*  
27/4/08

*5 Years' Record*



A 242 0 0  
Thomas Beswick  
Pur.

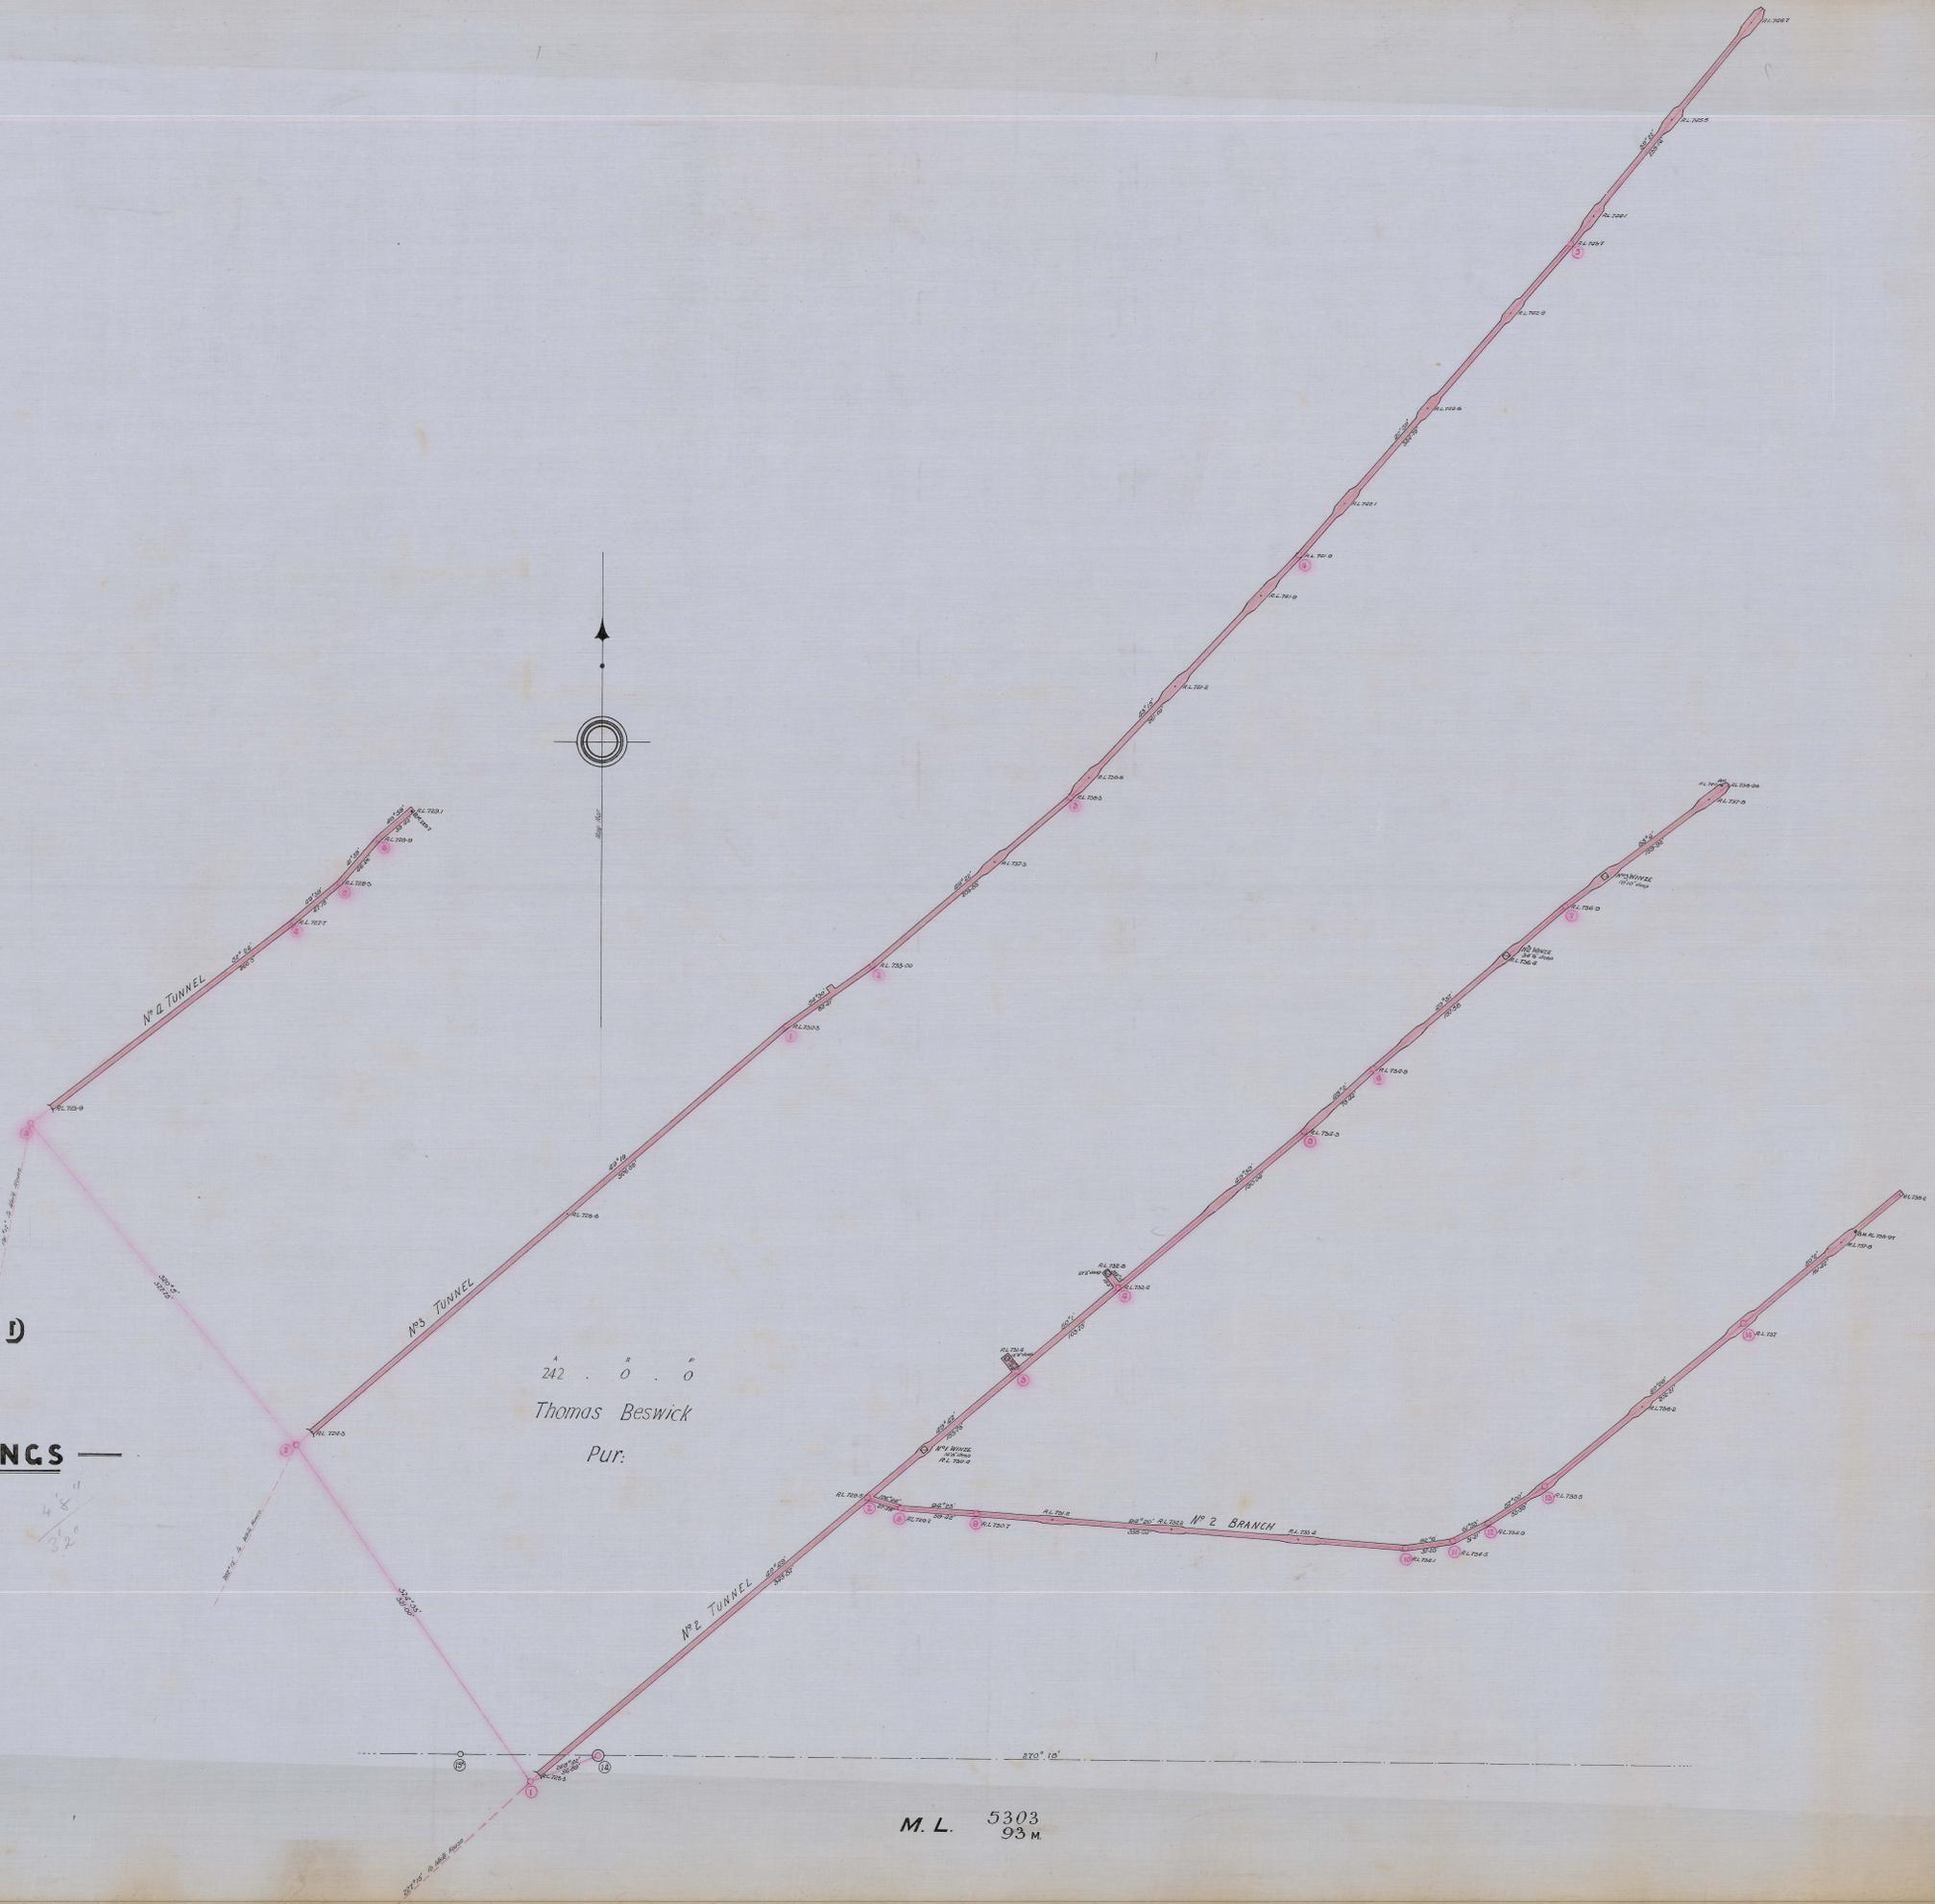

M. L. 5303  
93 M.