



0349-028

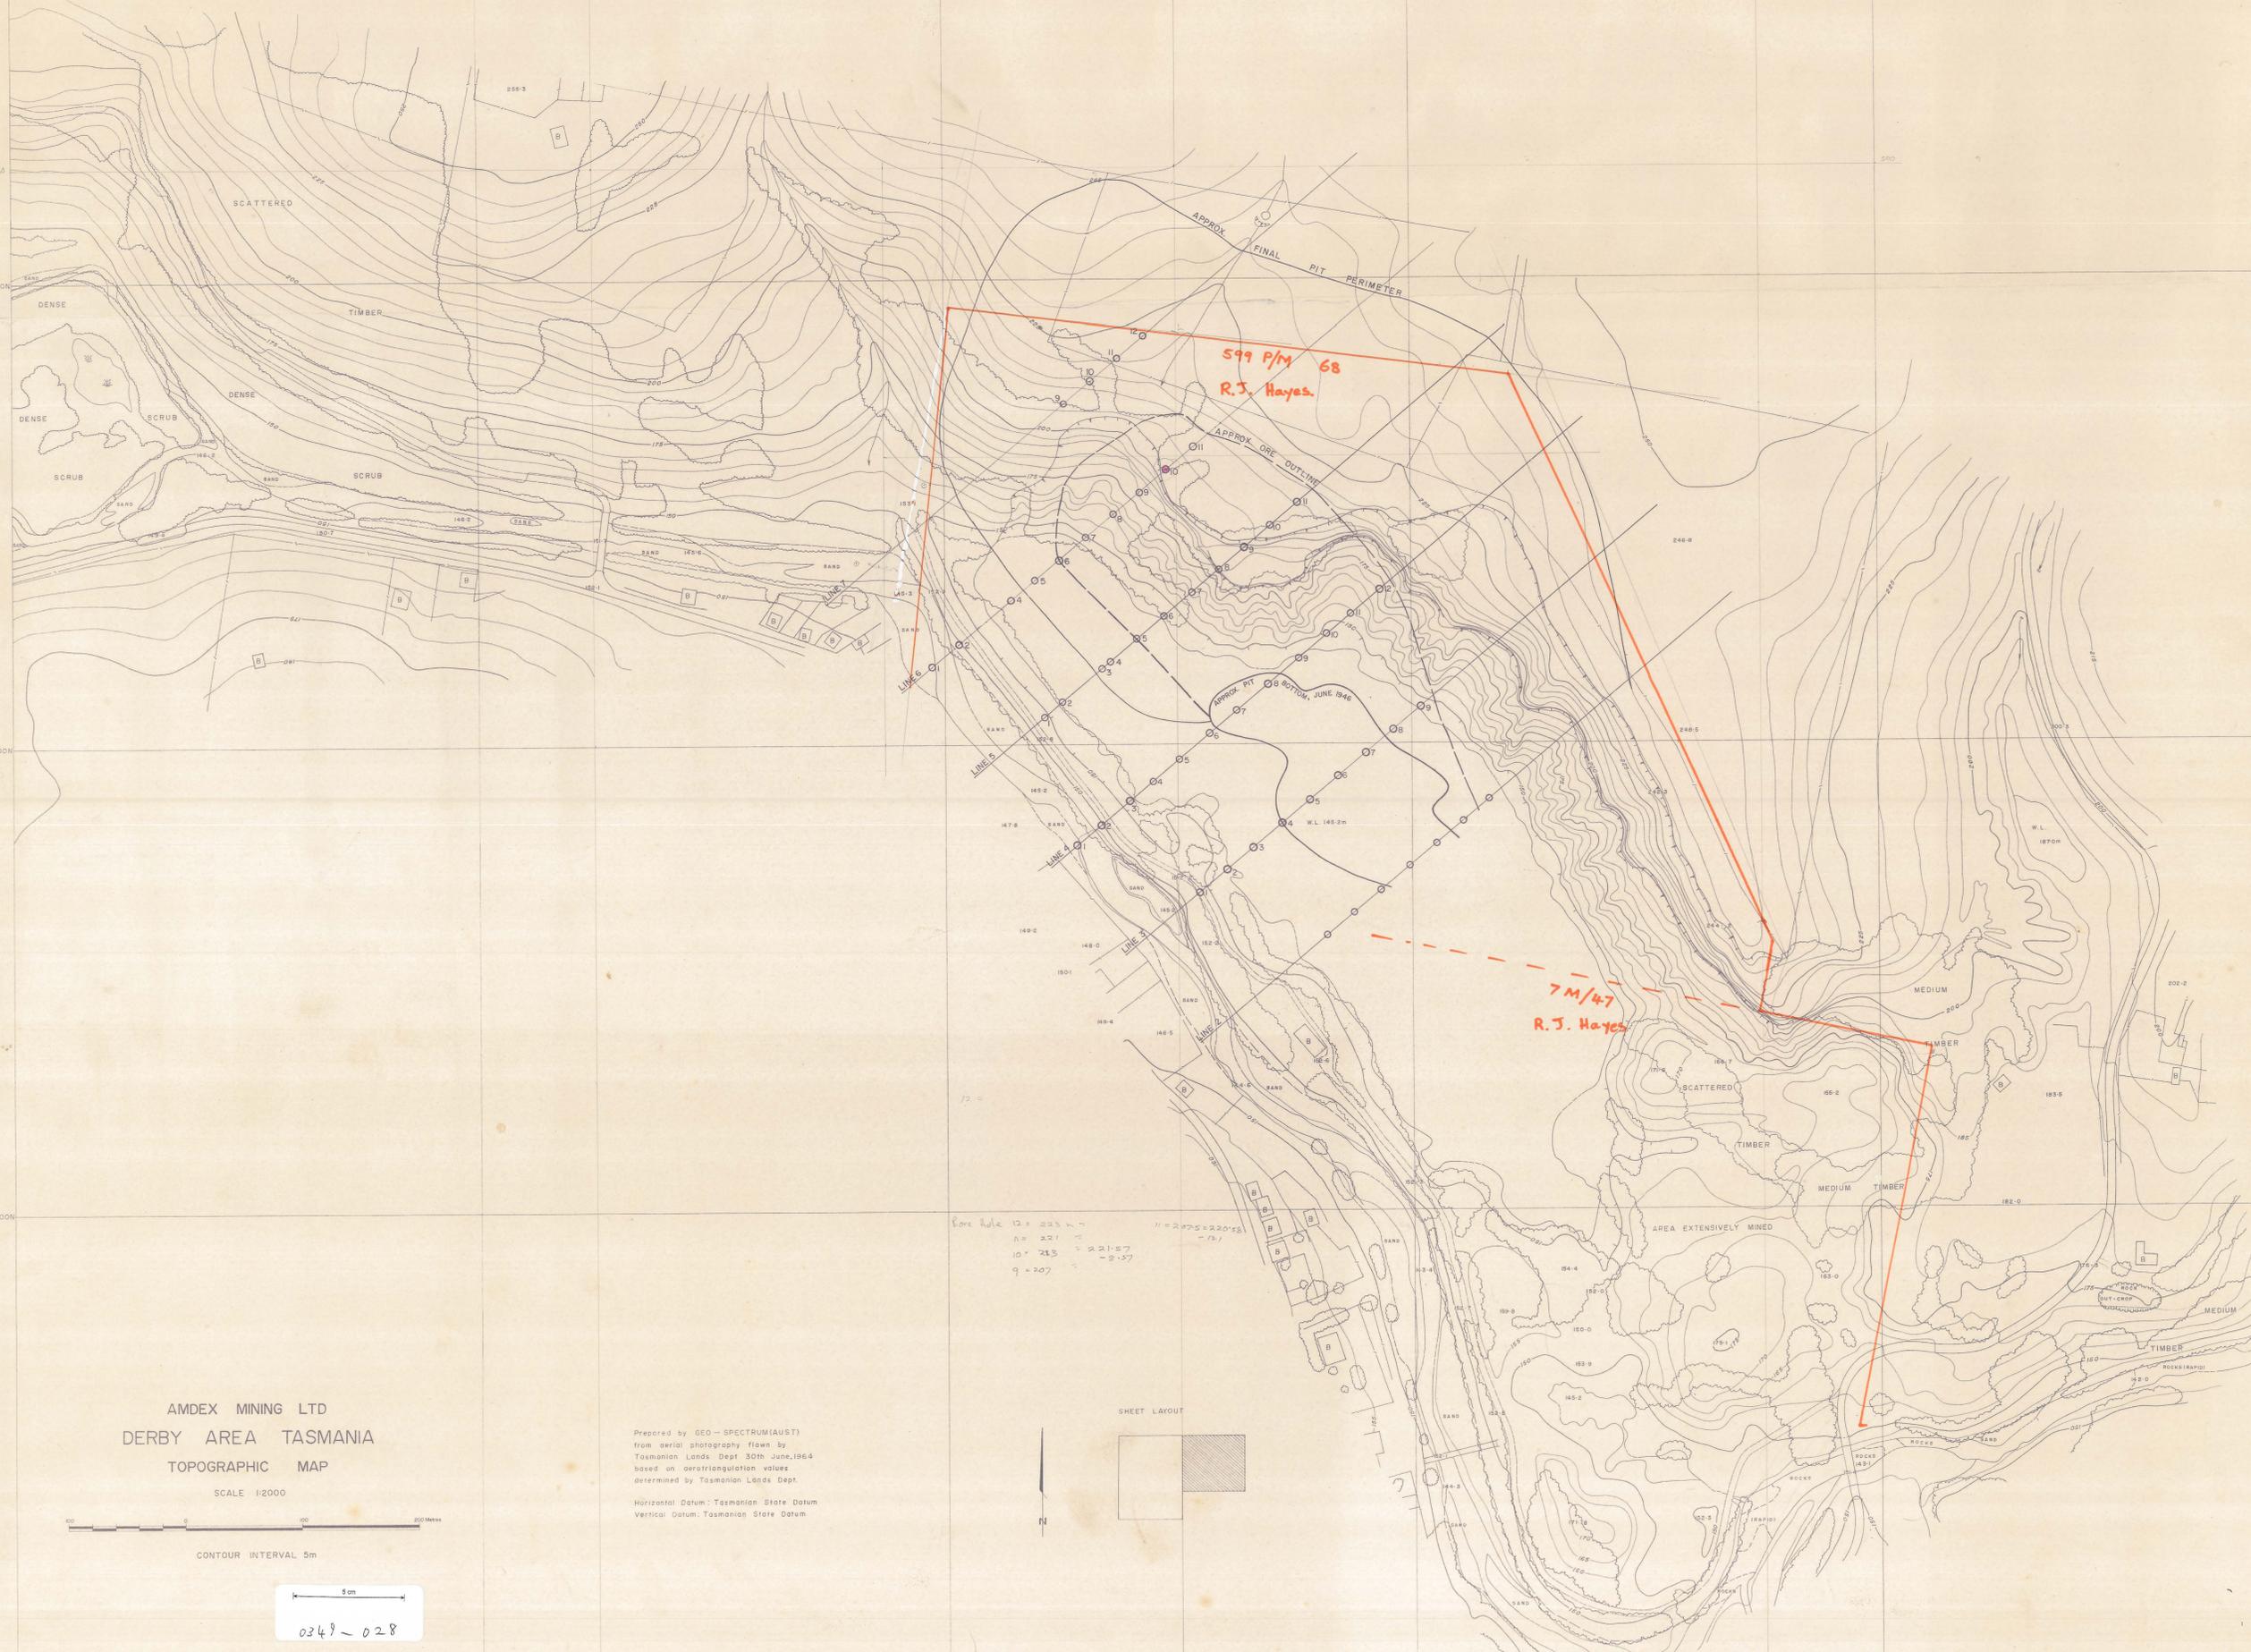


Core hole 12 = 223 m
 n = 221
 10 = 243
 9 = 207
 11 = 207.5 = 220.55
 - 12.1

AMDEX MINING LTD
 DERBY AREA TASMANIA
 TOPOGRAPHIC MAP

SCALE 1:2000

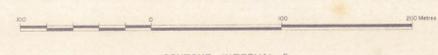

CONTOUR INTERVAL 5m

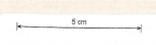

0349-028

Prepared by GEO-SPECTRA(AUST)
 from aerial photography flown by
 Tasmanian Lands Dept 30th June, 1964
 based on aerotriangulation values
 determined by Tasmanian Lands Dept.
 Horizontal Datum: Tasmanian State Datum
 Vertical Datum: Tasmanian State Datum

SHEET LAYOUT

