


Plate 4 Plate No 3

PLATE 4



GOLDEN ENTRANCE

Scale 25 ft to 1 inch



Survey of work up to March 1907
with theodolite & compass
C. Binley Watchman
Geo. Turner
3/5/07

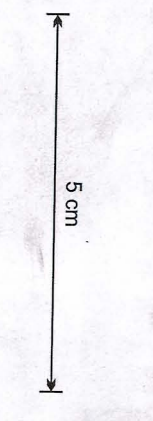

350
40

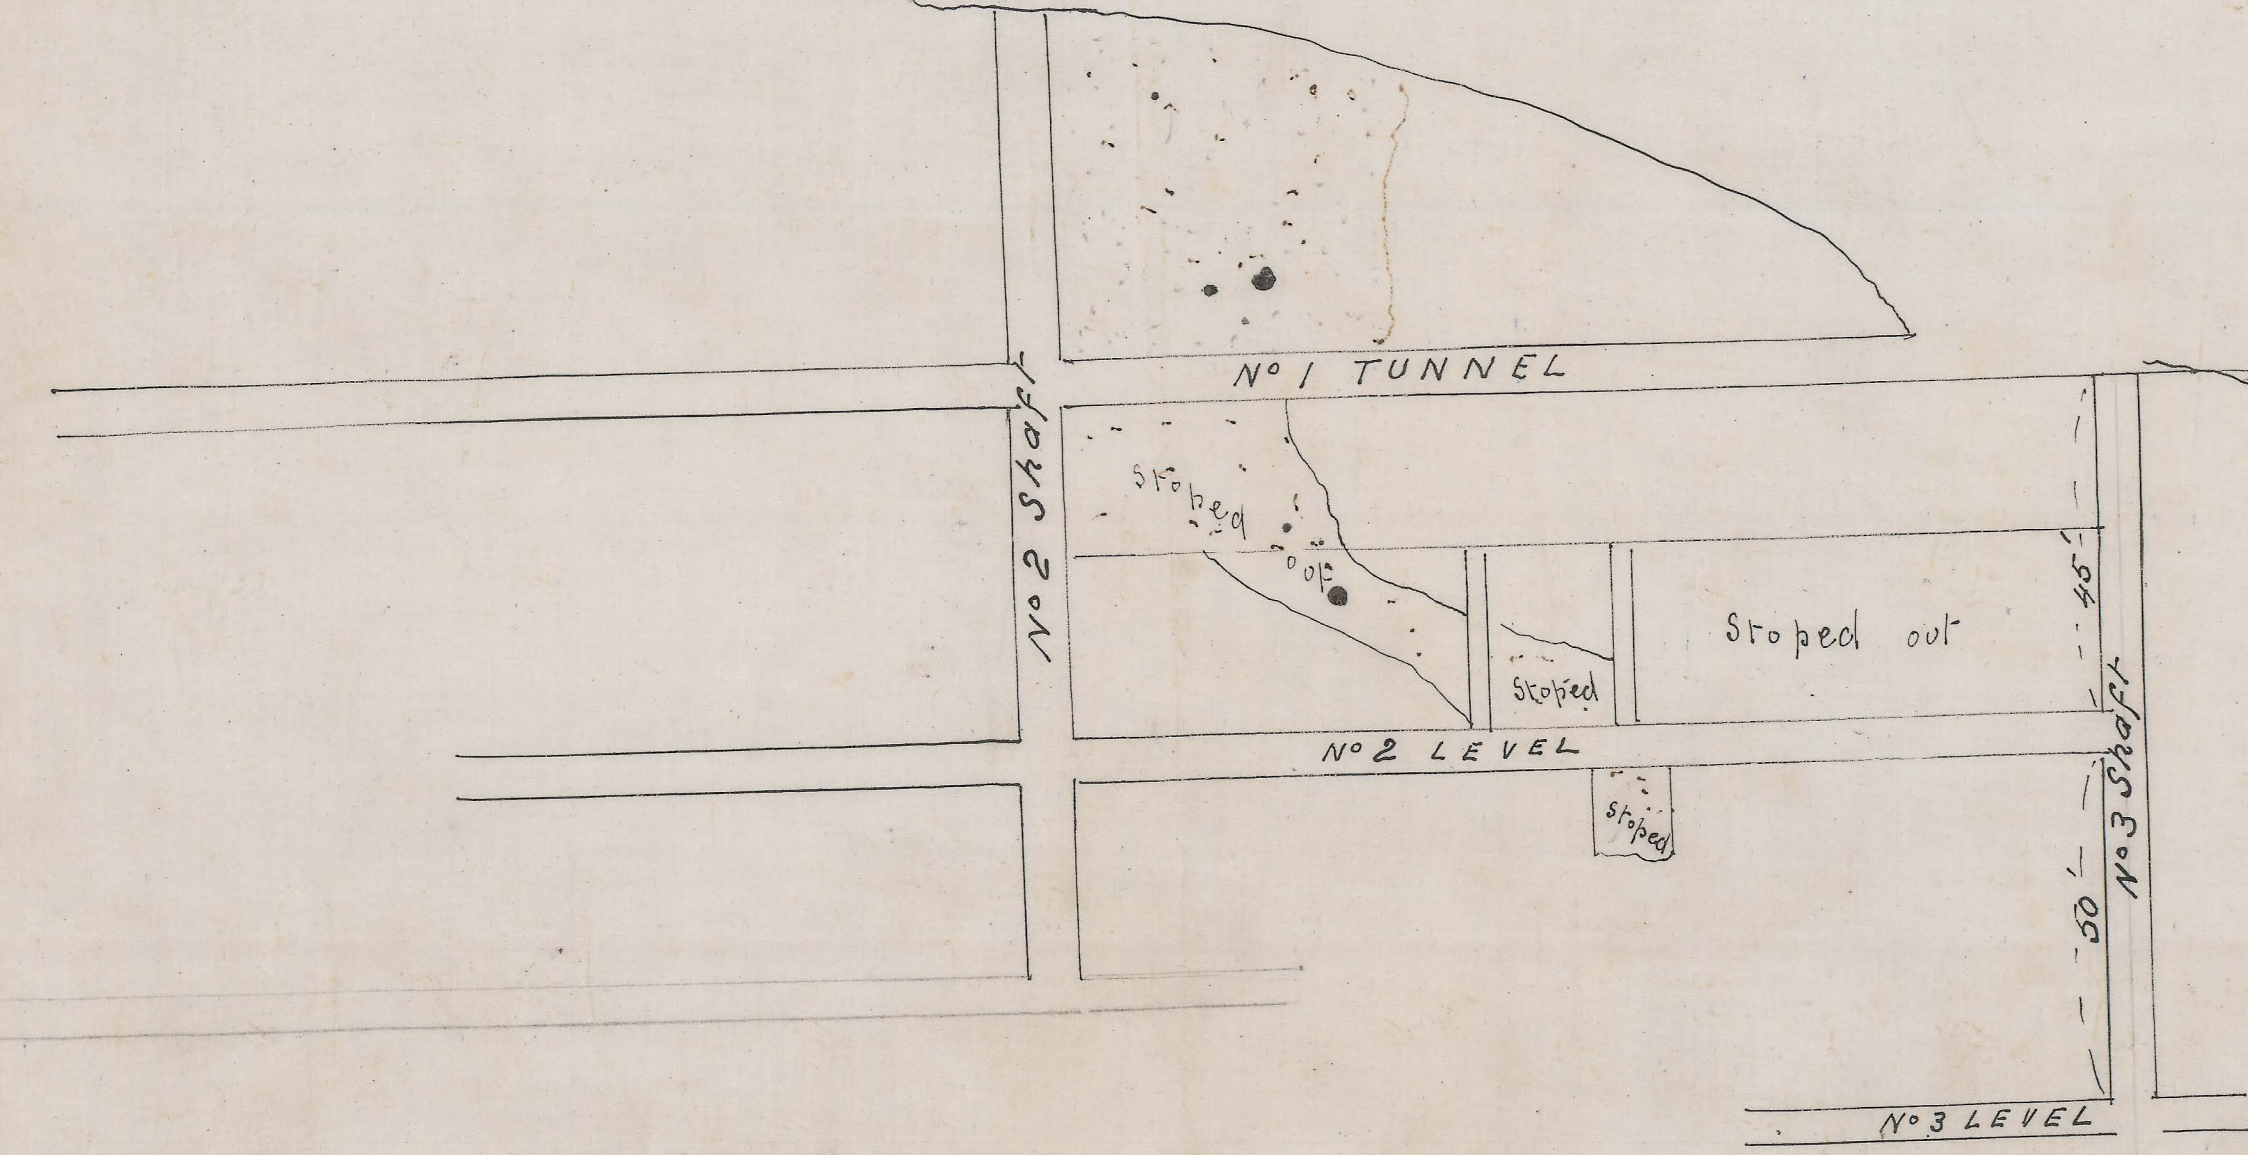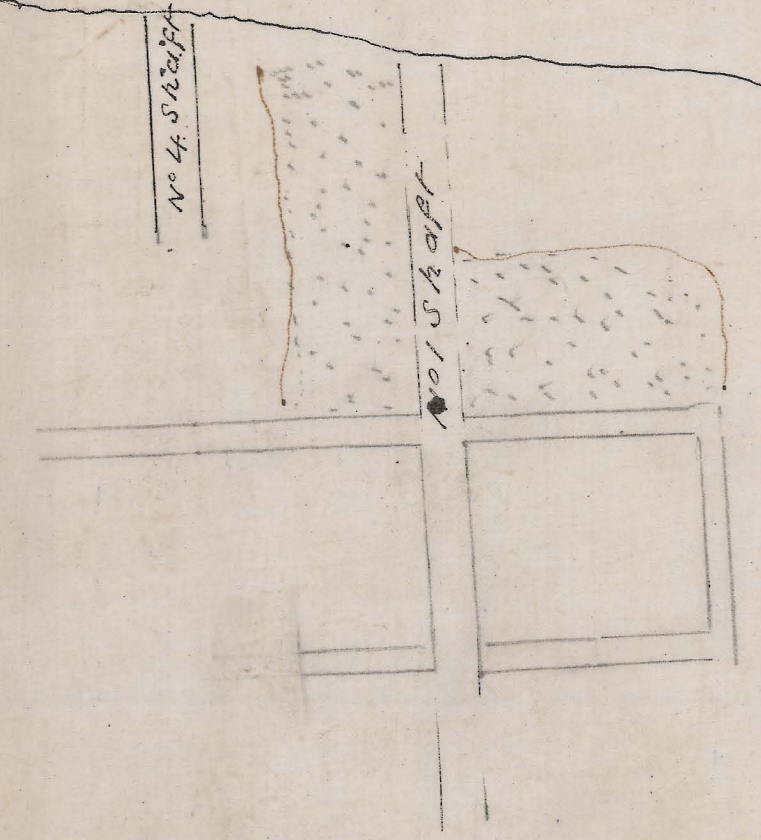

Low Level from Sharkey's gully

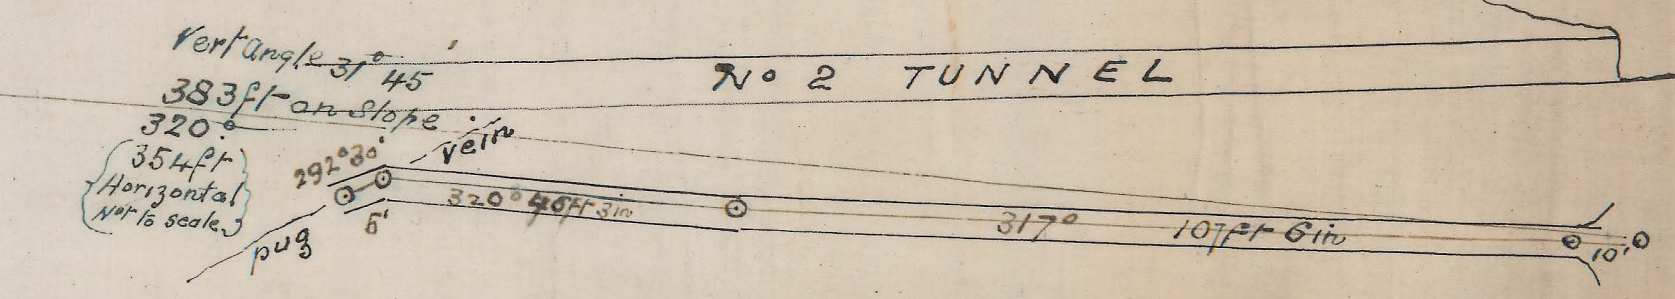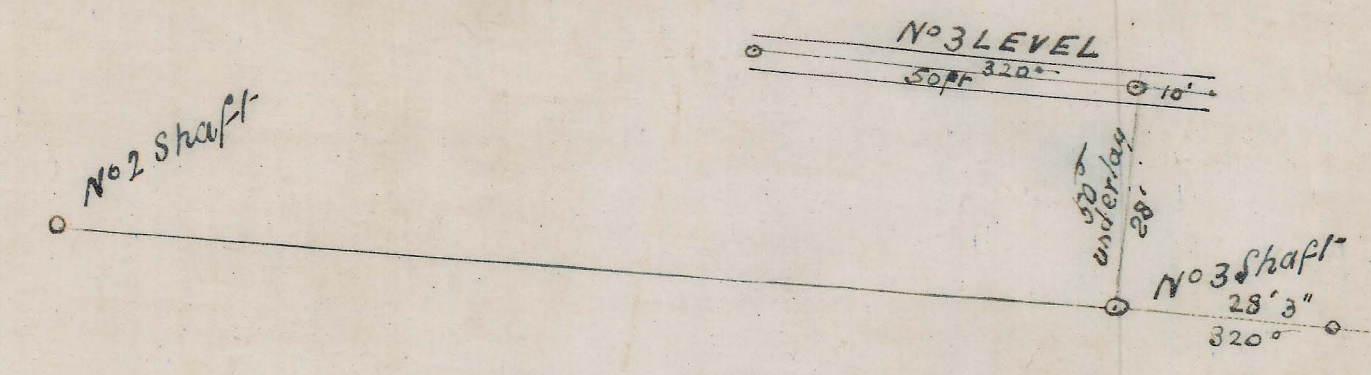

Original notebook
No 1 & 2