

222
10


5 cm

THE M^T FARRELL M^{NE} C^Y


MINE WORKINGS ON BLOCK 2409

SCALE
Twenty five feet to an inch

Adit 50. 1801
W. Lumsden and Co

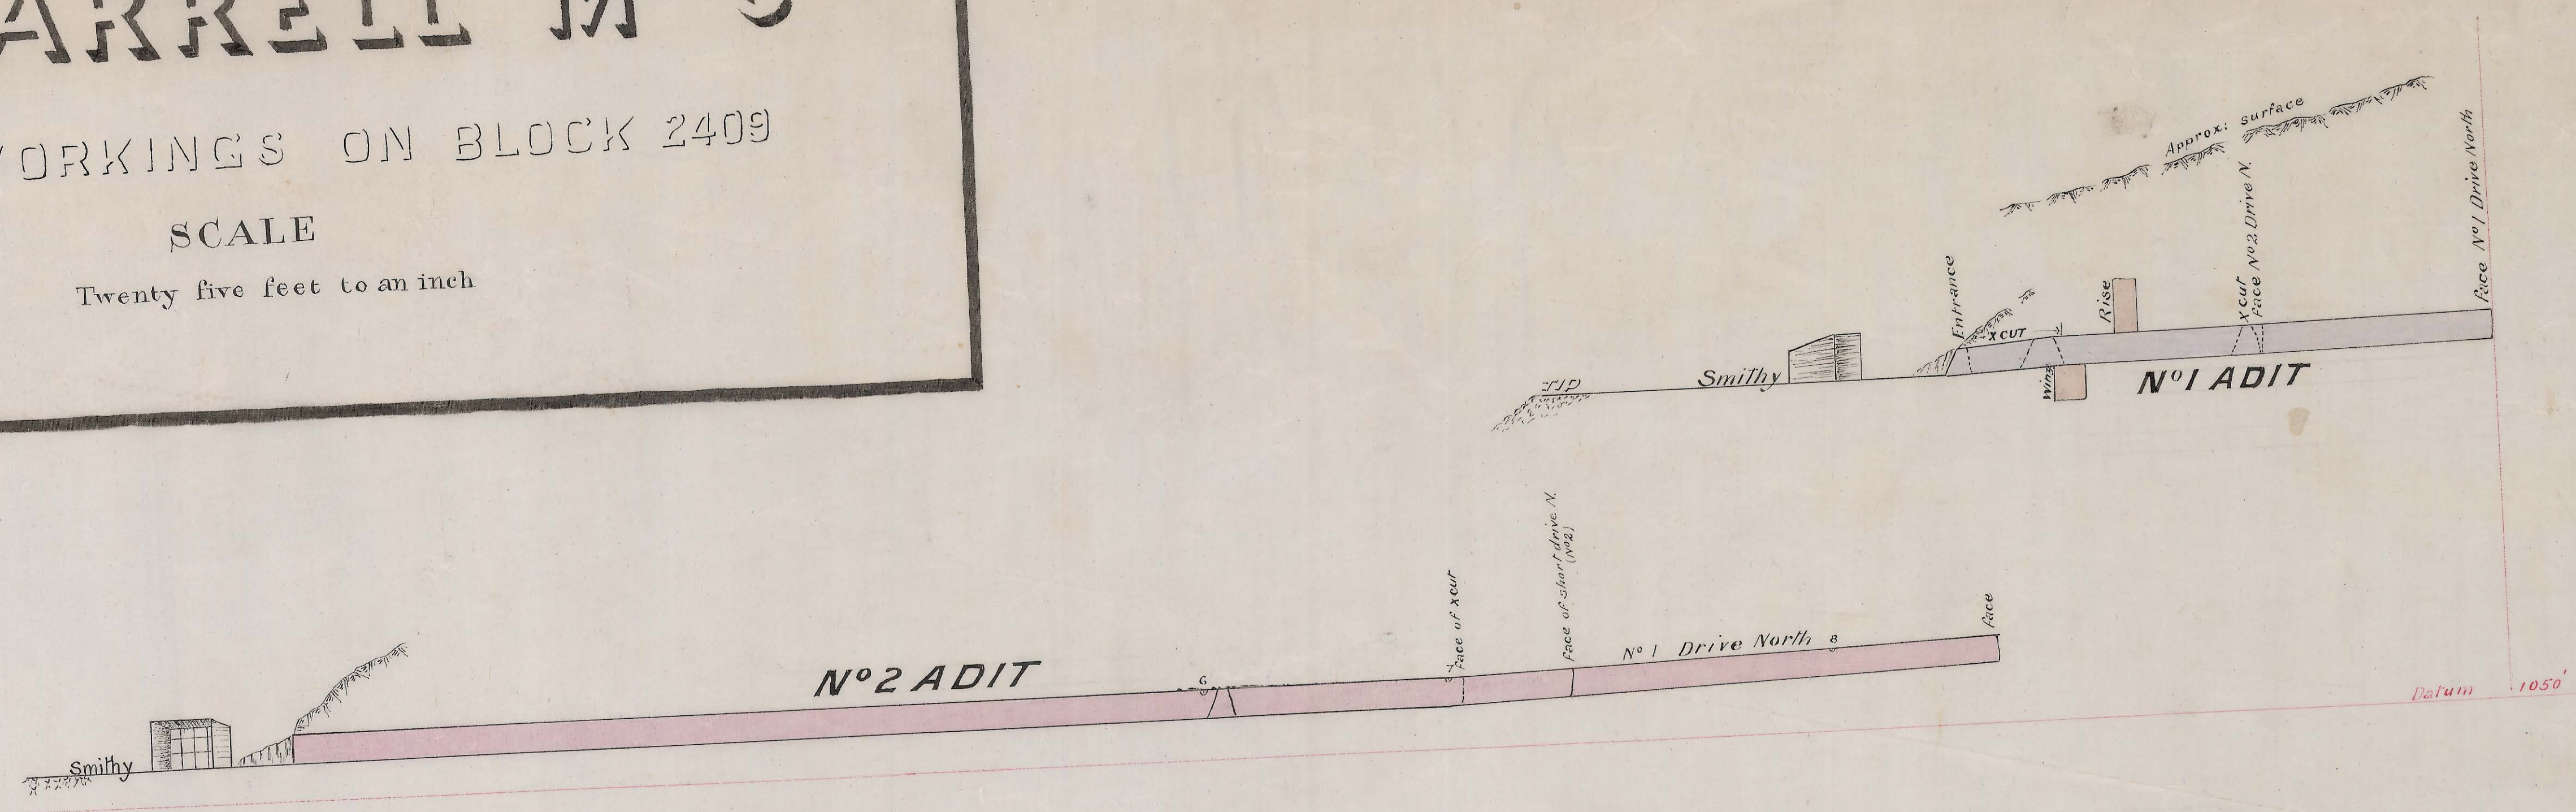

PROJECTION OF ADITS 1 AND 2
on a plane bearing 23° 10'

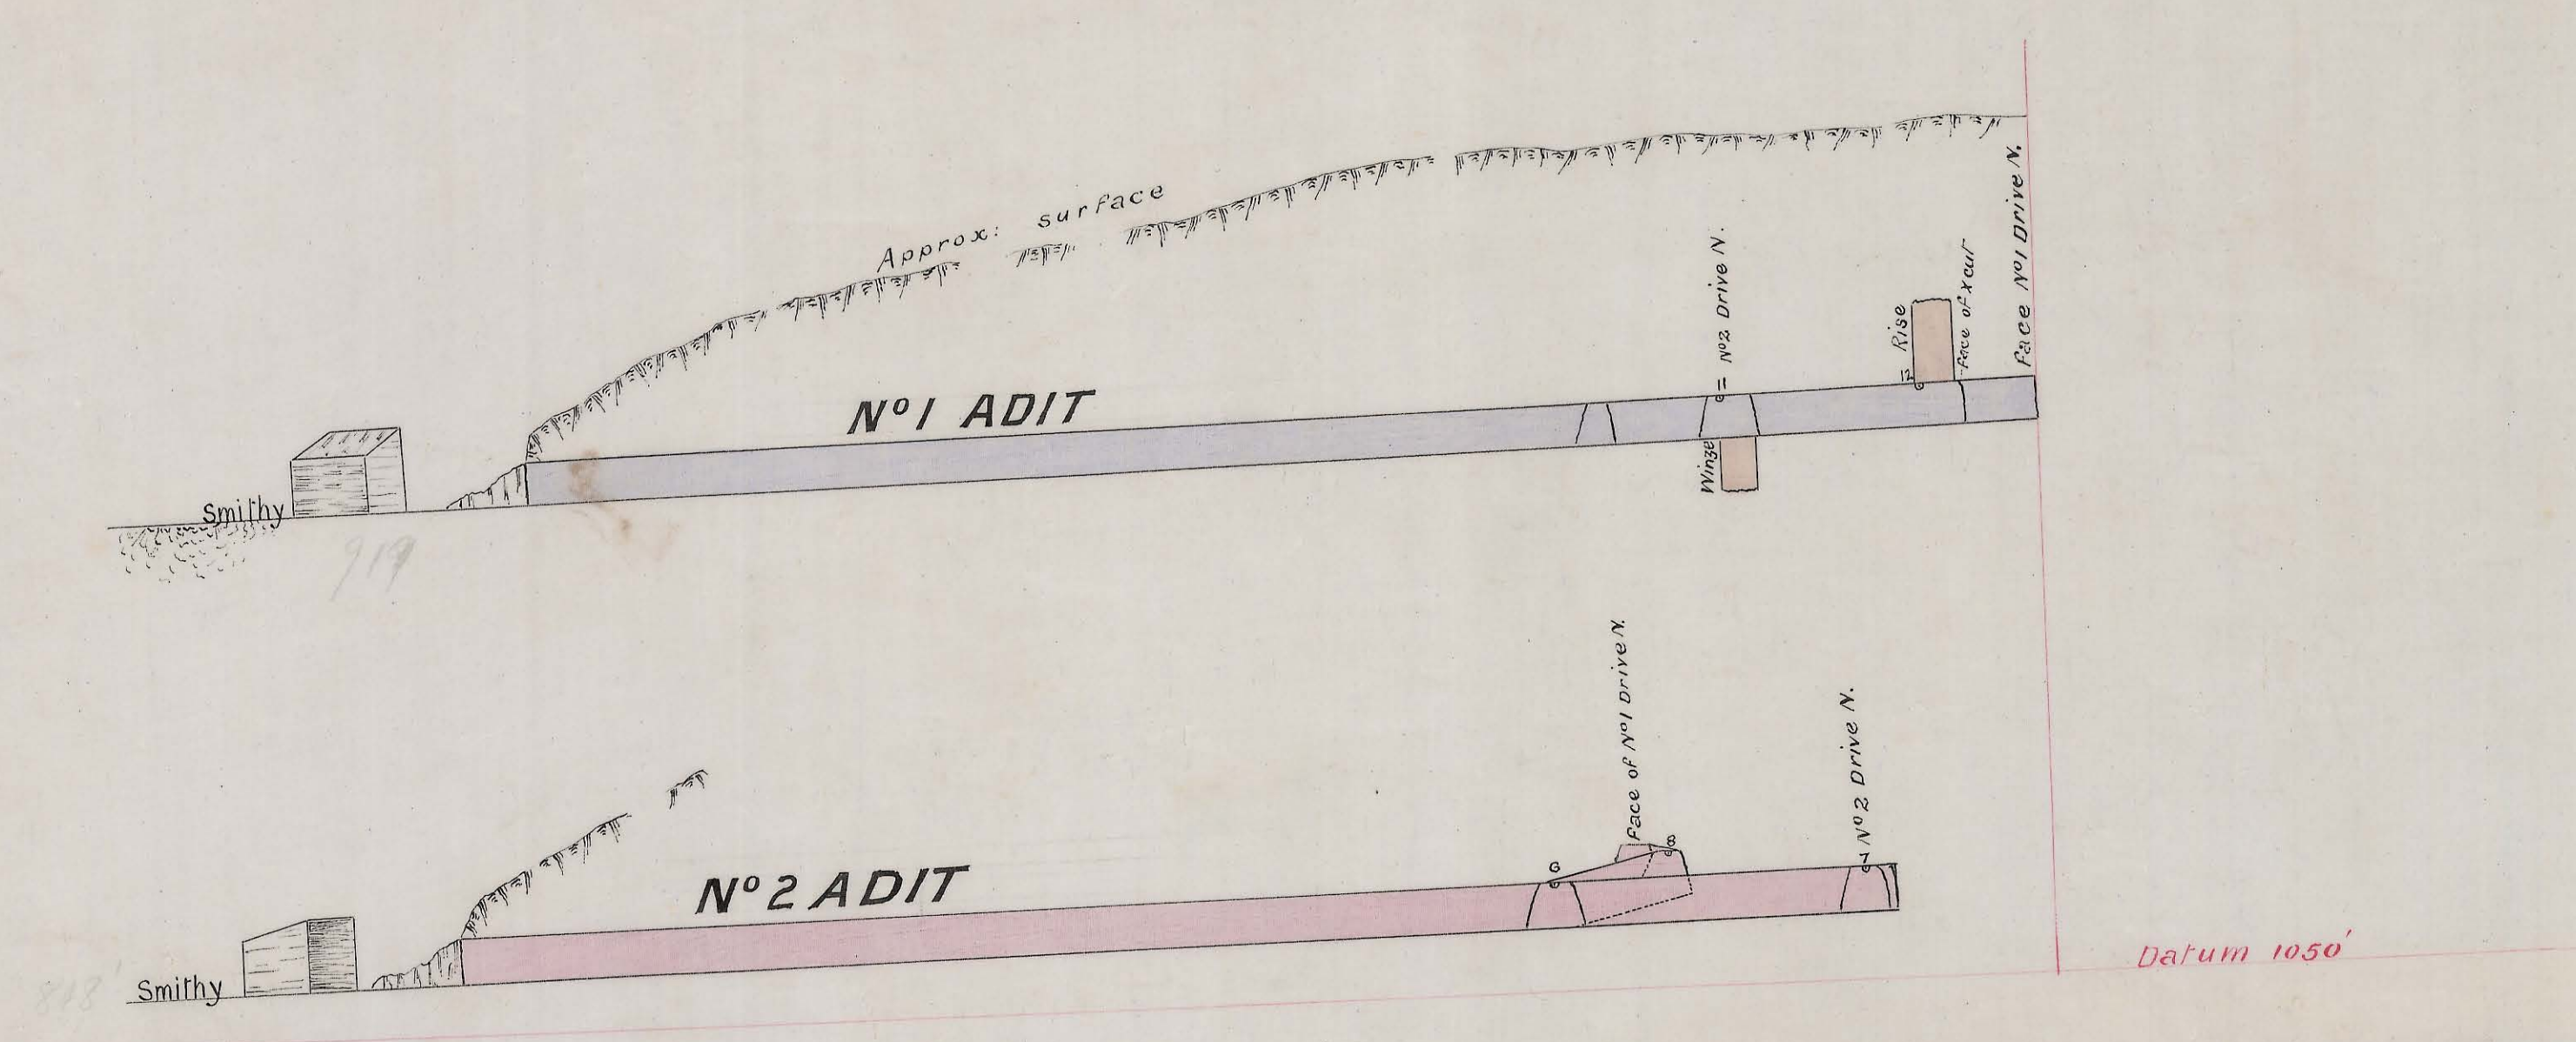

PROJECTION OF ADITS 1 AND 2
on a plane bearing 101° 17'

R.B. Montgomery
Auth. Surveyor
Aug. 20th 1901

