


252  
02

# THE M<sup>r</sup> FARRELL M<sup>rs</sup> C<sup>oy</sup>

MINE WORKINGS ON BLOCK 2409

SCALE

Twenty five feet to an inch

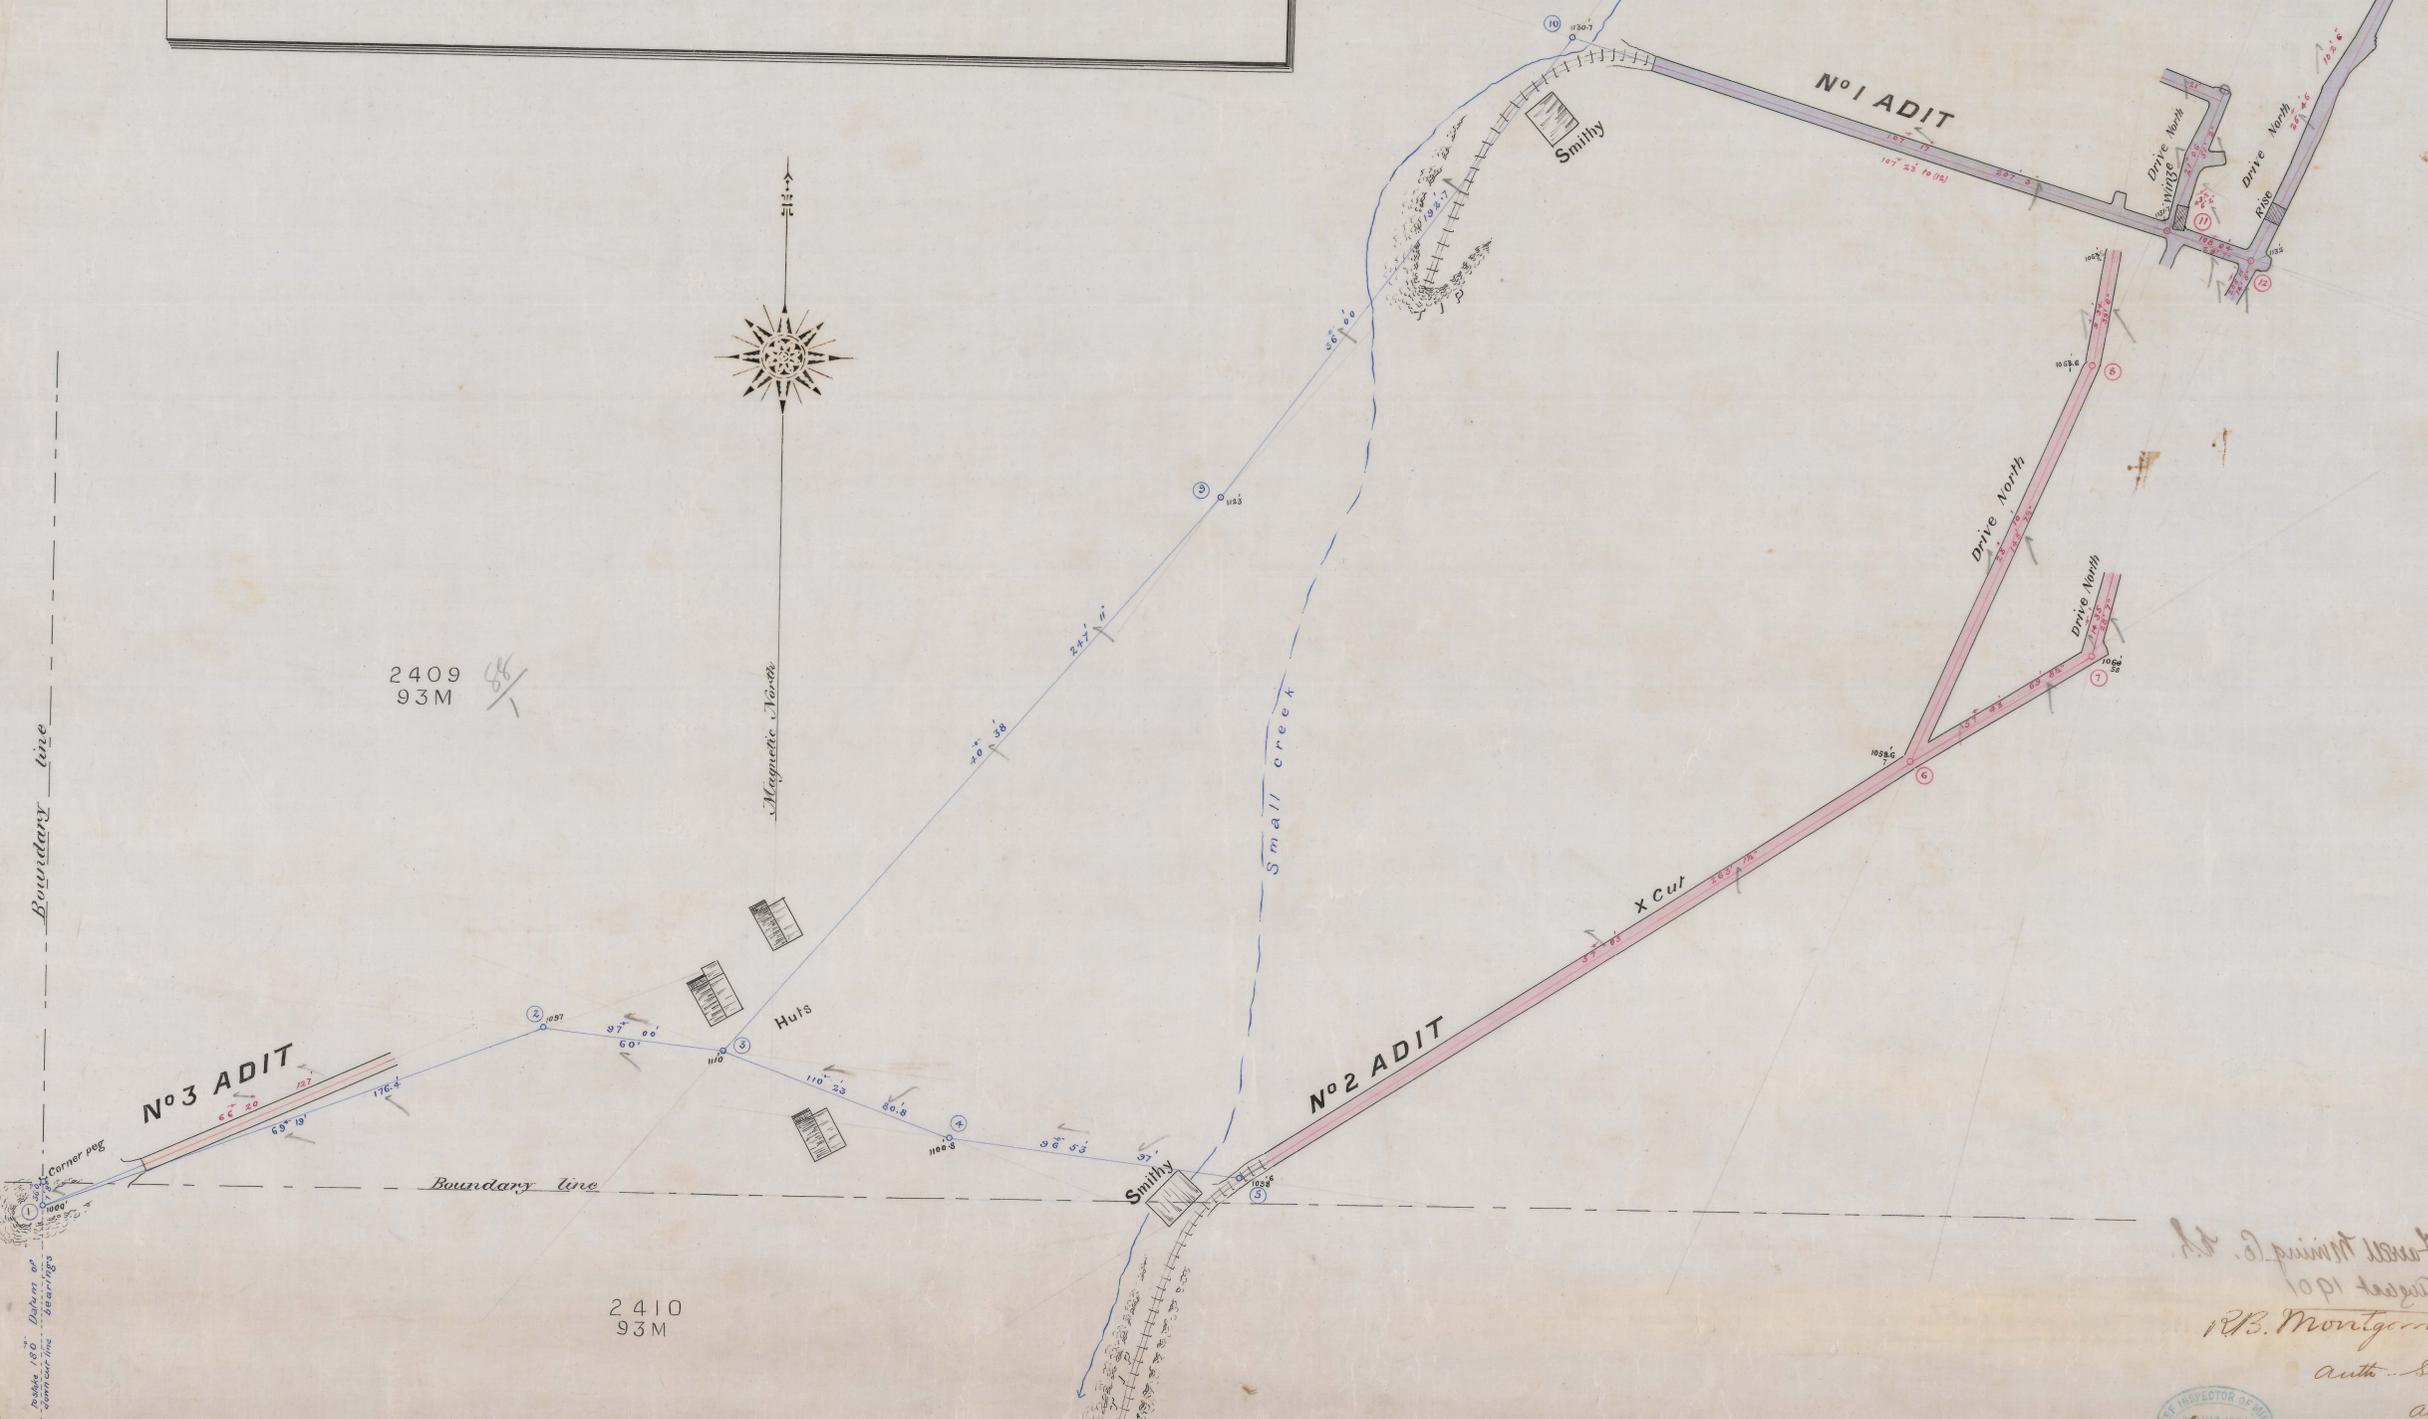

Mount Farrel Mining Co. v.  
 August 1901  
 R.B. Montgomery  
 Auth. Surveyor  
 Aug 20<sup>th</sup> 1901



1081  
 J.M. Abbott & Son