


352
05

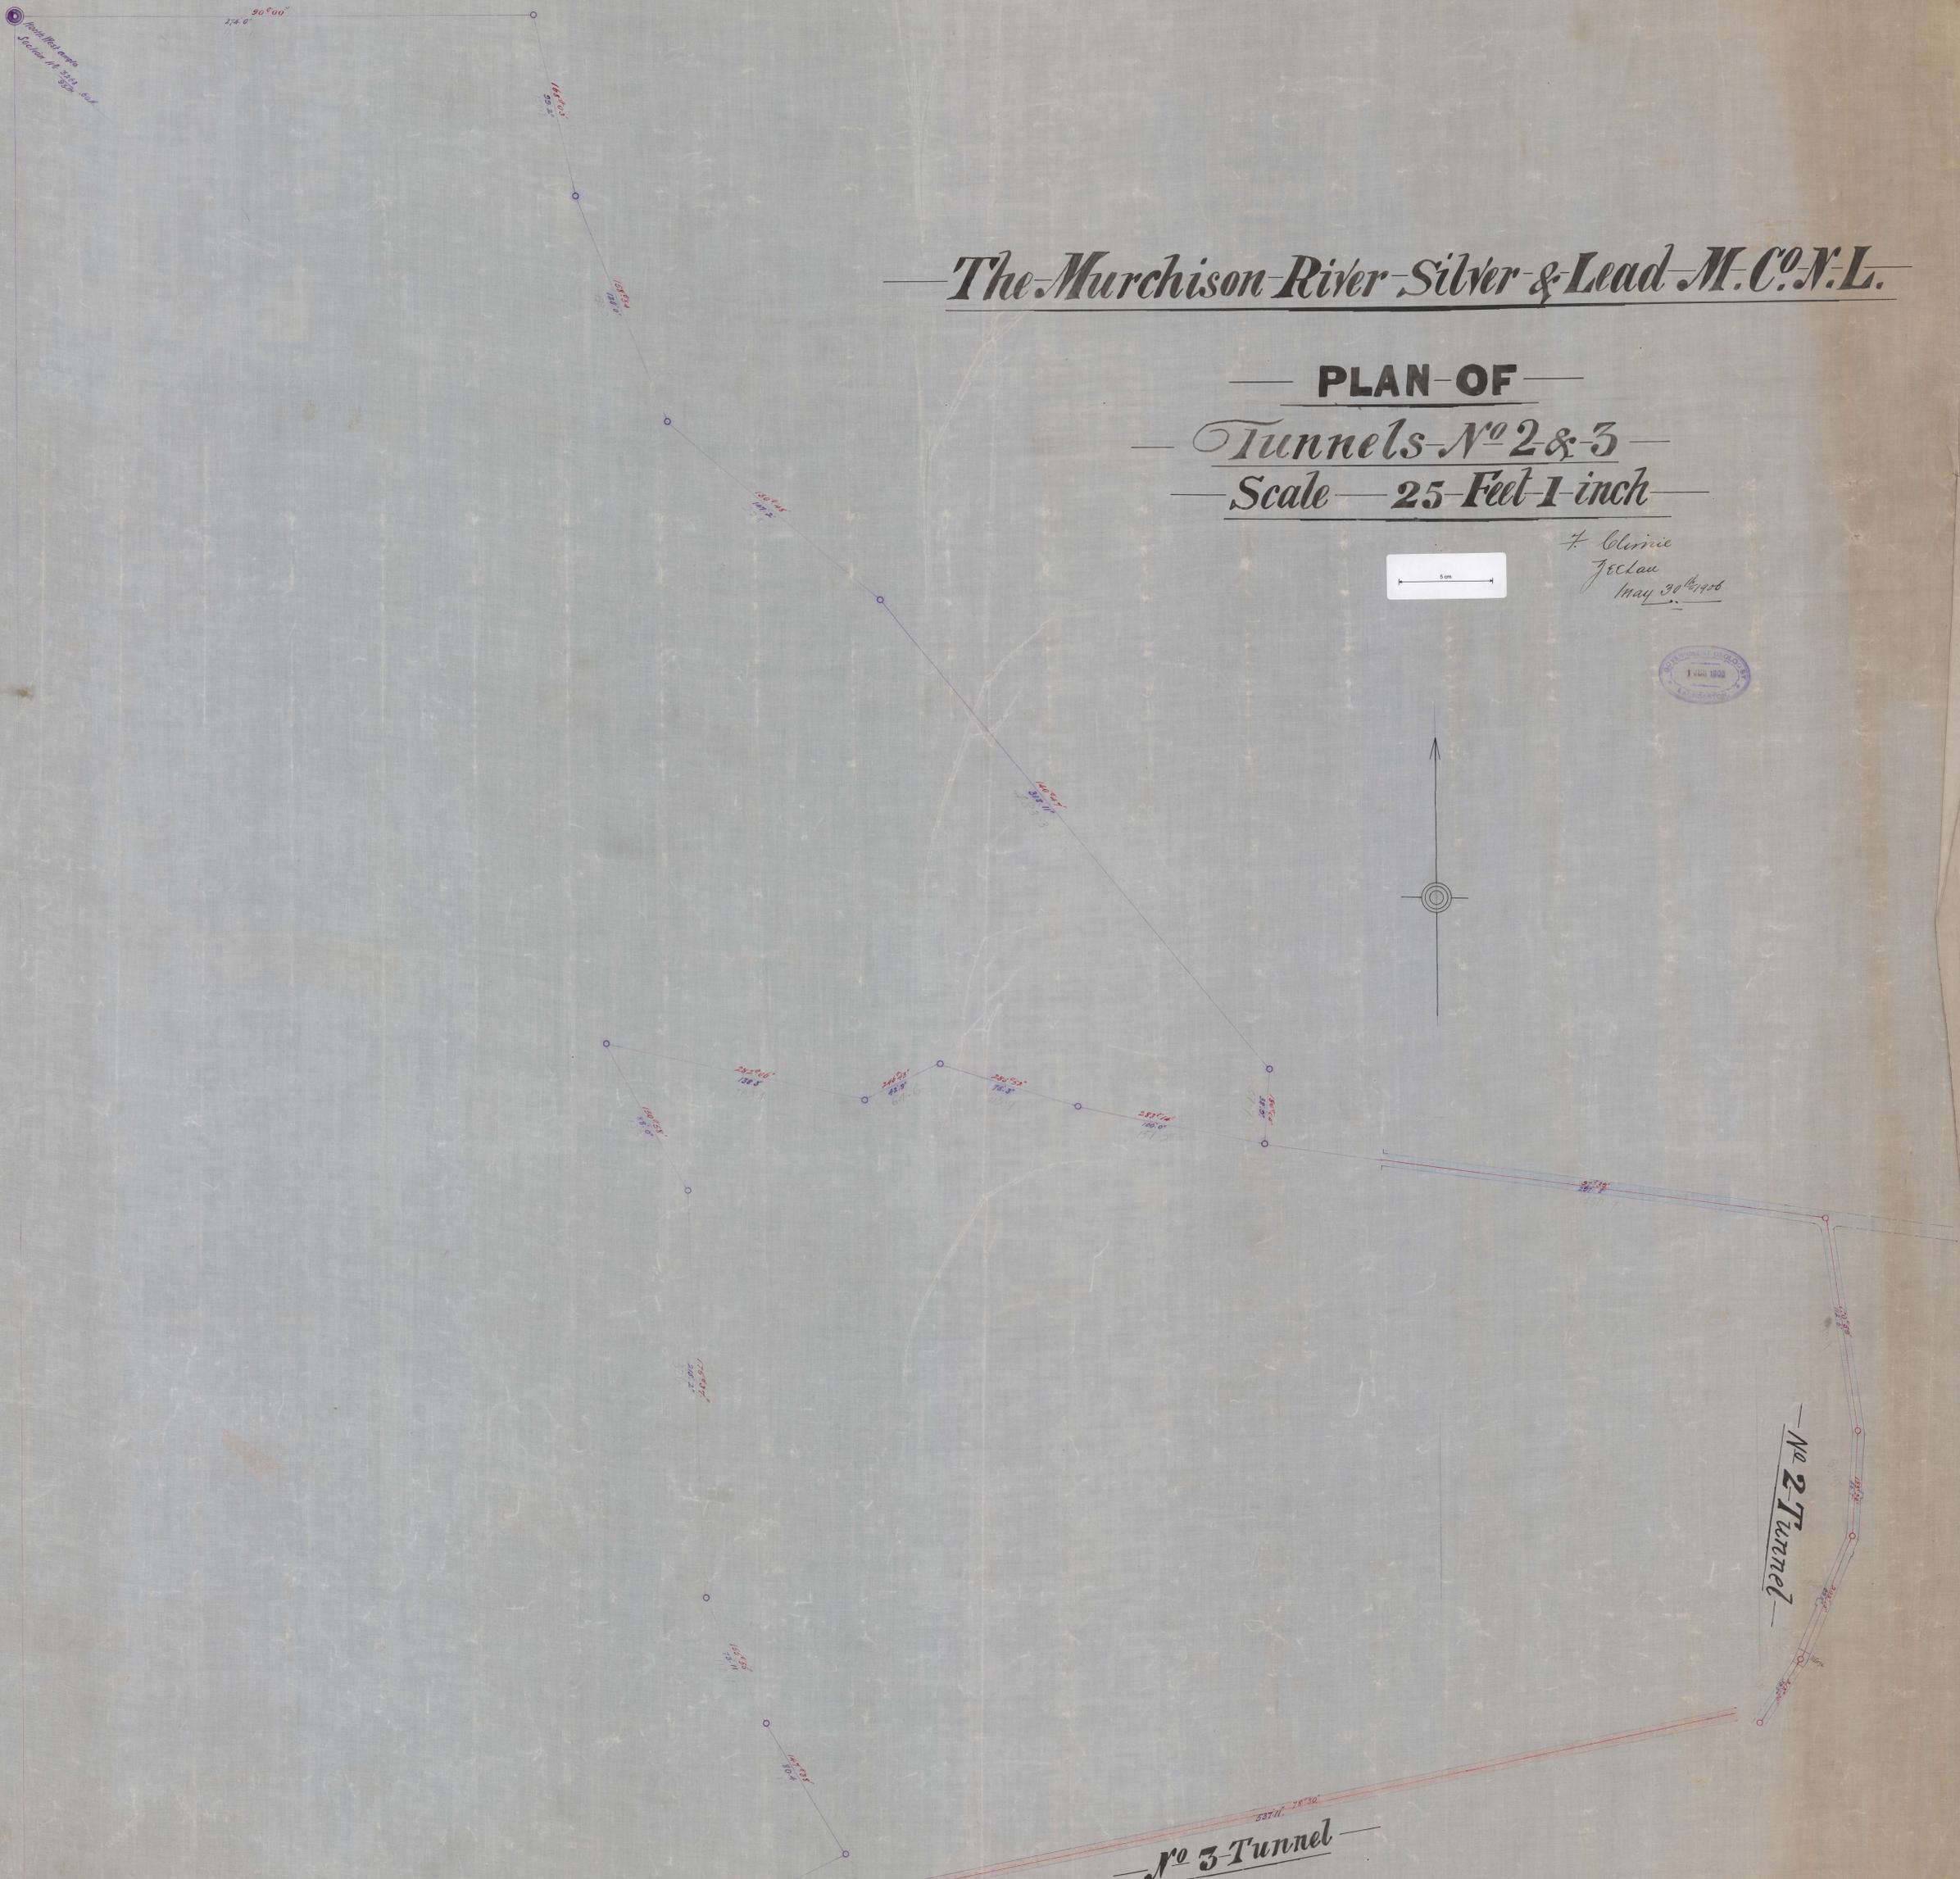

The Murchison River Silver & Lead M. Co. N. L.

PLAN OF

Tunnels No 2 & 3

Scale 25 Feet 1 inch



*F. Clinie
Jochau
May 30th 1896*



No 2 Tunnel

No 3 Tunnel