


352  
11

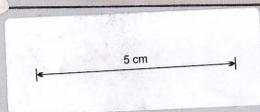




# CROSS SECTIONS OF SHAFT LEVELS

SCALE-40-FEET TO AN INCH

AT 1250

AT 1150

AT 1050

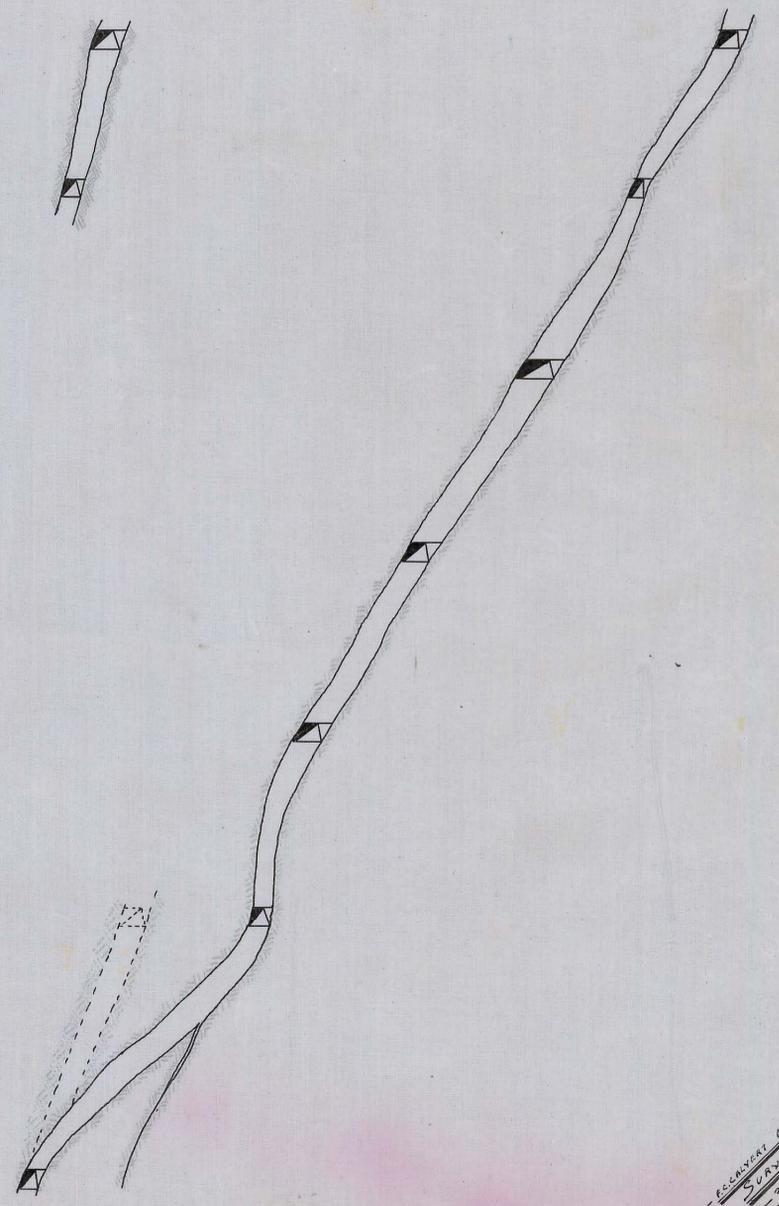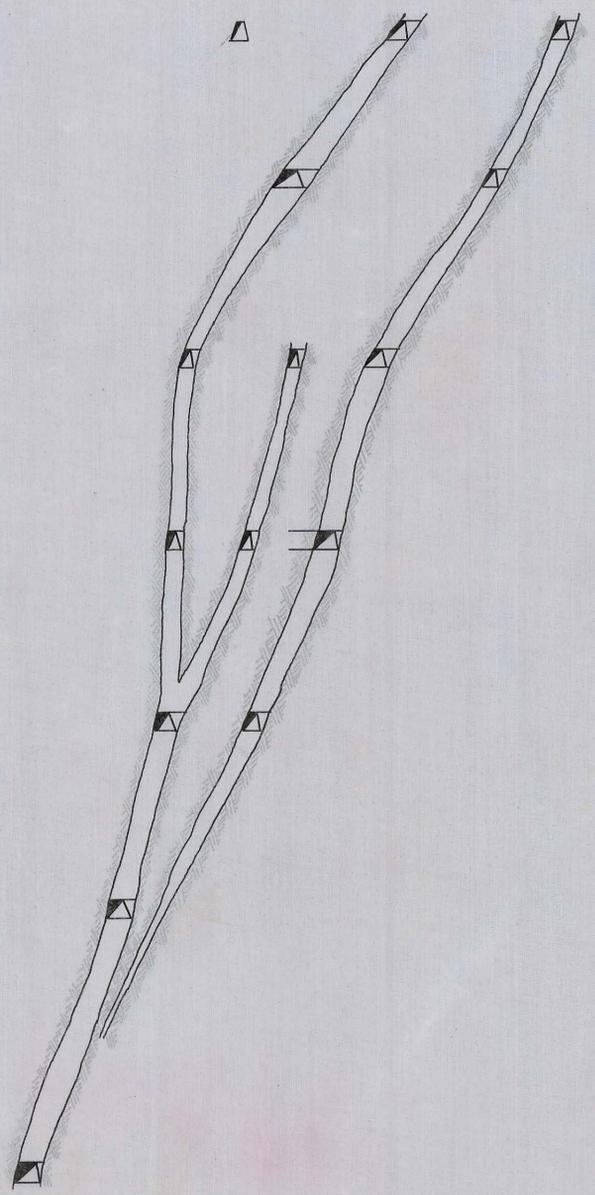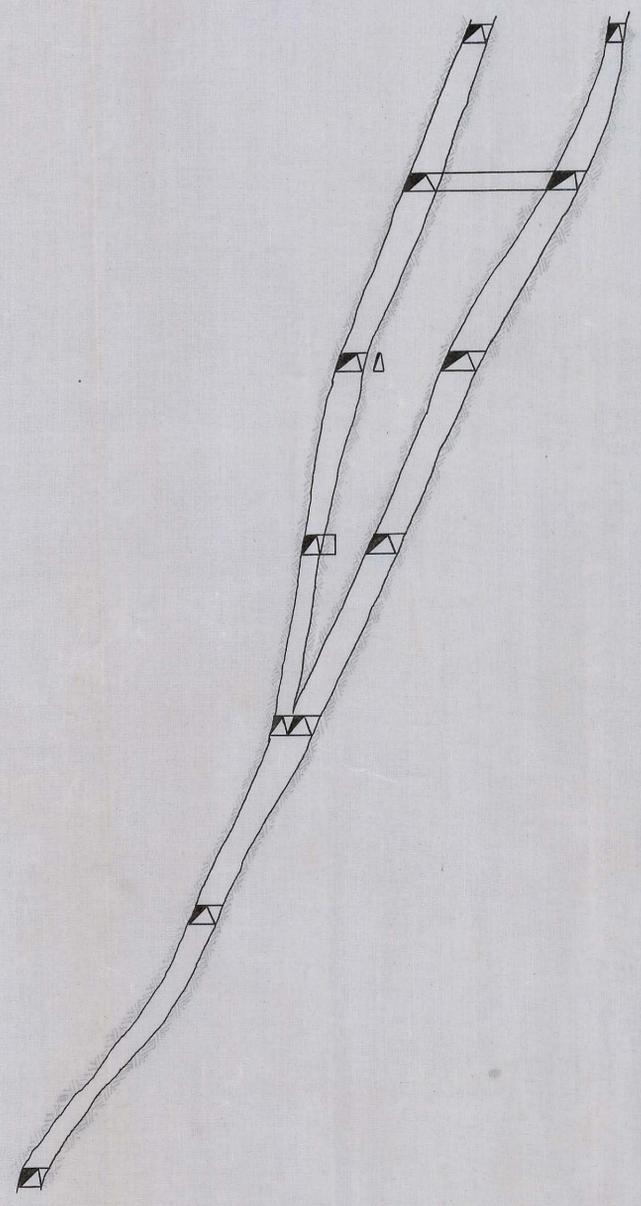

REC'D BY ADM  
SURVEYOR  
2/12/23  
HAW  
1/13/23