

352
13


NORTH MOUNT FARRELL MINE

LONGITUDINAL SECTION SHOWING WORKINGS BELOW N° 6 LEVEL

SCALE 30 FEET TO AN INCH

SHOWING WORKINGS AT 31-12-31 TO 31-12-32

19 4-33
G. Andrew
19-2-32
GENERAL MANAGER

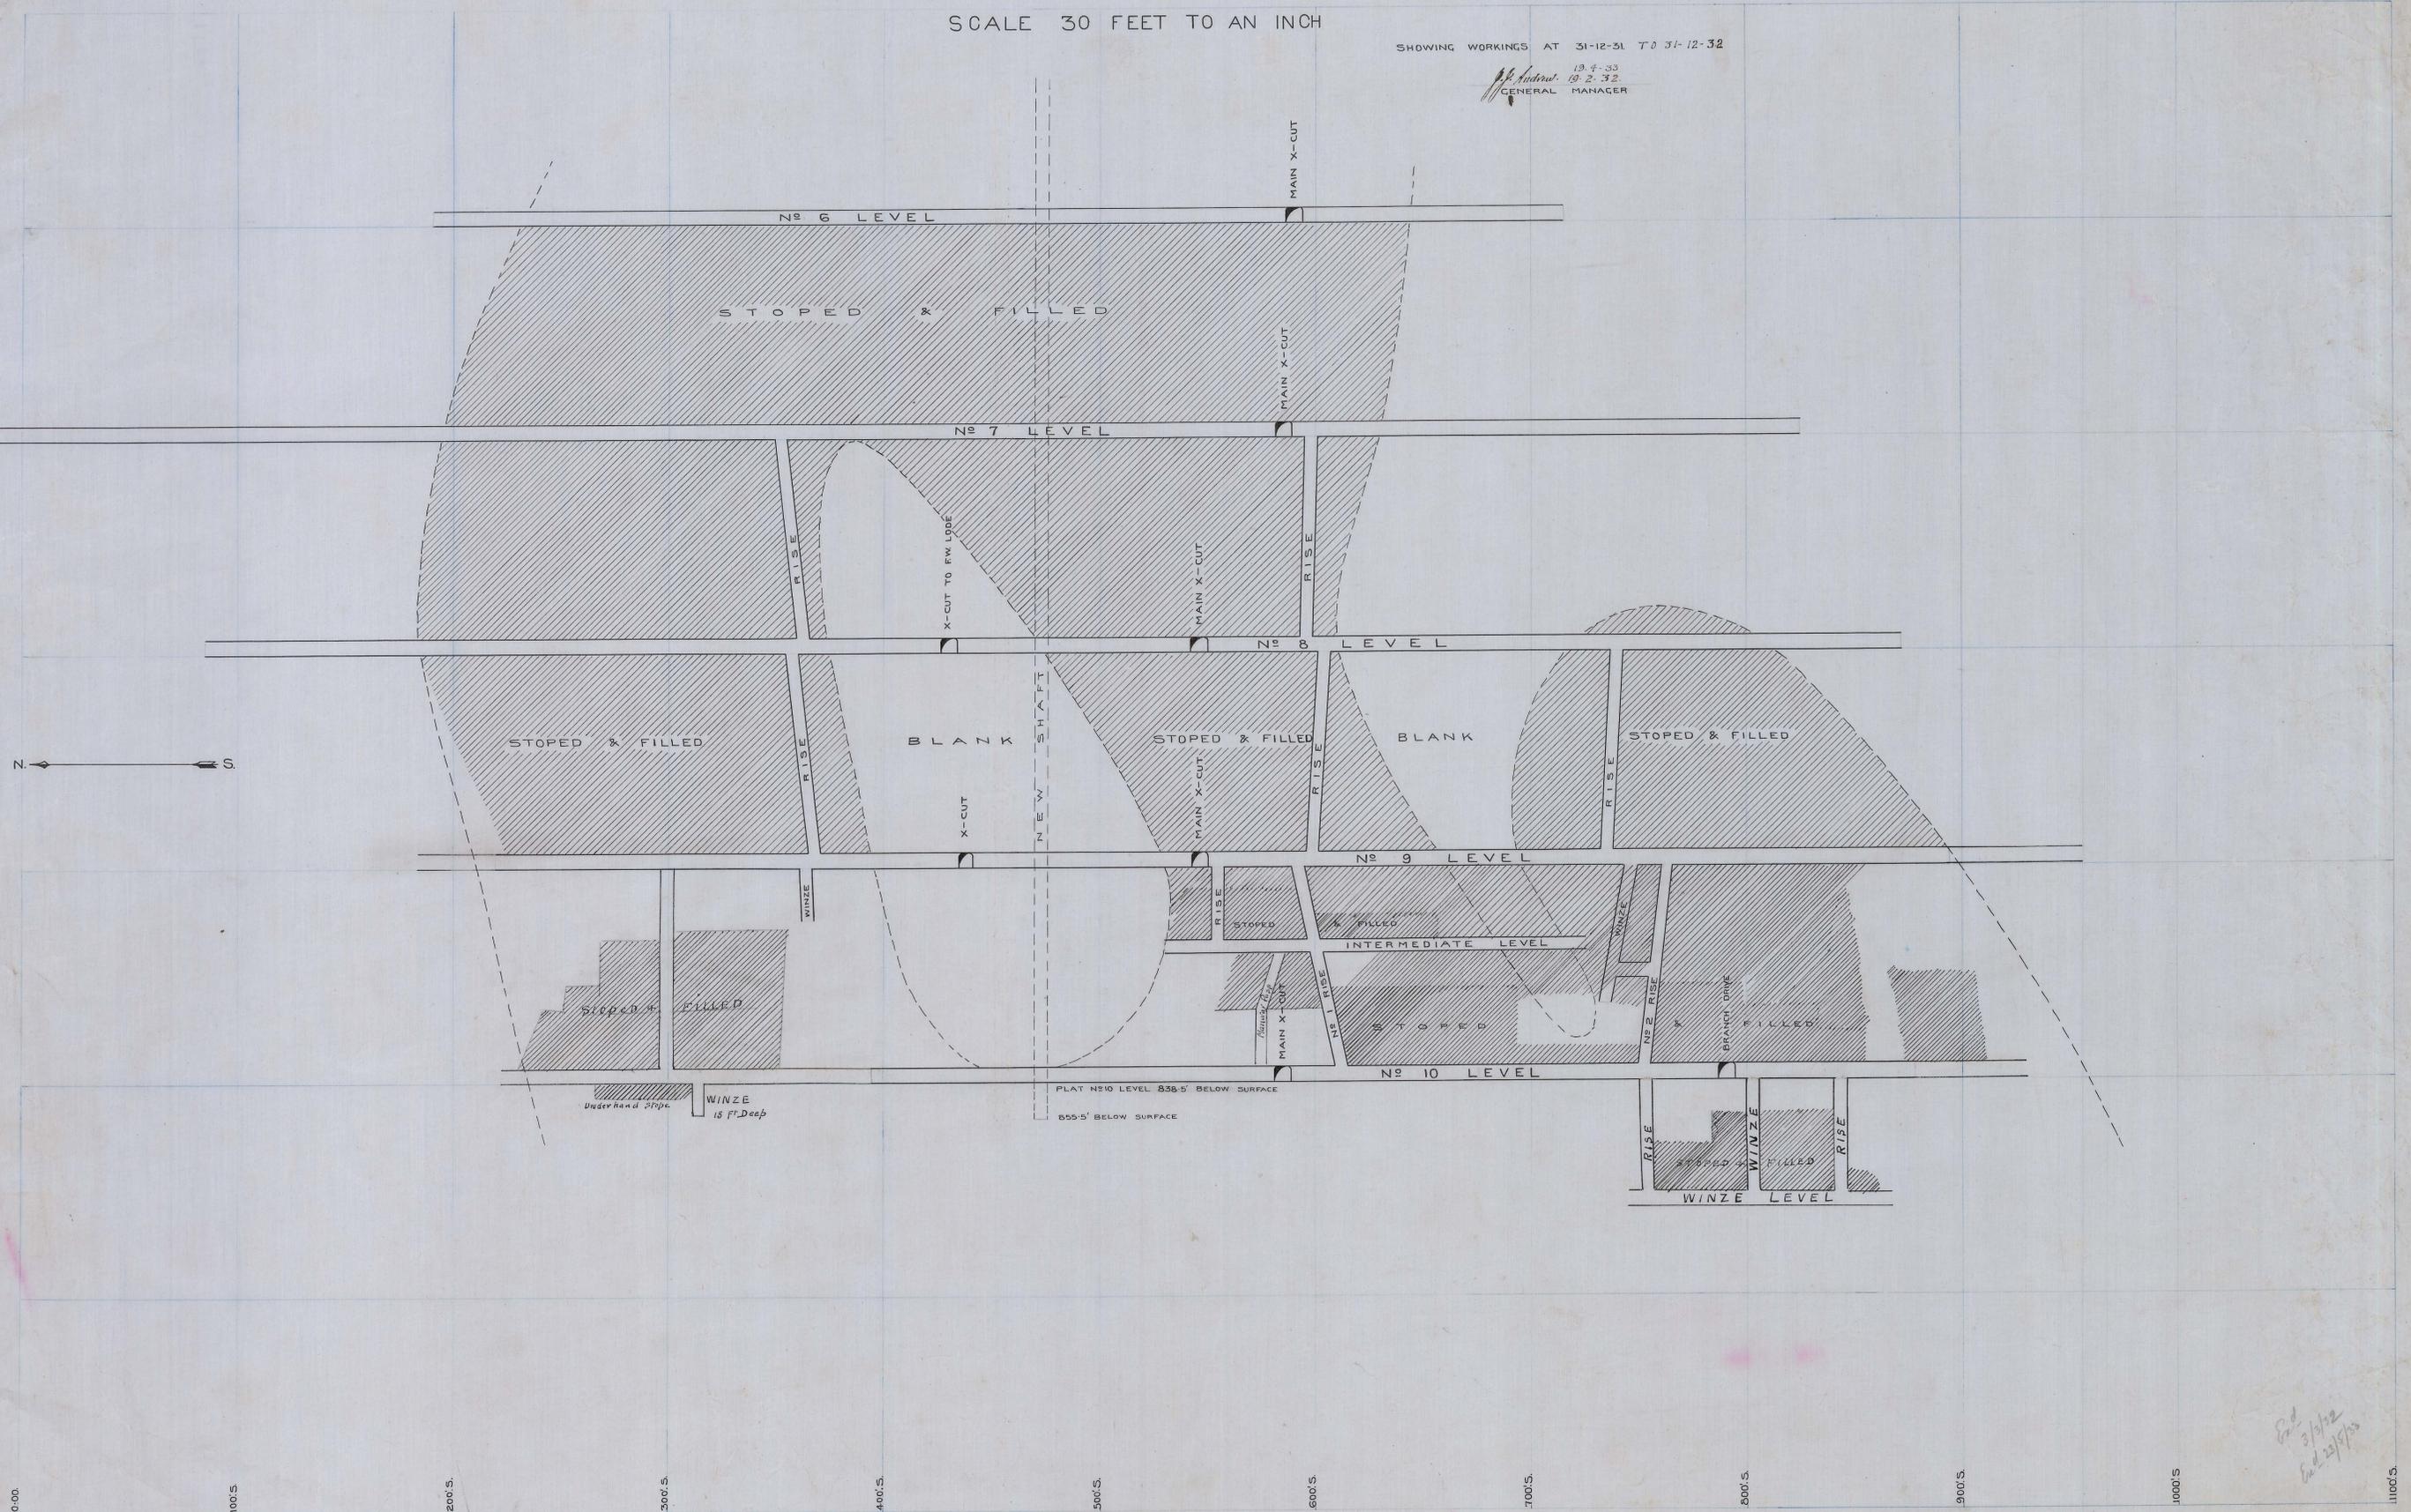

End
3/3/32
End 29/3/33