


*The Murchison River Silver & Lead M.C.N.L.*  
**PLAN OF**  
*Underground Workings*  
*Scales 25 Feet 1 inch.*

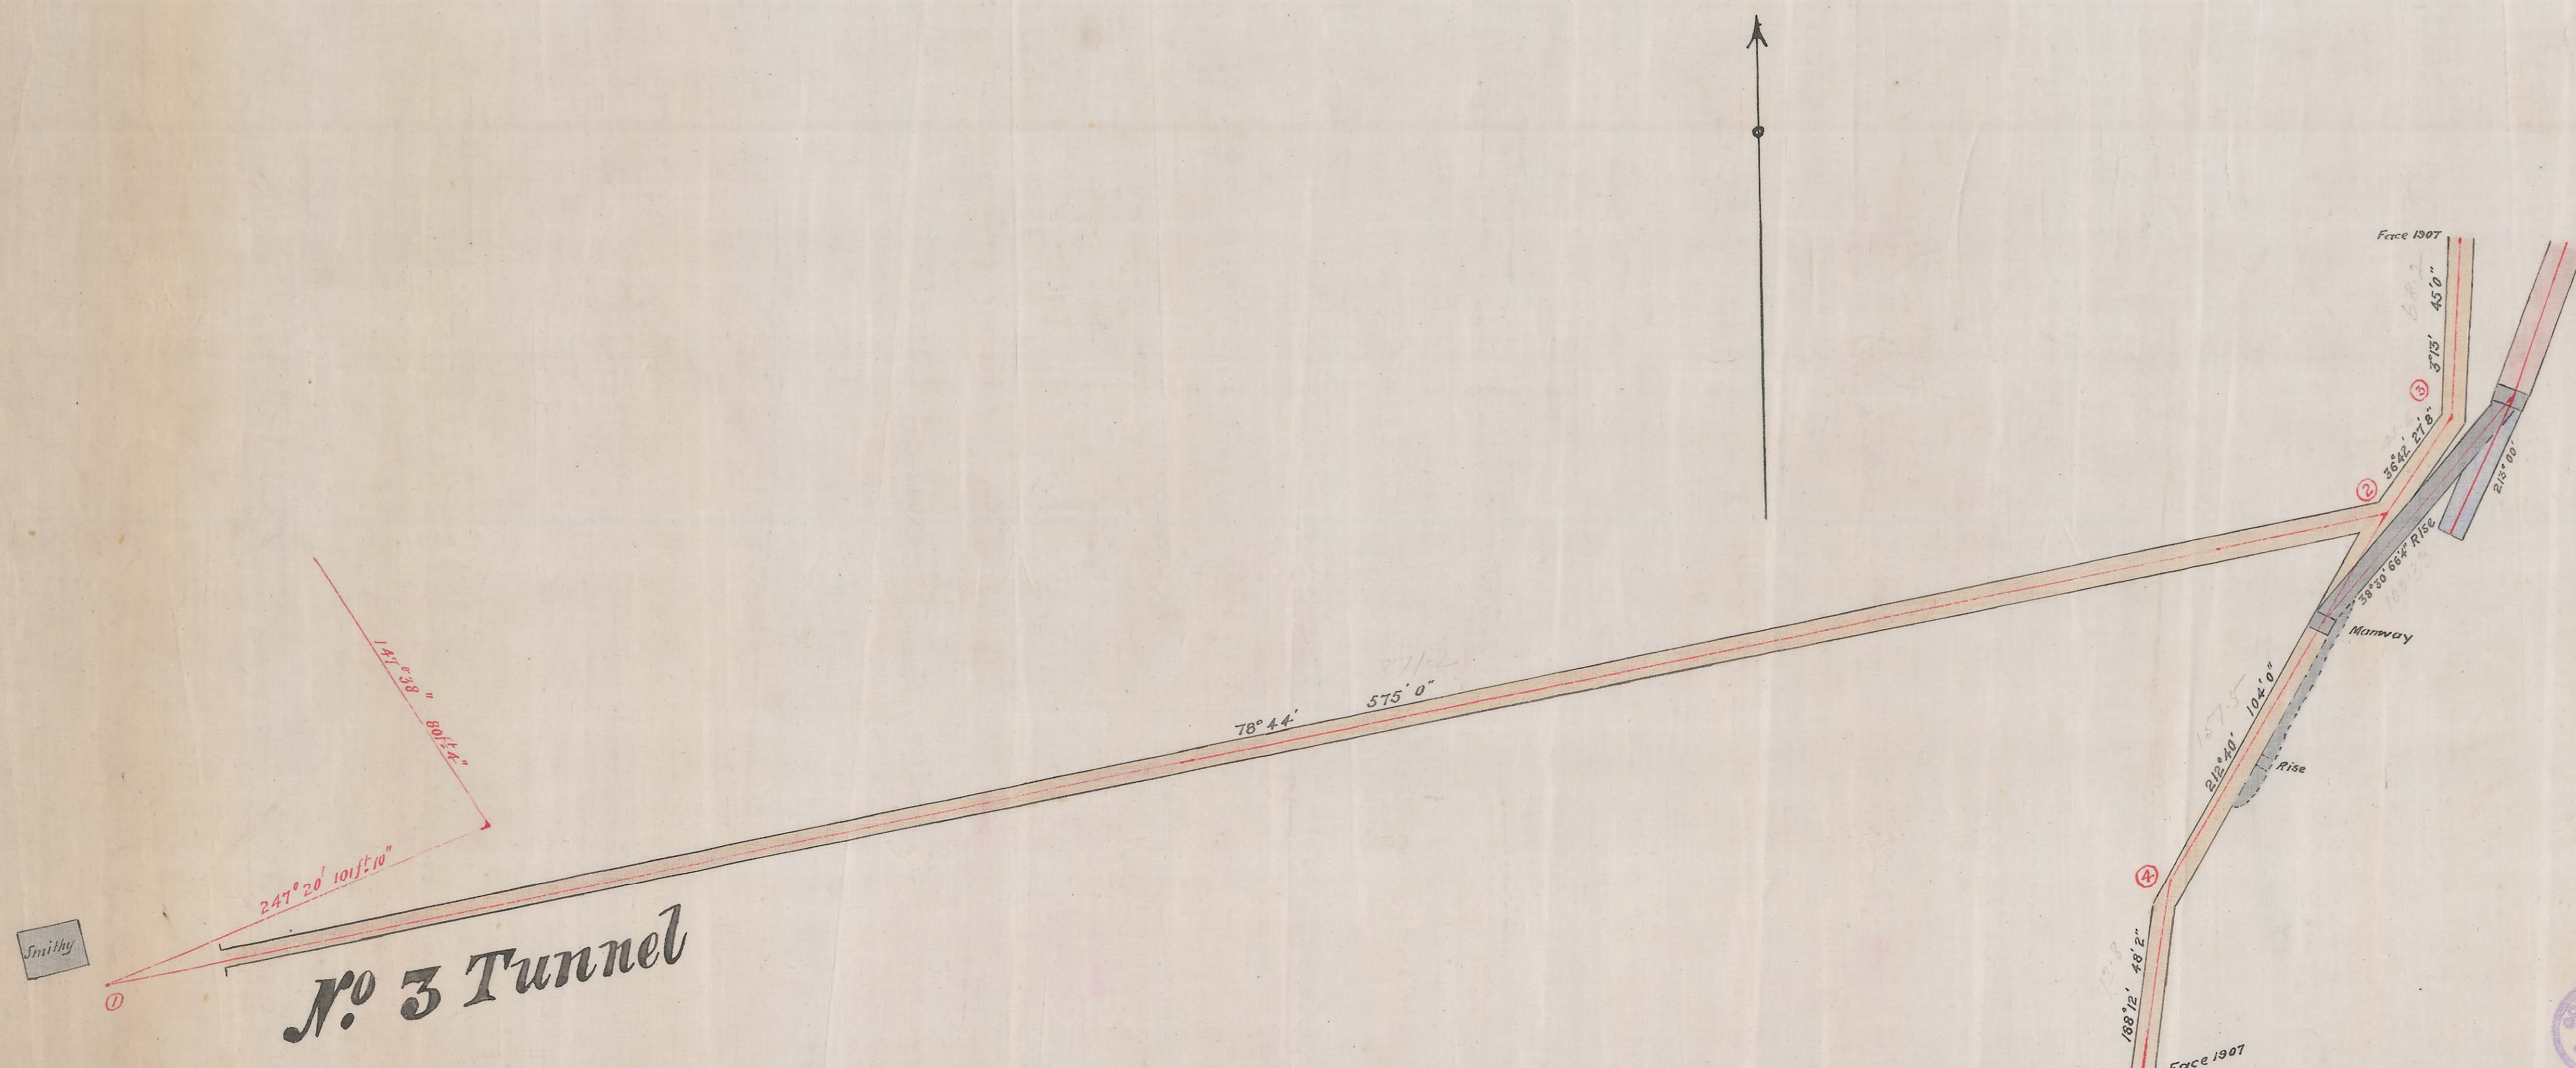

Survey to 22 March 1907

*W. H. Smith & Co.*