
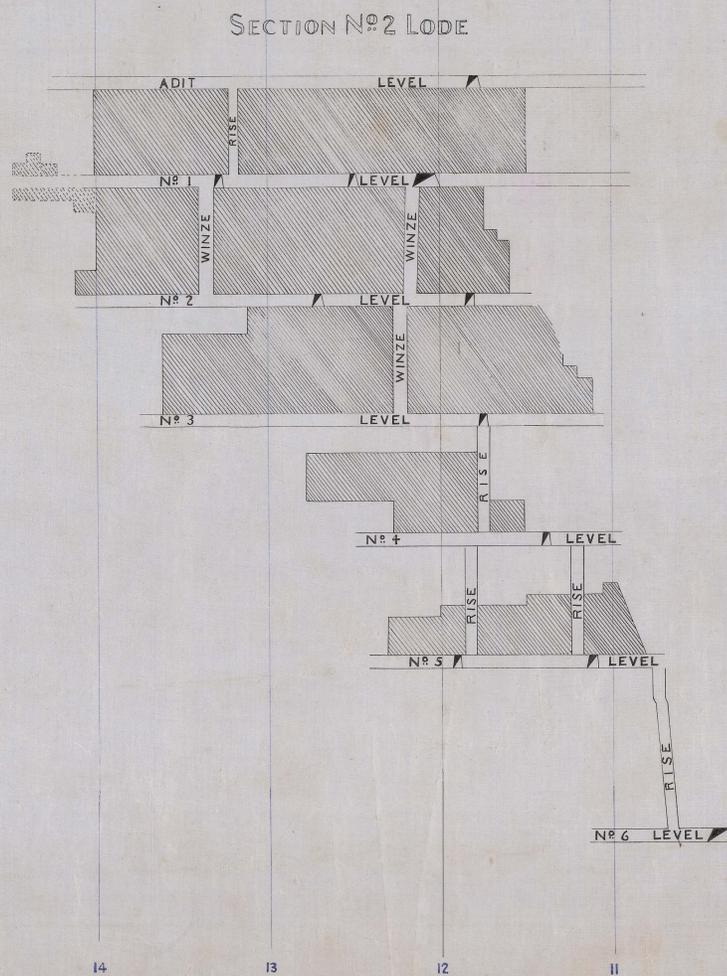
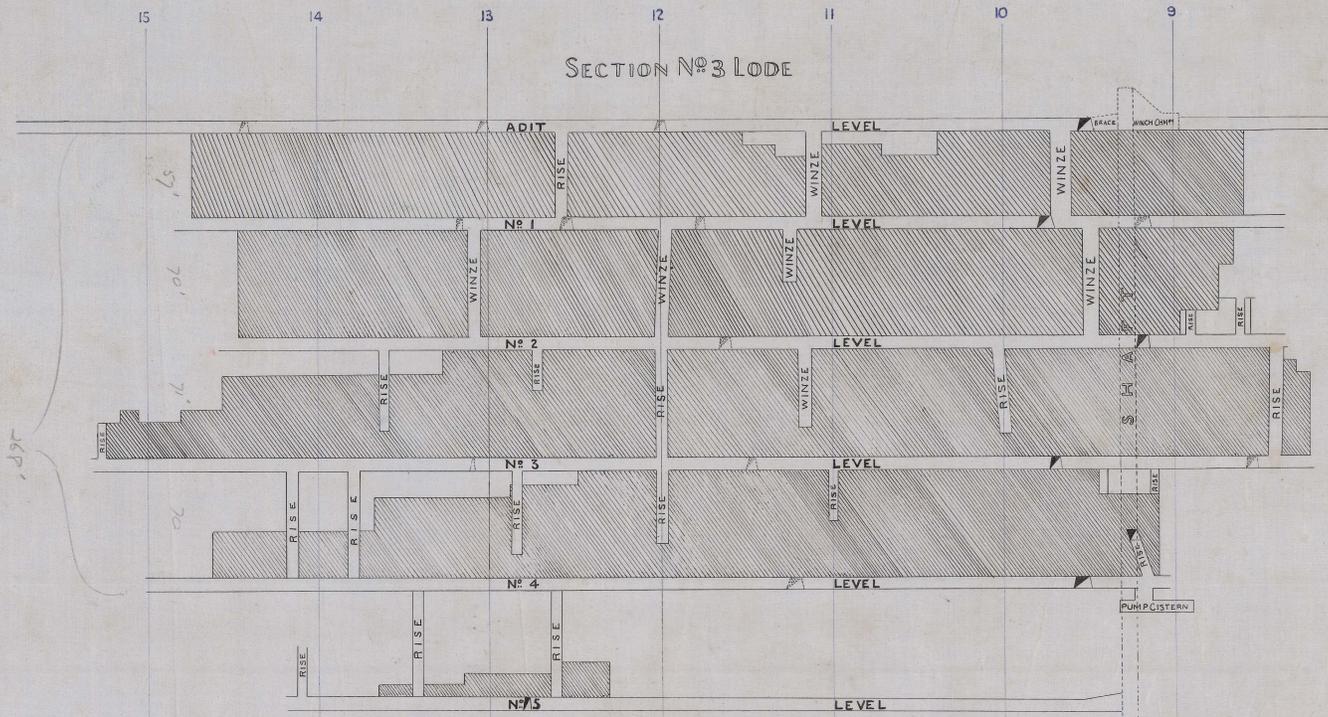
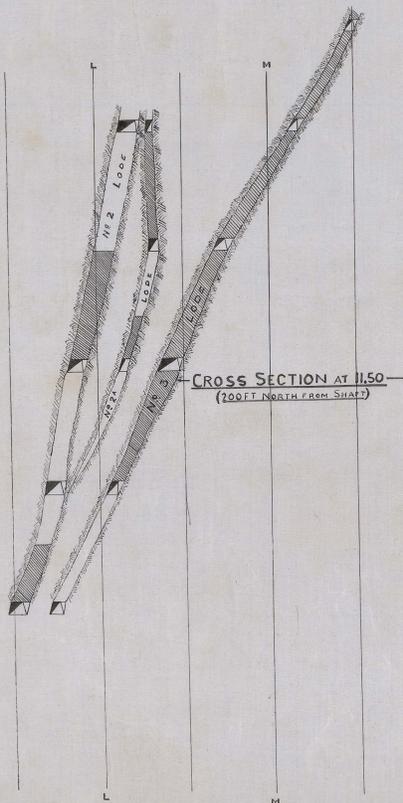


NORTH MOUNT FARRELL MINING CO N.L.

LONGITUDINAL SECTION OF SHAFT LEVELS

SCALE 40 FEET TO AN INCH

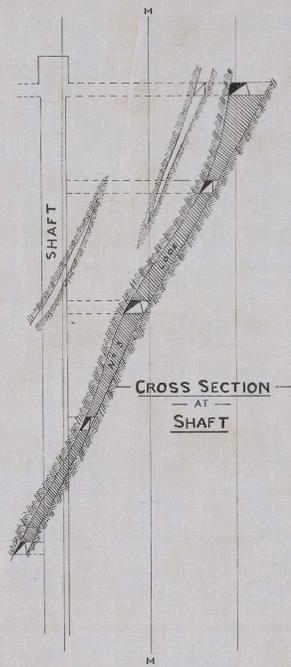

NOTE
GROUND STOPPED at 28th February 1922 SHEWEN THIS

F. C. Colwell 1922
Mining Engineer

