




MICROFILMED

DEPARTMENT OF MINES:
 BROUGHT TO DATE: 31.12.75
 MINE MANAGER: *[Signature]*
 MINE SURVEYOR: *[Signature]*

0352-024

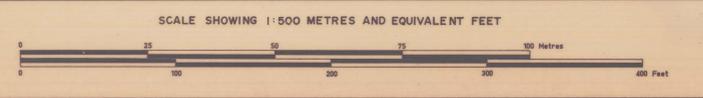

ELECTROLYTIC ZINC COMPANY OF AUSTRALASIA LIMITED
 WEST COAST MINES, T.A.S.

SURVEY BY	SCALE	1:500
DRAWN BY	DATE	1975
TRACED BY	REFERENCE	

FARRELL MINE
 No 10 LEVEL (2)

DRAWING N^o:
 ① ②
 76011

0352-024