


0352-029

MICROFILMED

DEPARTMENT OF MINES:
 BROUGHT TO DATE: 31.12.75
 MINE MANAGER: *[Signature]*
 MINE SURVEYOR: *[Signature]*

0352-029

5m

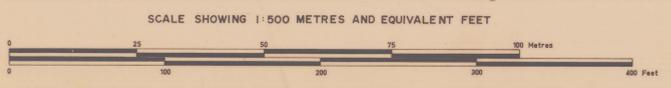

ELECTROLYTIC ZINC COMPANY OF AUSTRALASIA LIMITED
 WEST COAST MINES, T.A.S.

SURVEY BY		SCALE	1:500
DRAWN BY		DATE	1975
TRACED BY	I.T. Moore.	REFERENCE	

FARRELL MINE
 No 8 LEVEL (1)

DRAWING No: 2
 76006