


0352-031

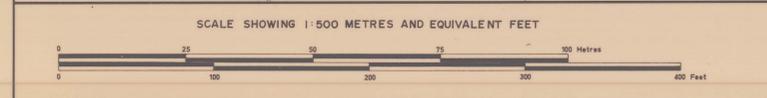

ELECTROLYTIC ZINC COMPANY OF AUSTRALASIA LIMITED  
WEST COAST MINES, T.A.S.

SURVEY BY	SCALE	1:500
DRAWN BY	DATE	1975
TRACED BY	REFERENCE	

0352-031

FARRELL MINE  
Nº 6 LEVEL (2)

DEPARTMENT OF MINES  
BROUGHT TO DATE: 31.12.75  
MINE MANAGER: *[Signature]*  
MINE SURVEYOR: *[Signature]*

DRAWING Nº: ① ②  
76003