


MICROFILMED

MICROFILMED

DEPARTMENT OF MINES:
 BROUGHT TO DATE: 31.12.75
 MINE MANAGER: *[Signature]*
 MINE SURVEYOR: *[Signature]*

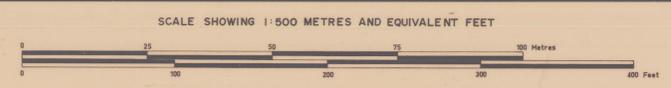

ELECTROLYTIC ZINC COMPANY OF AUSTRALASIA LIMITED
 WEST COAST MINES, TAS.

SURVEY BY		SCALE	1:500
DRAWN BY		DATE	1975
TRACED BY	I.T. Moore	REFERENCE	

032-032

FARRELL MINE
 No 6 LEVEL (1)

DRAWING No.: (2) 76002

032-032