

0352-032


MICROFILMED
1975

BROUGHT TO DATE: 31.12.75

MINE MANAGER: *[Signature]*
MINE SURVEYOR: *[Signature]*

5 cm

0352-032

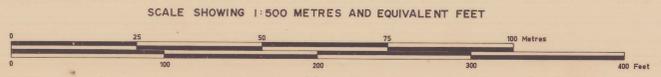

ELECTROLYTIC ZINC COMPANY OF AUSTRALASIA LIMITED
WEST COAST MINES, T.A.S.

SURVEY BY		SCALE	1 : 500
DRAWN BY		DATE	1973
TRACED BY	P. J. Lowe	REFERENCE	

FARRELL MINE
LONGITUDINAL PROJECTION
BELOW 6 LEVEL ONLY

DRAWING N°:
DEPARTMENT OF MINES
76001