
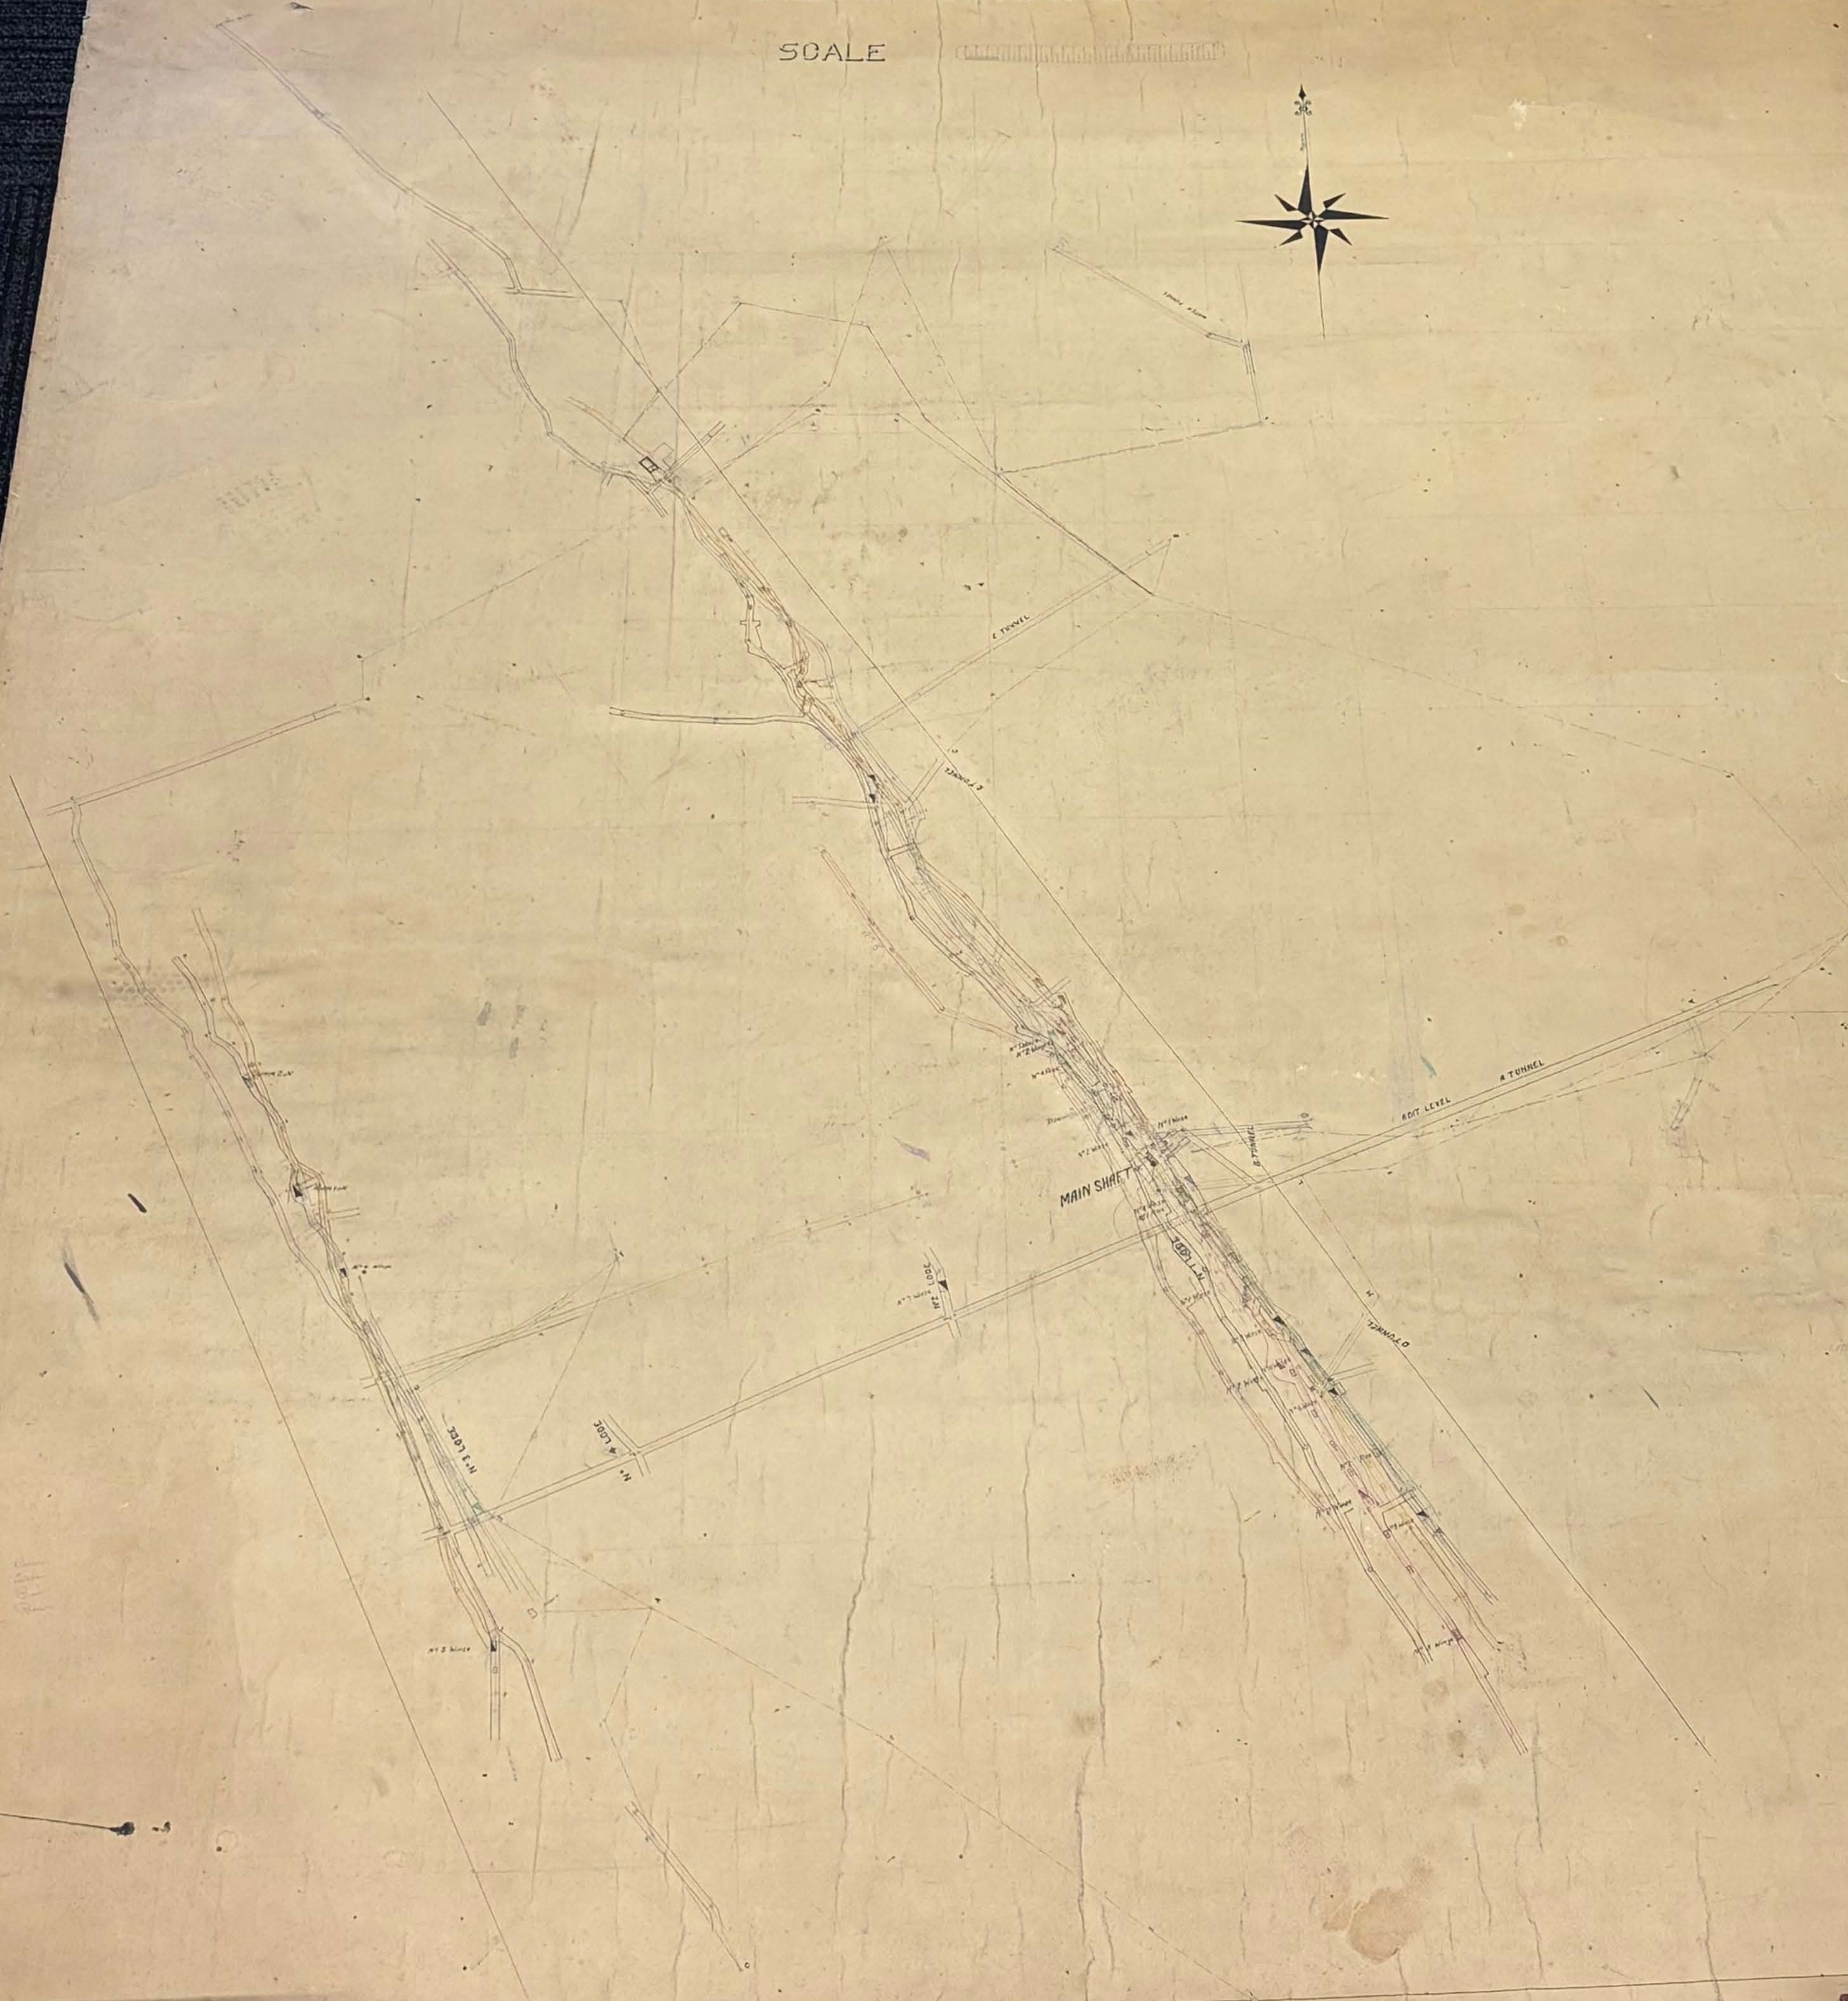


# MT ZEEHAN-TAS-S L MINES LTD

## SILVER SPRAY SECTION

SCALE

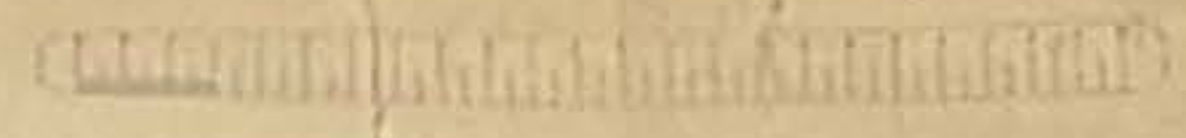

### REFERENCE

ADIT LEVEL  
N°1 DO  
N°2 DO  
N°3 DO

TUNNEL  
A DO  
B DO  
C DO  
D DO  
E DO  
F DO  
G DO