
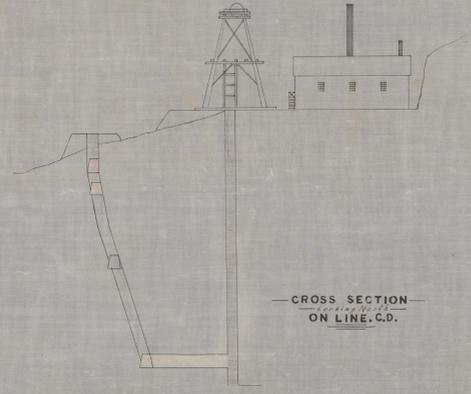


# G R U B B S S M COY.

ZEEHAN  
PLAN AND SECTIONS  
OF  
MINE AND WORKINGS

NUBENA  
S M C

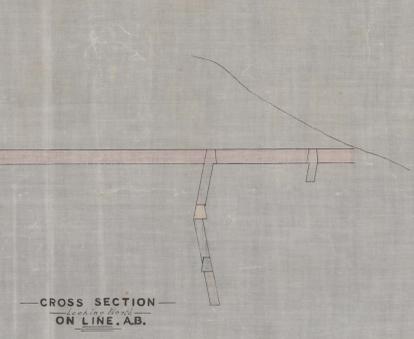

- Reference
- TUNNELS
  - SHAFTS & WINZES
  - NO INTERMEDIATE
  - MAIN INTERMEDIATE
  - 150 FEET LEVEL
  - STOPPED PRIOR TO 18 SEPT 1892.
  - STOPPED SINCE 18 SEPT 1892.

*Drawn for  
No. 1000  
G. R. U. B. B. S. M. Co. 1892*