


354
02

354
02

*Copy
for
Mines Dept.*

March 14th
1894

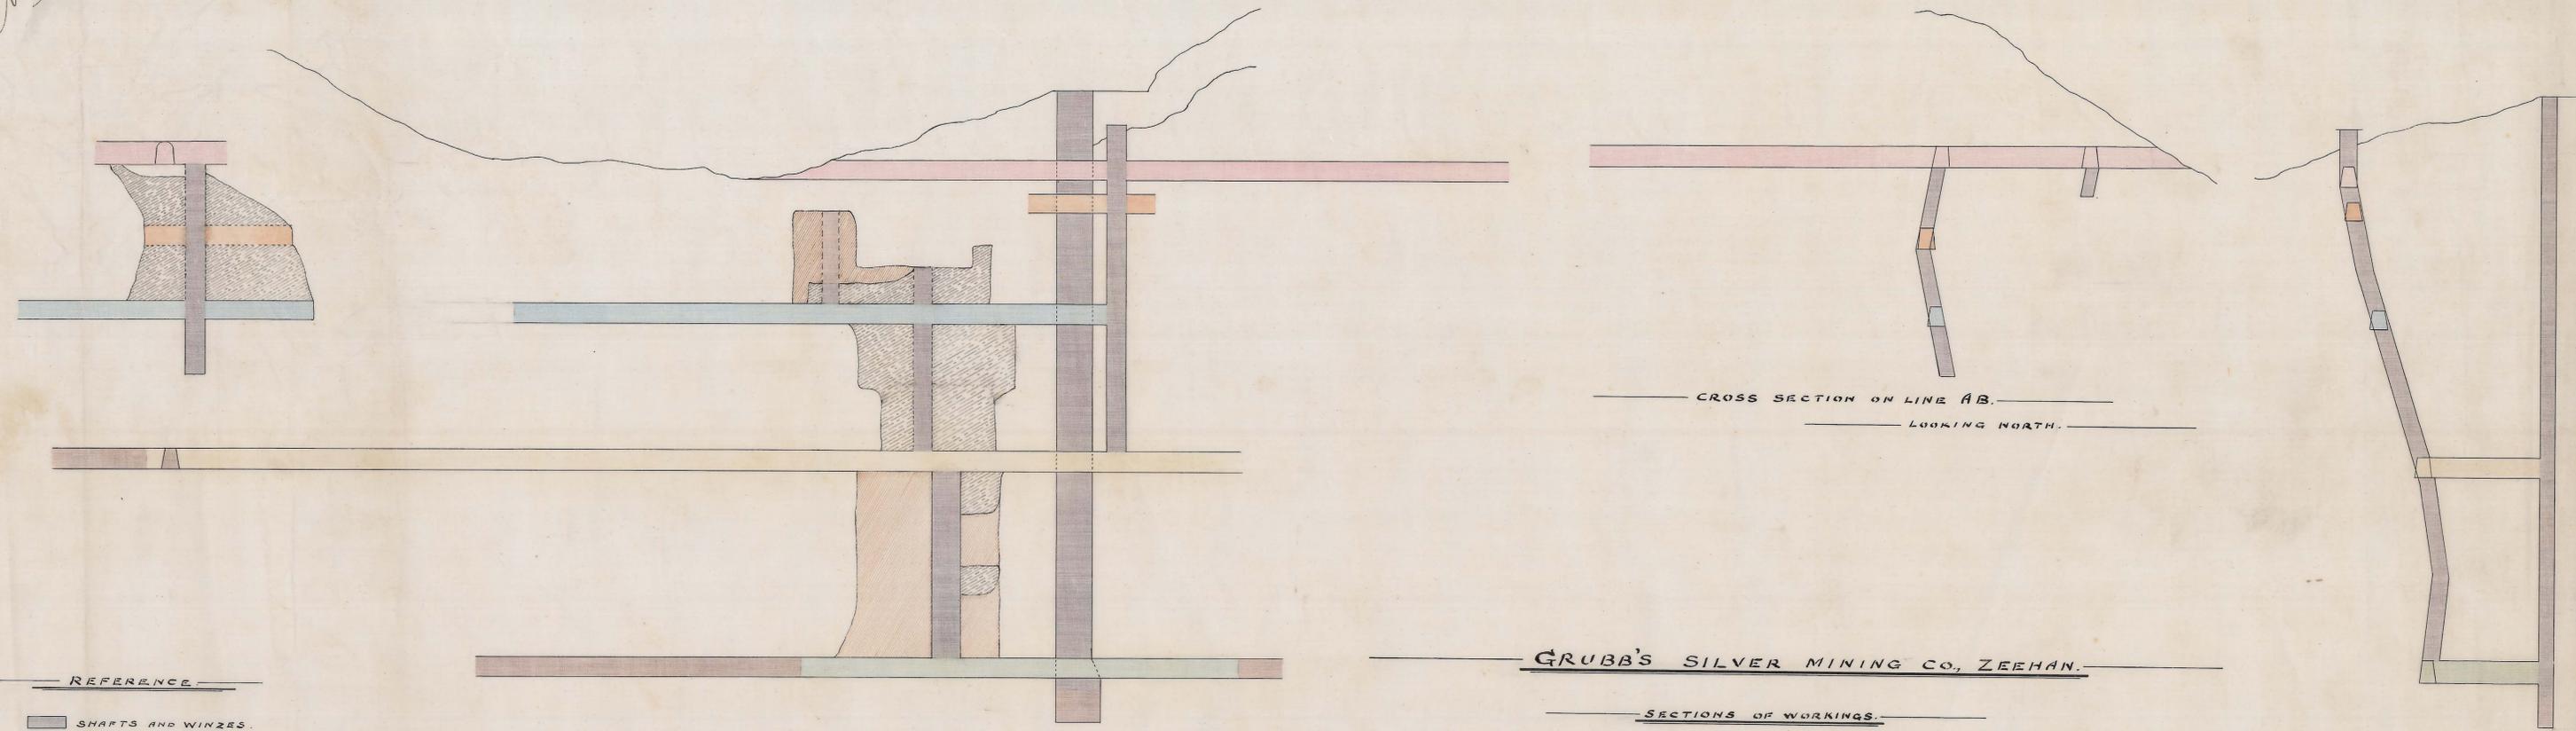

REFERENCE

- SHAFTS AND WINZES.
- TUNNELS.
- NO. 1. INTERMEDIATE LEVEL.
- MAIN INTERMEDIATE LEVEL.
- 130 FEET LEVEL.
- 200 FEET LEVEL.
- STOPPED BEFORE 18th AUG. 1893.
- STOPPED HALF-YEAR ENDING 18th FEB. 1894.
- WORK (OTHER THAN STOPPING) DONE HALF-YEAR ENDING 18th FEB. 1894.

GRUBB'S SILVER MINING CO., ZEEHAN.

SECTIONS OF WORKINGS.

SCALE - 25 FEET TO AN INCH.

CROSS SECTION ON LINE CD.

LOOKING NORTH.

*John Woolcock, M.A. & Co.
Mines Managers
1894*

5 cm