
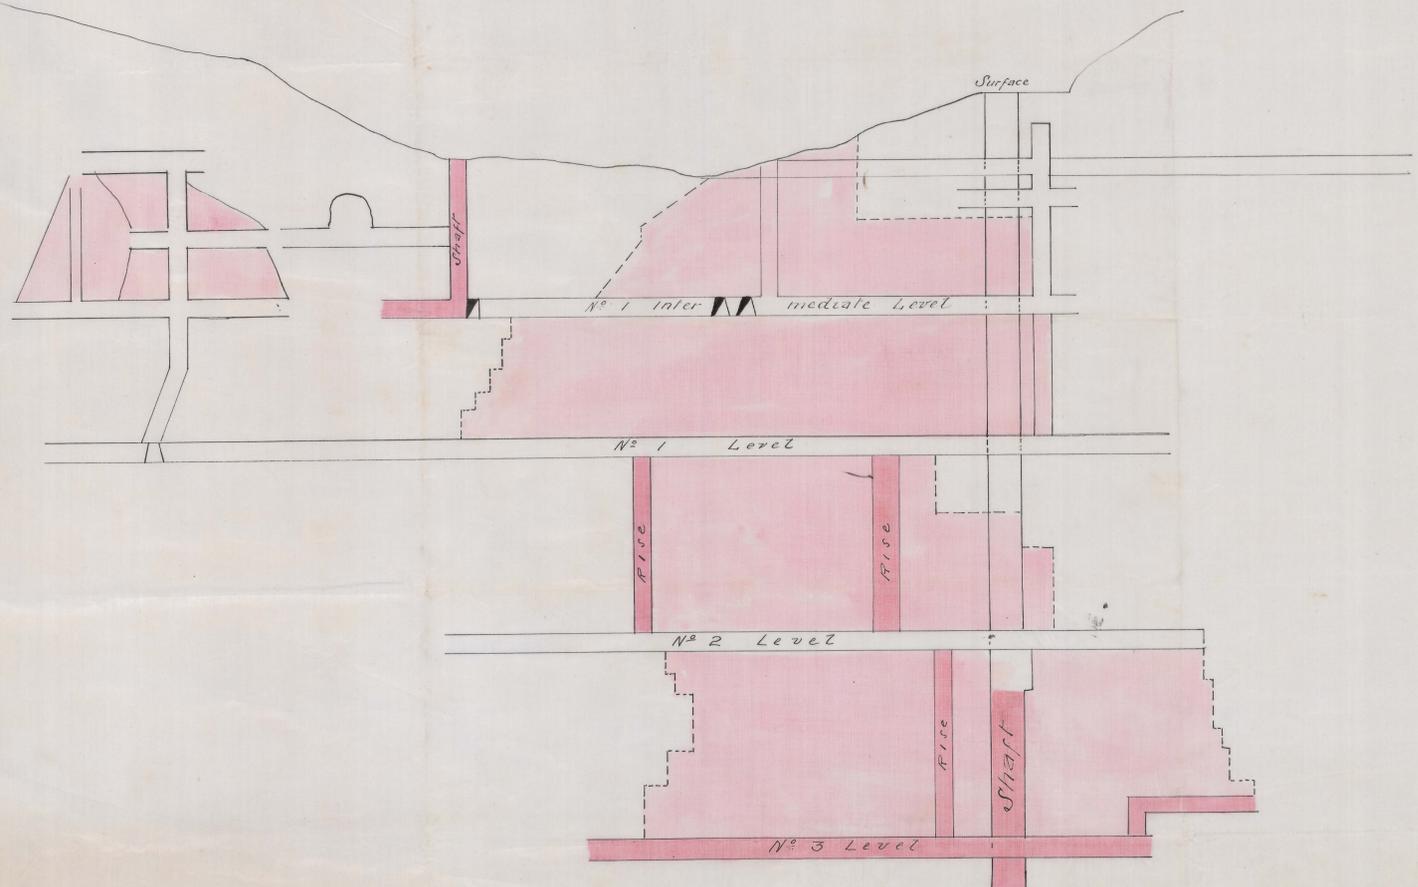


GRUBBS S.M.C.^o

Scale 25 ft to an Inch

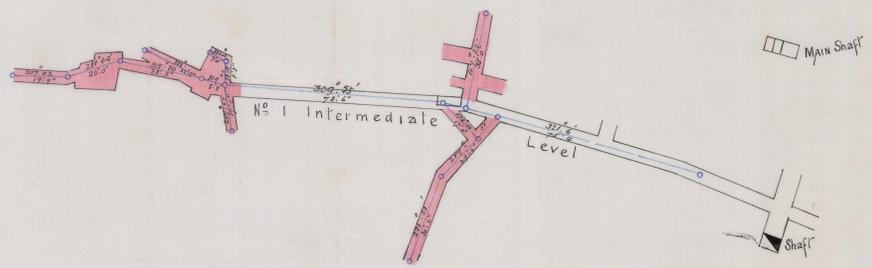

Reference.
 [Pink box] Sinking, Raising & Driving done From Feb'y 18th 94 to Jan'y 7th 98
 [Lighter pink box] Stopping " " " " " "