

354
04

354
04

5 cm

copy
for
Bureau Dept


GRUBB'S SILVER MINING CO., ZEEHAN.

PLAN OF WORKINGS.

RECORDED
March 14th
1894
LADROSTON

REFERENCE.

- SHAFTS AND WINZES.
- TUNNELS.
- NO. 1. INTERMEDIATE LEVEL.
- MAIN INTERMEDIATE LEVEL.
- 130 FEET LEVEL.
- 200 FEET LEVEL.
- WORK DONE HALF-YEAR ENDING 16th FEB. 1894.

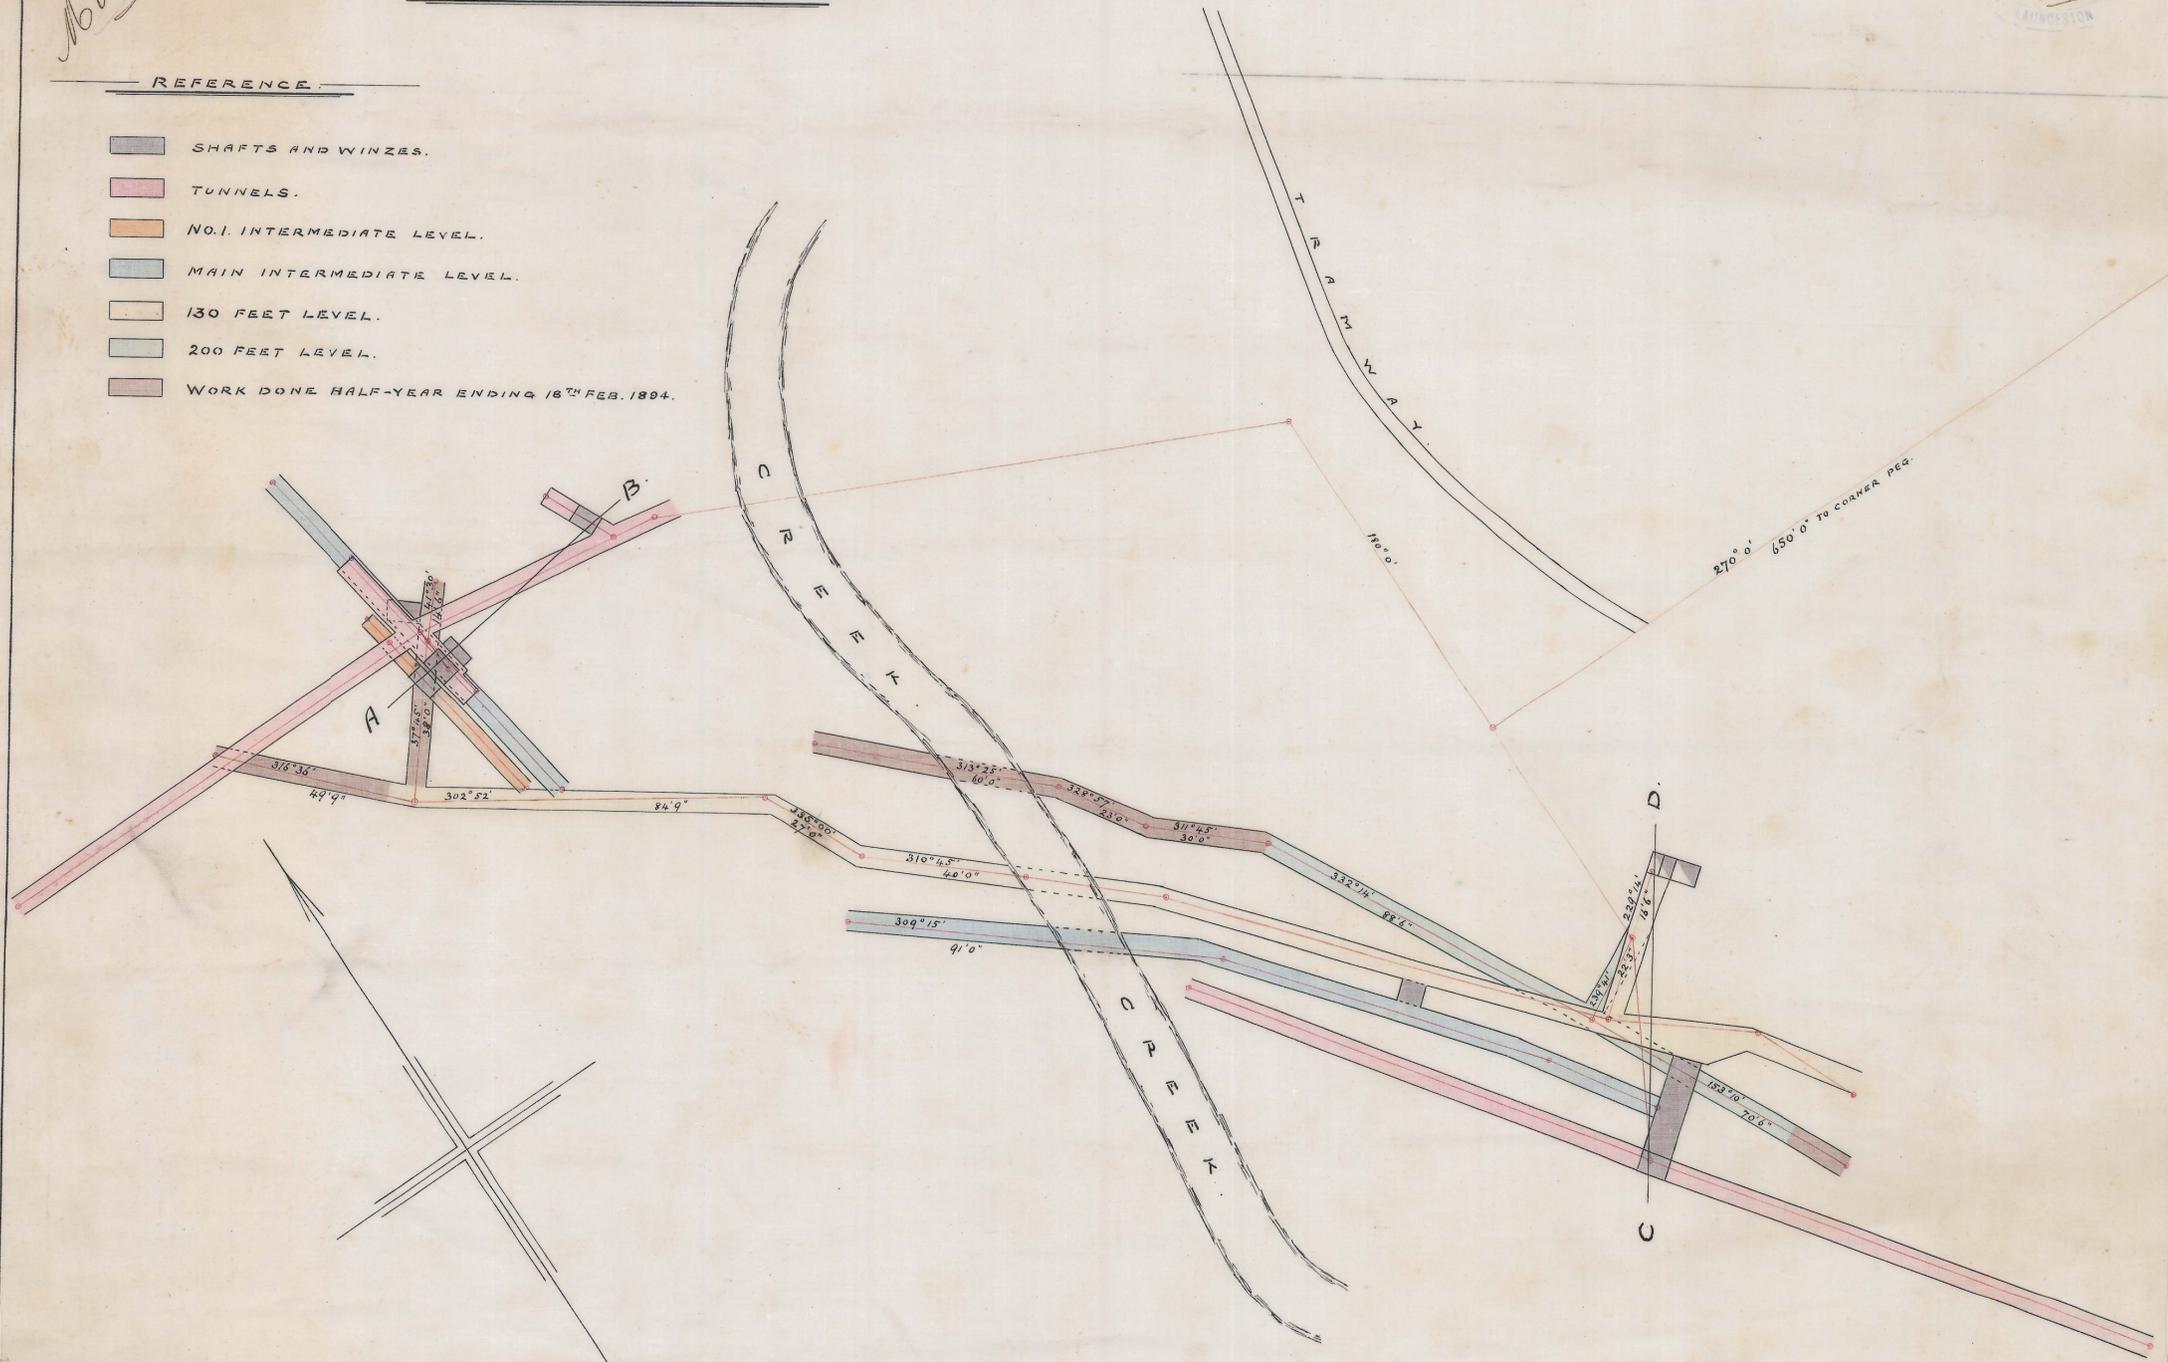

SCALE 25 FEET TO AN INCH.

John Wallace M.A. M.E.
Bureau Manager