

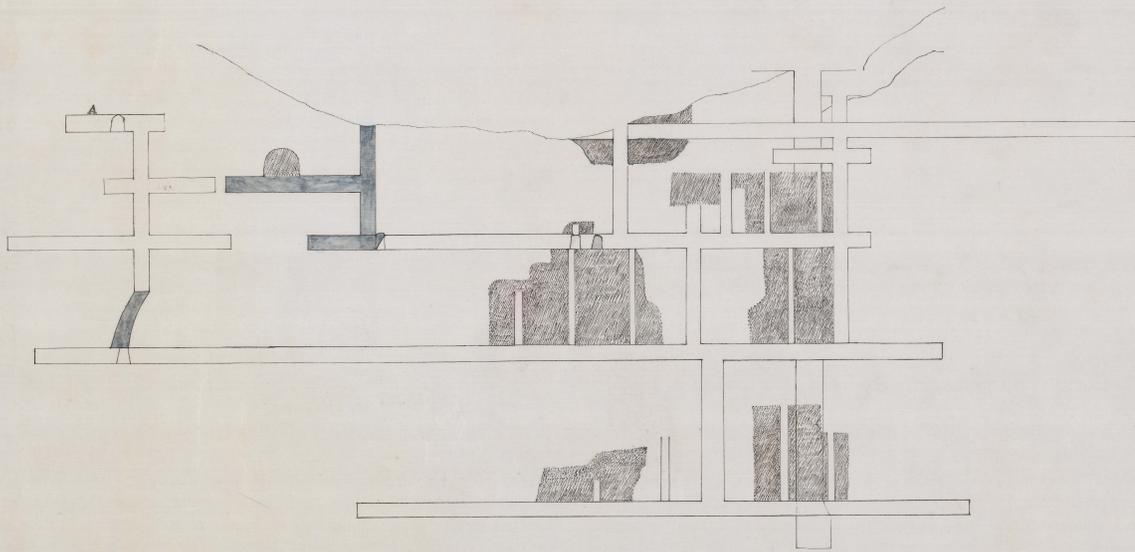


G R U B B S . S . M . C

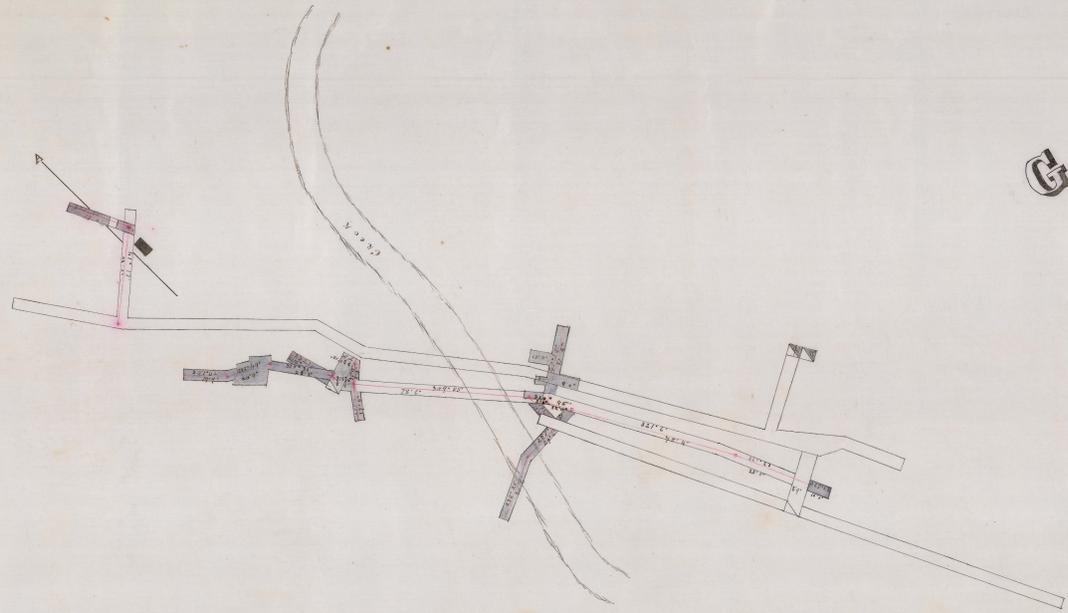

LONGITUDINAL SECTION

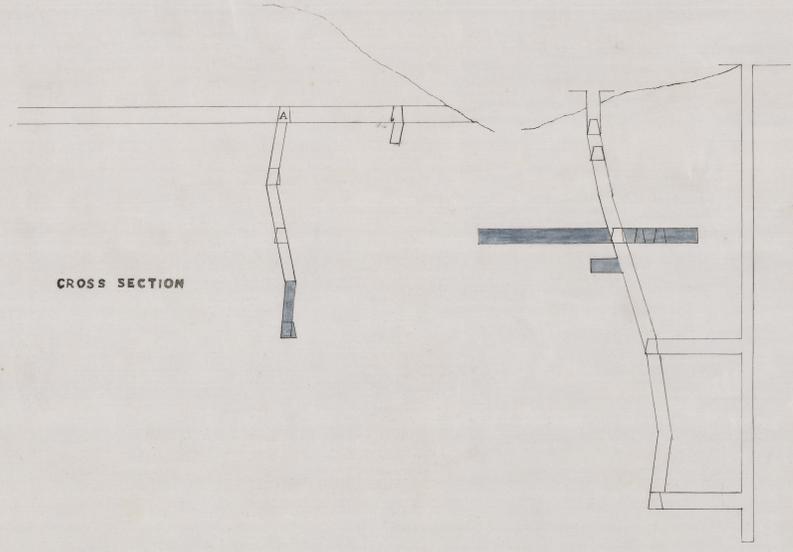

Scale 25 Feet to one Inch

Reference

- Brown and Blinn 1894
- Ore Stopped during 1894
- Storage and Ore Passes
- A line 10' 32" west of South level as 360' in survey to connect N° 1 level with the Western Storage. This line is in the centre of a level which crosses the Western Tunnel.

Survey and Plan made by
 Luke Williams
 Mining Manager
 Grubbs Silver Mine
 N^o 3

357
 85