



TILE
VELLUM TRACING CLOTH
Sigsbee Patent
1861 No 122
PERCUSHION WORKS, MANCHESTER

THE COMET S.M. Co.

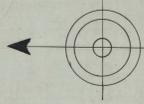

REFERENCE

No	LEVEL
2	
3	
4	

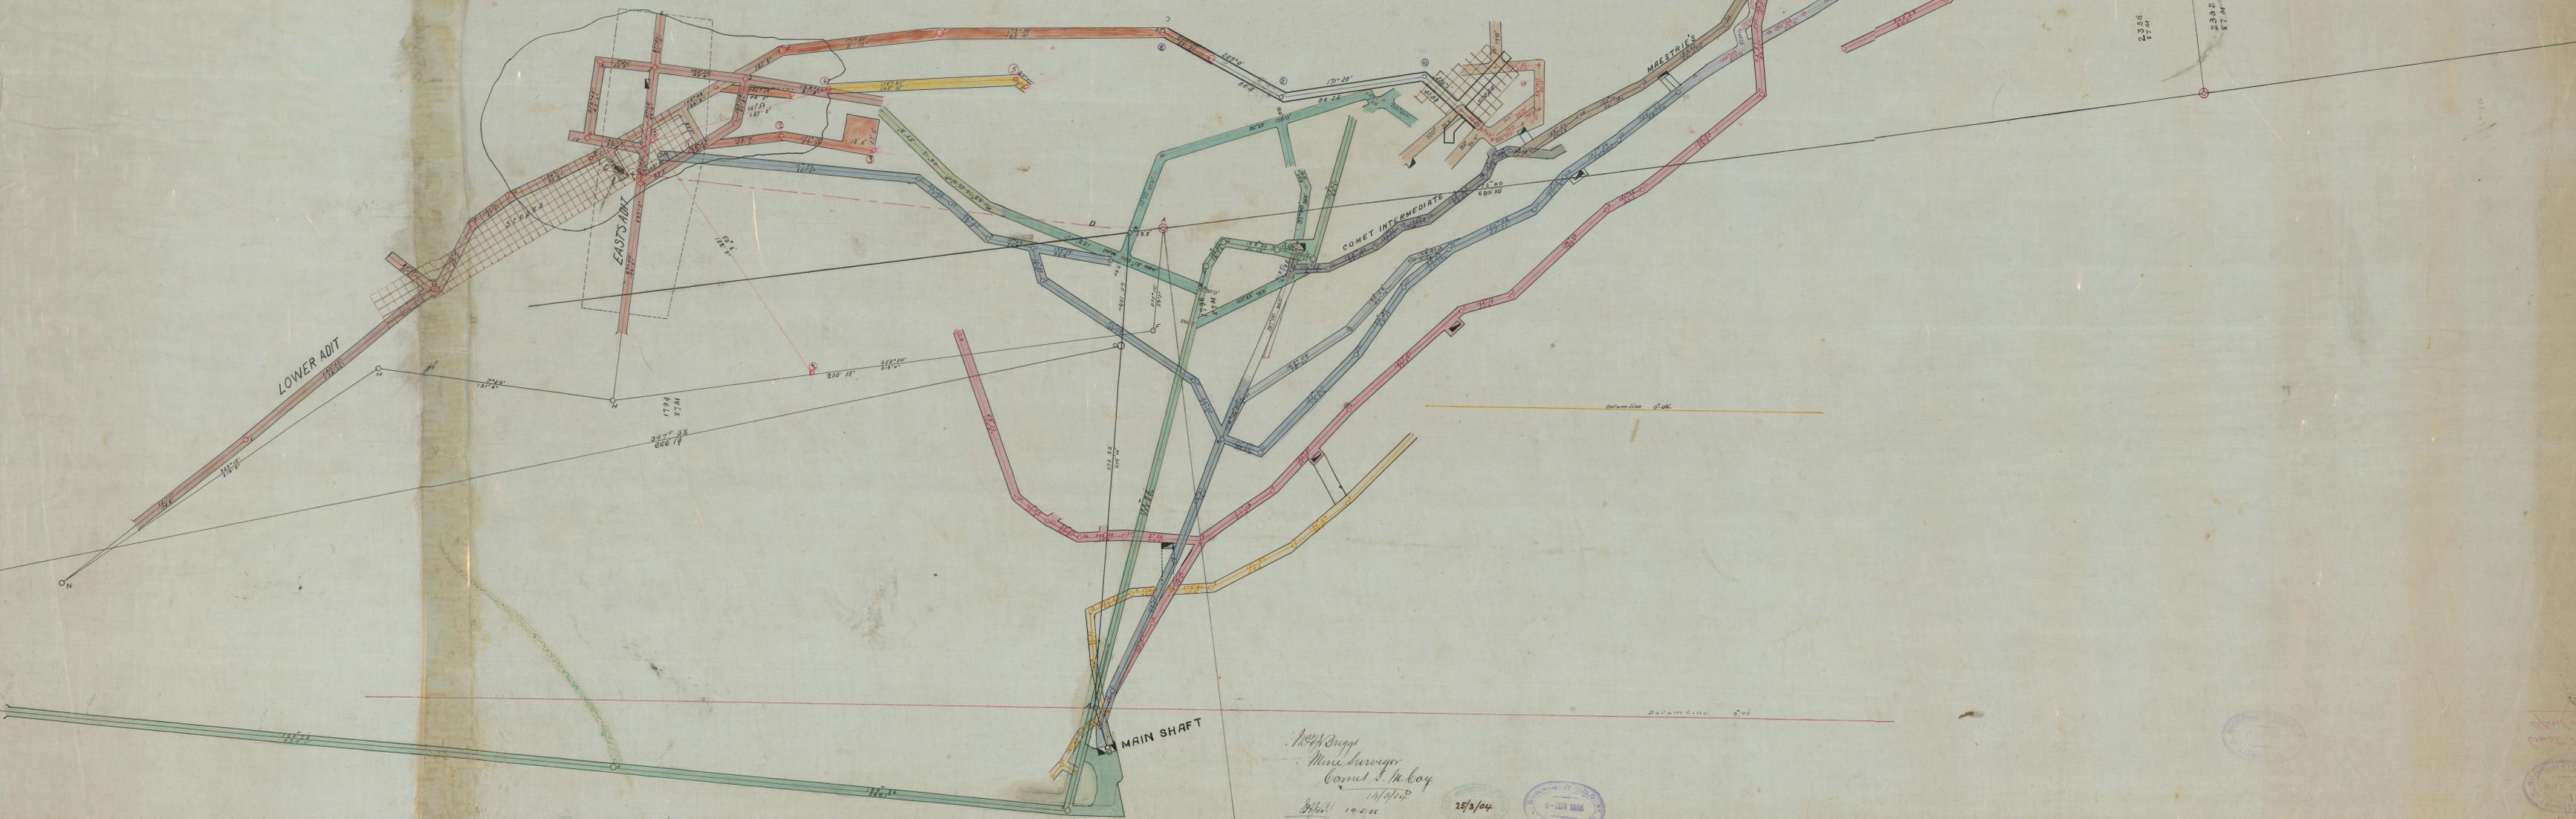

J. H. B. G. G.
 Mine Surveyor
 Comet S. M. Co.
 14/9/07
 25/3/04
 19/5/05
 21/1/06 C. B. 11/1/10
 T.S. 25/9/07 26/3/12
 6-JUN 1906
 138
 1913

138
 138
