
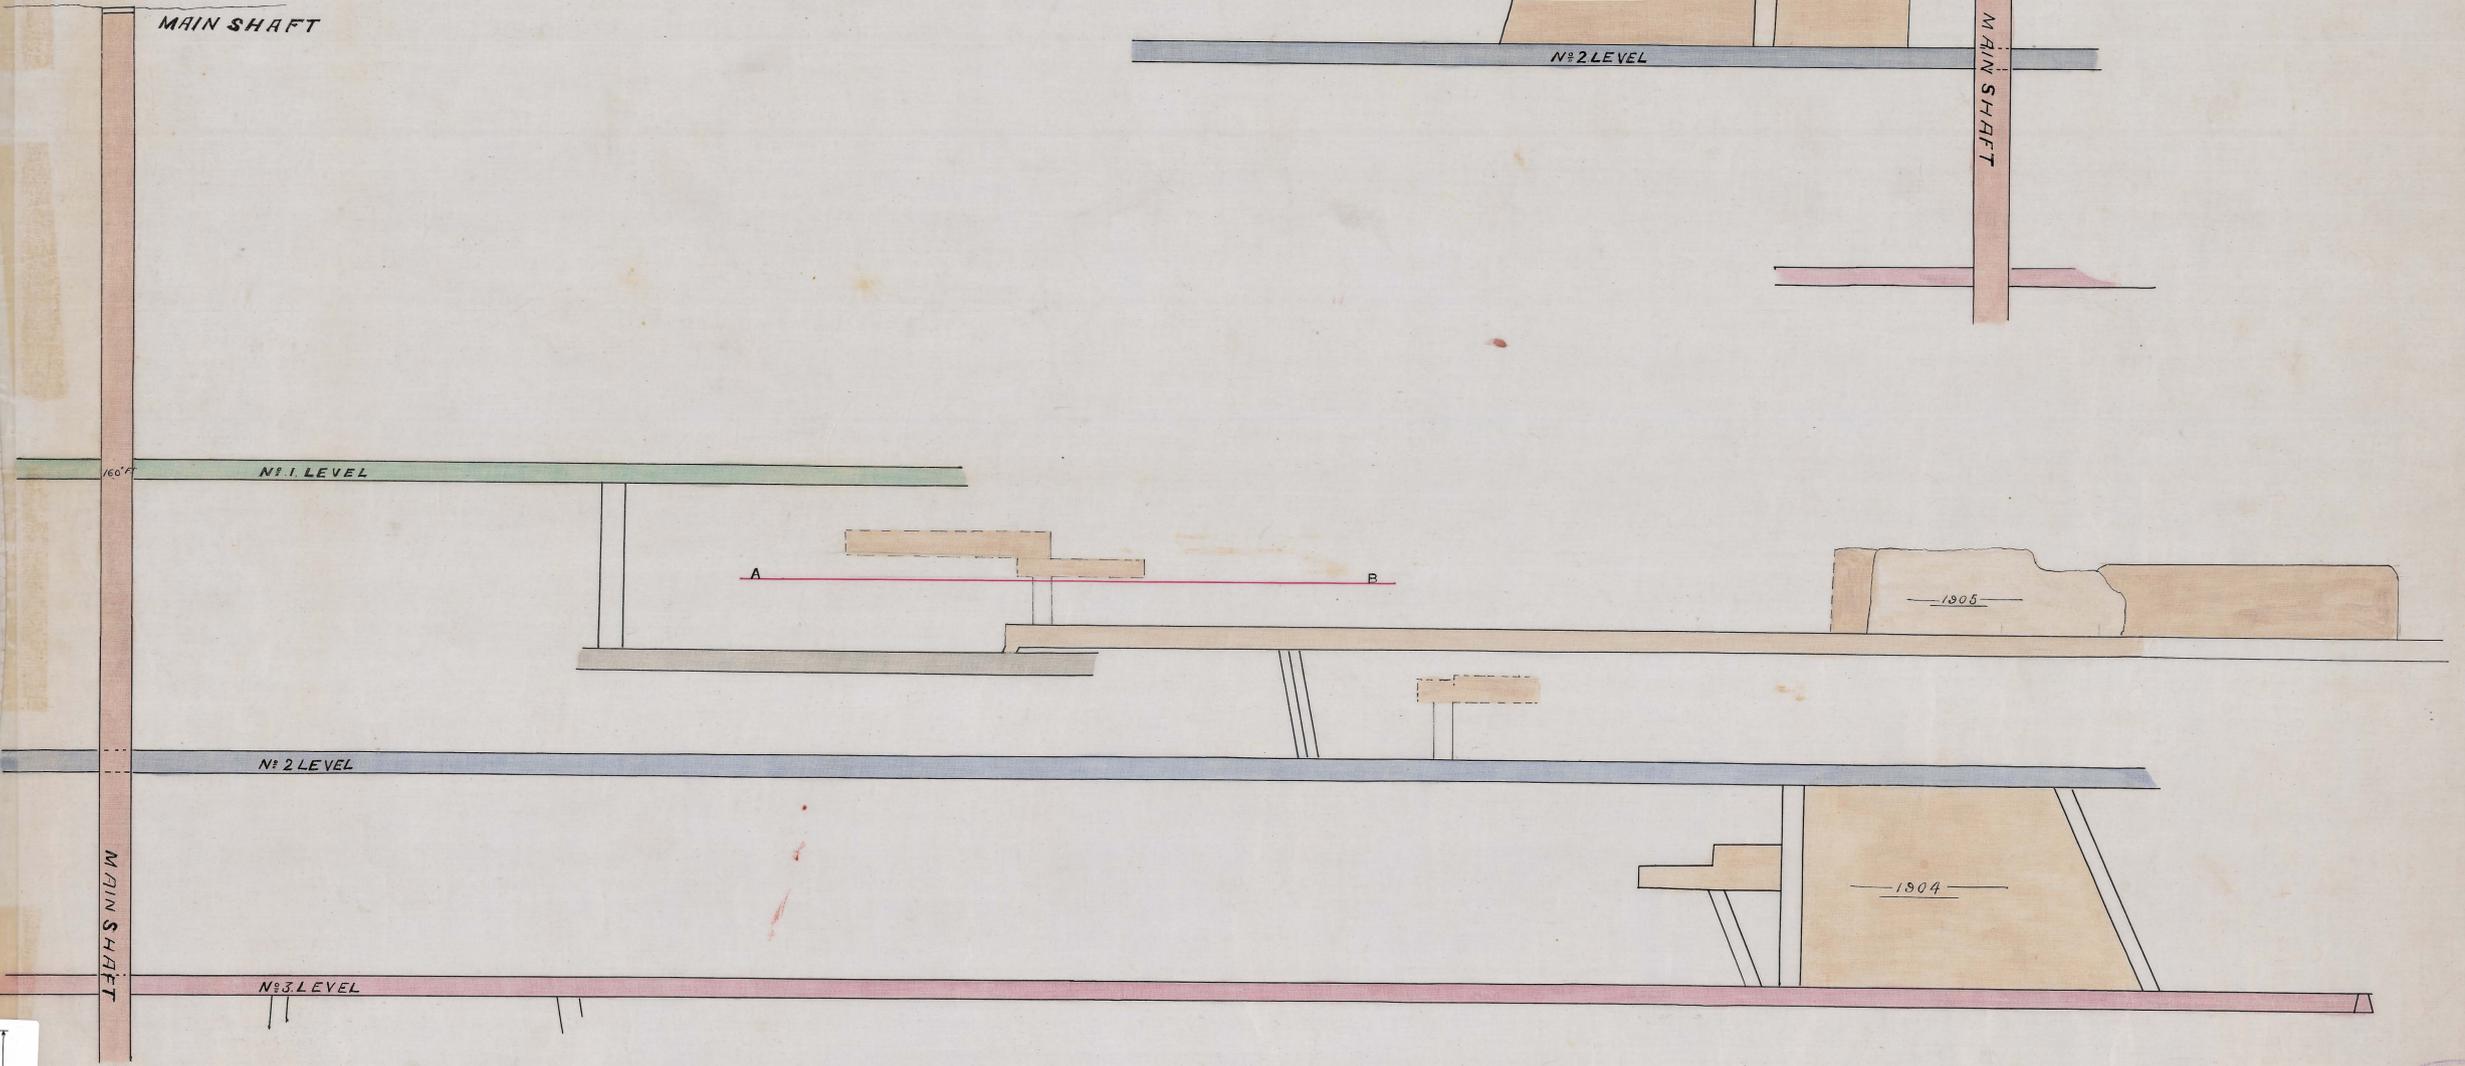


THE COMET S.M.C.

Scale 1 Inch = 25 Feet

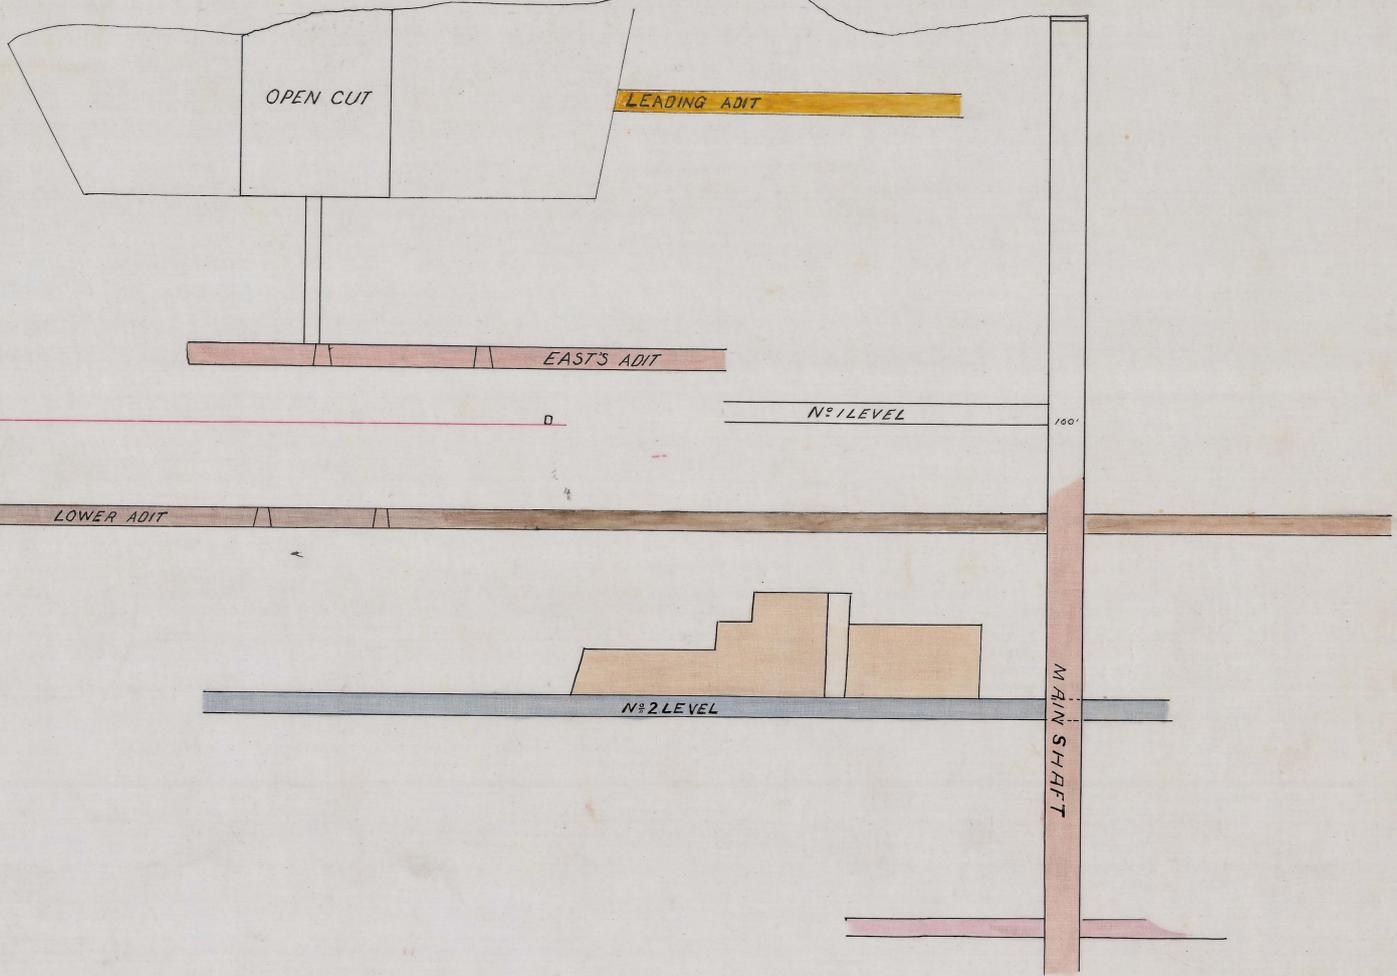

355
02

5 cm

GOVERNMENT GEOLOGICAL SURVEY

GOVERNMENT GEOLOGICAL SURVEY
6 - JUN 1906

25/3/04

GOVERNMENT GEOLOGICAL SURVEY
MAY 9 1910
LAUNCESTON

W. H. Ripps
 Mining Surveyor
 Comet S.M.C.
 14/3/04
 19/5/05
 O.L.P. 11/6/10
AB 26/10/12