


355
03

355
03

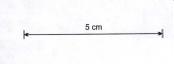

PLAN OF THE COMET MINE. MOUNT DUNDA'S.


SCALE-- 20 feet to an inch.




MAESTRIES.

ADIT

MAIN SHAFT

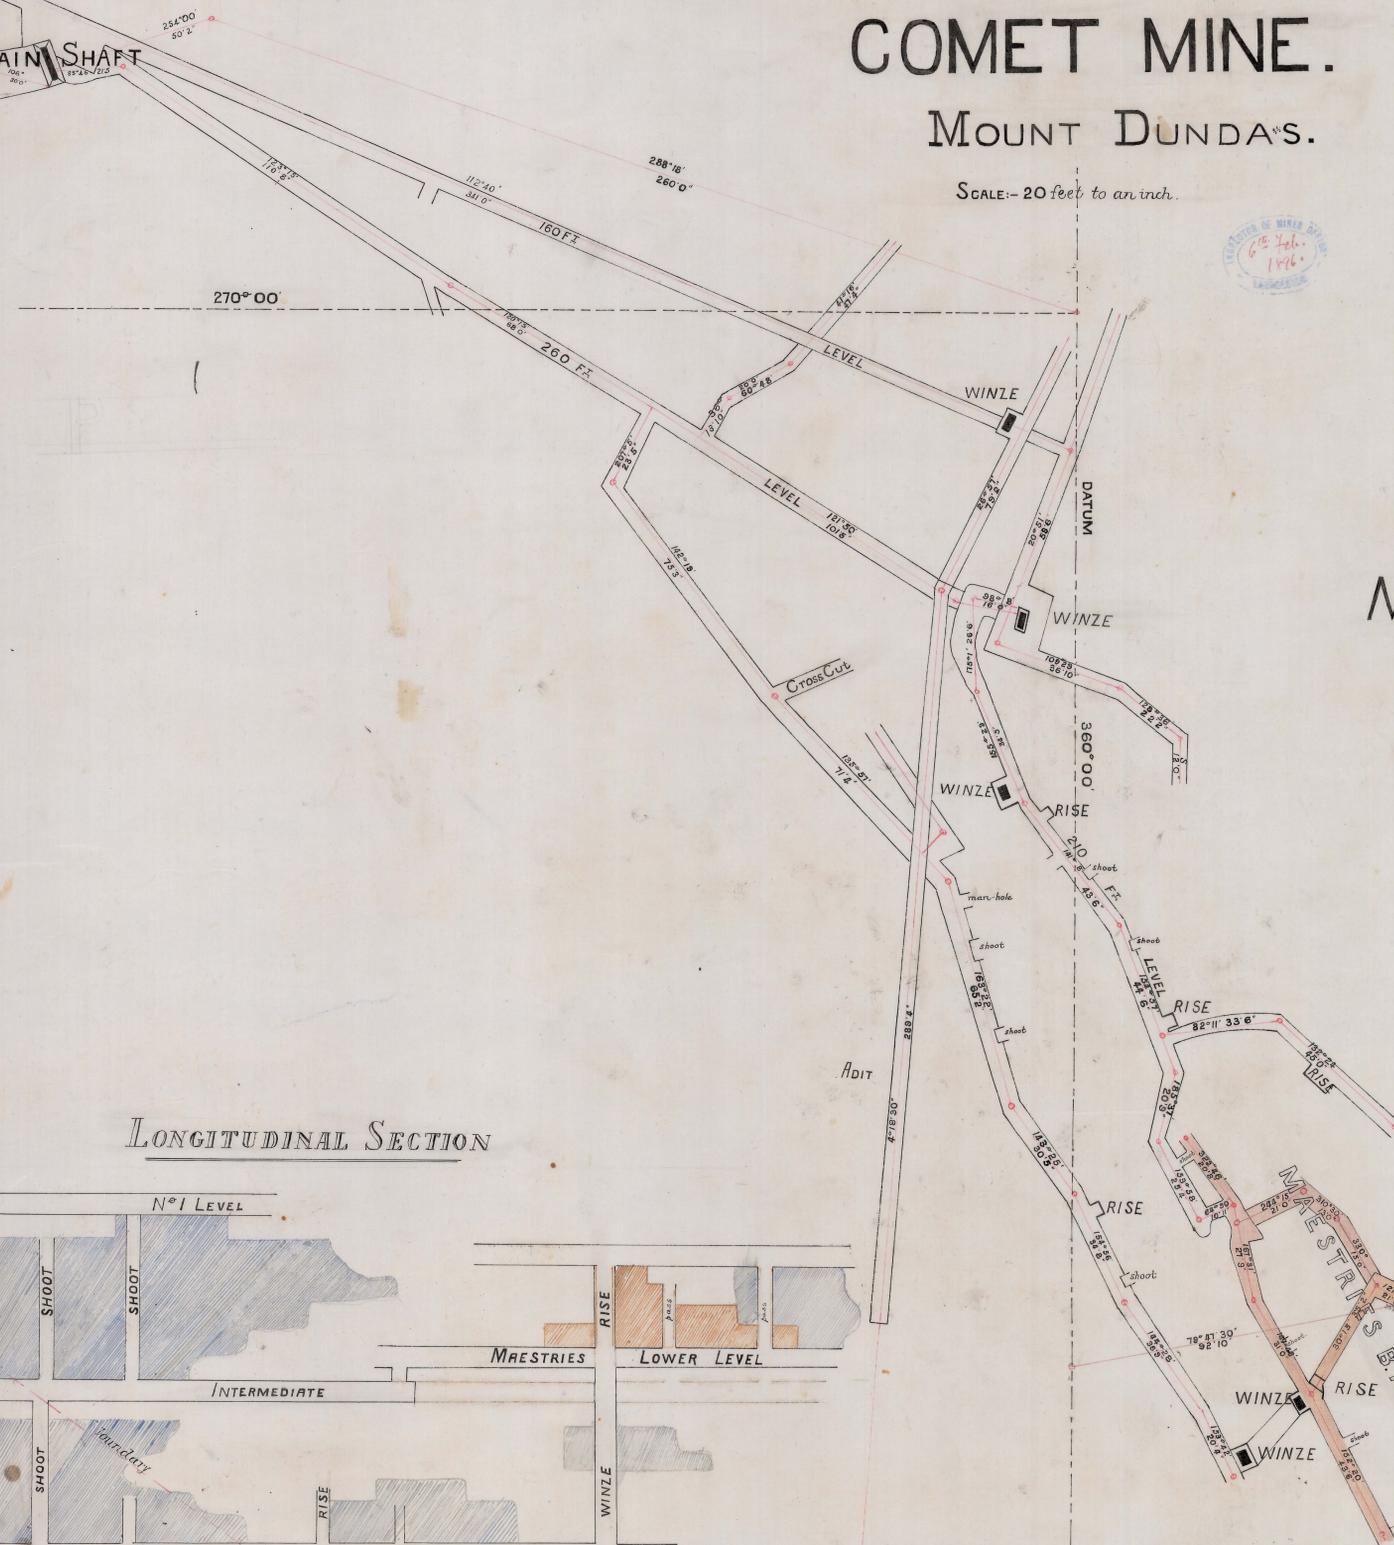

LONGITUDINAL SECTION

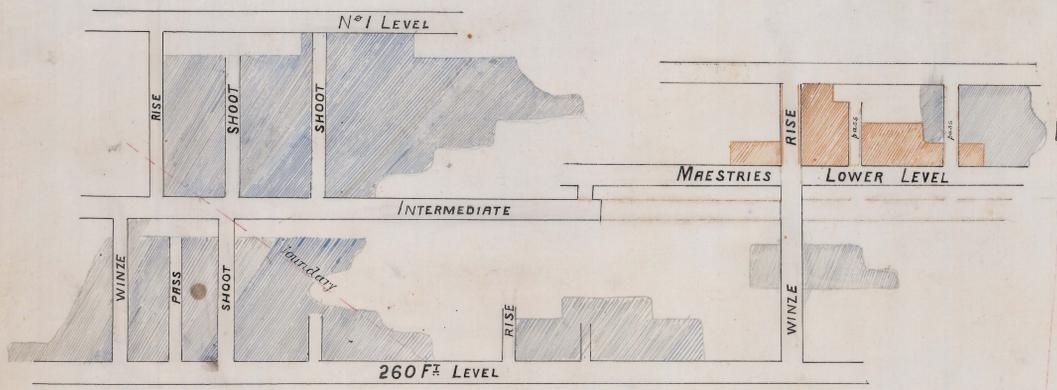

W. Budden
Mining Engineer
23/1/96

1896
M. J. Jones