



355
01

355
01

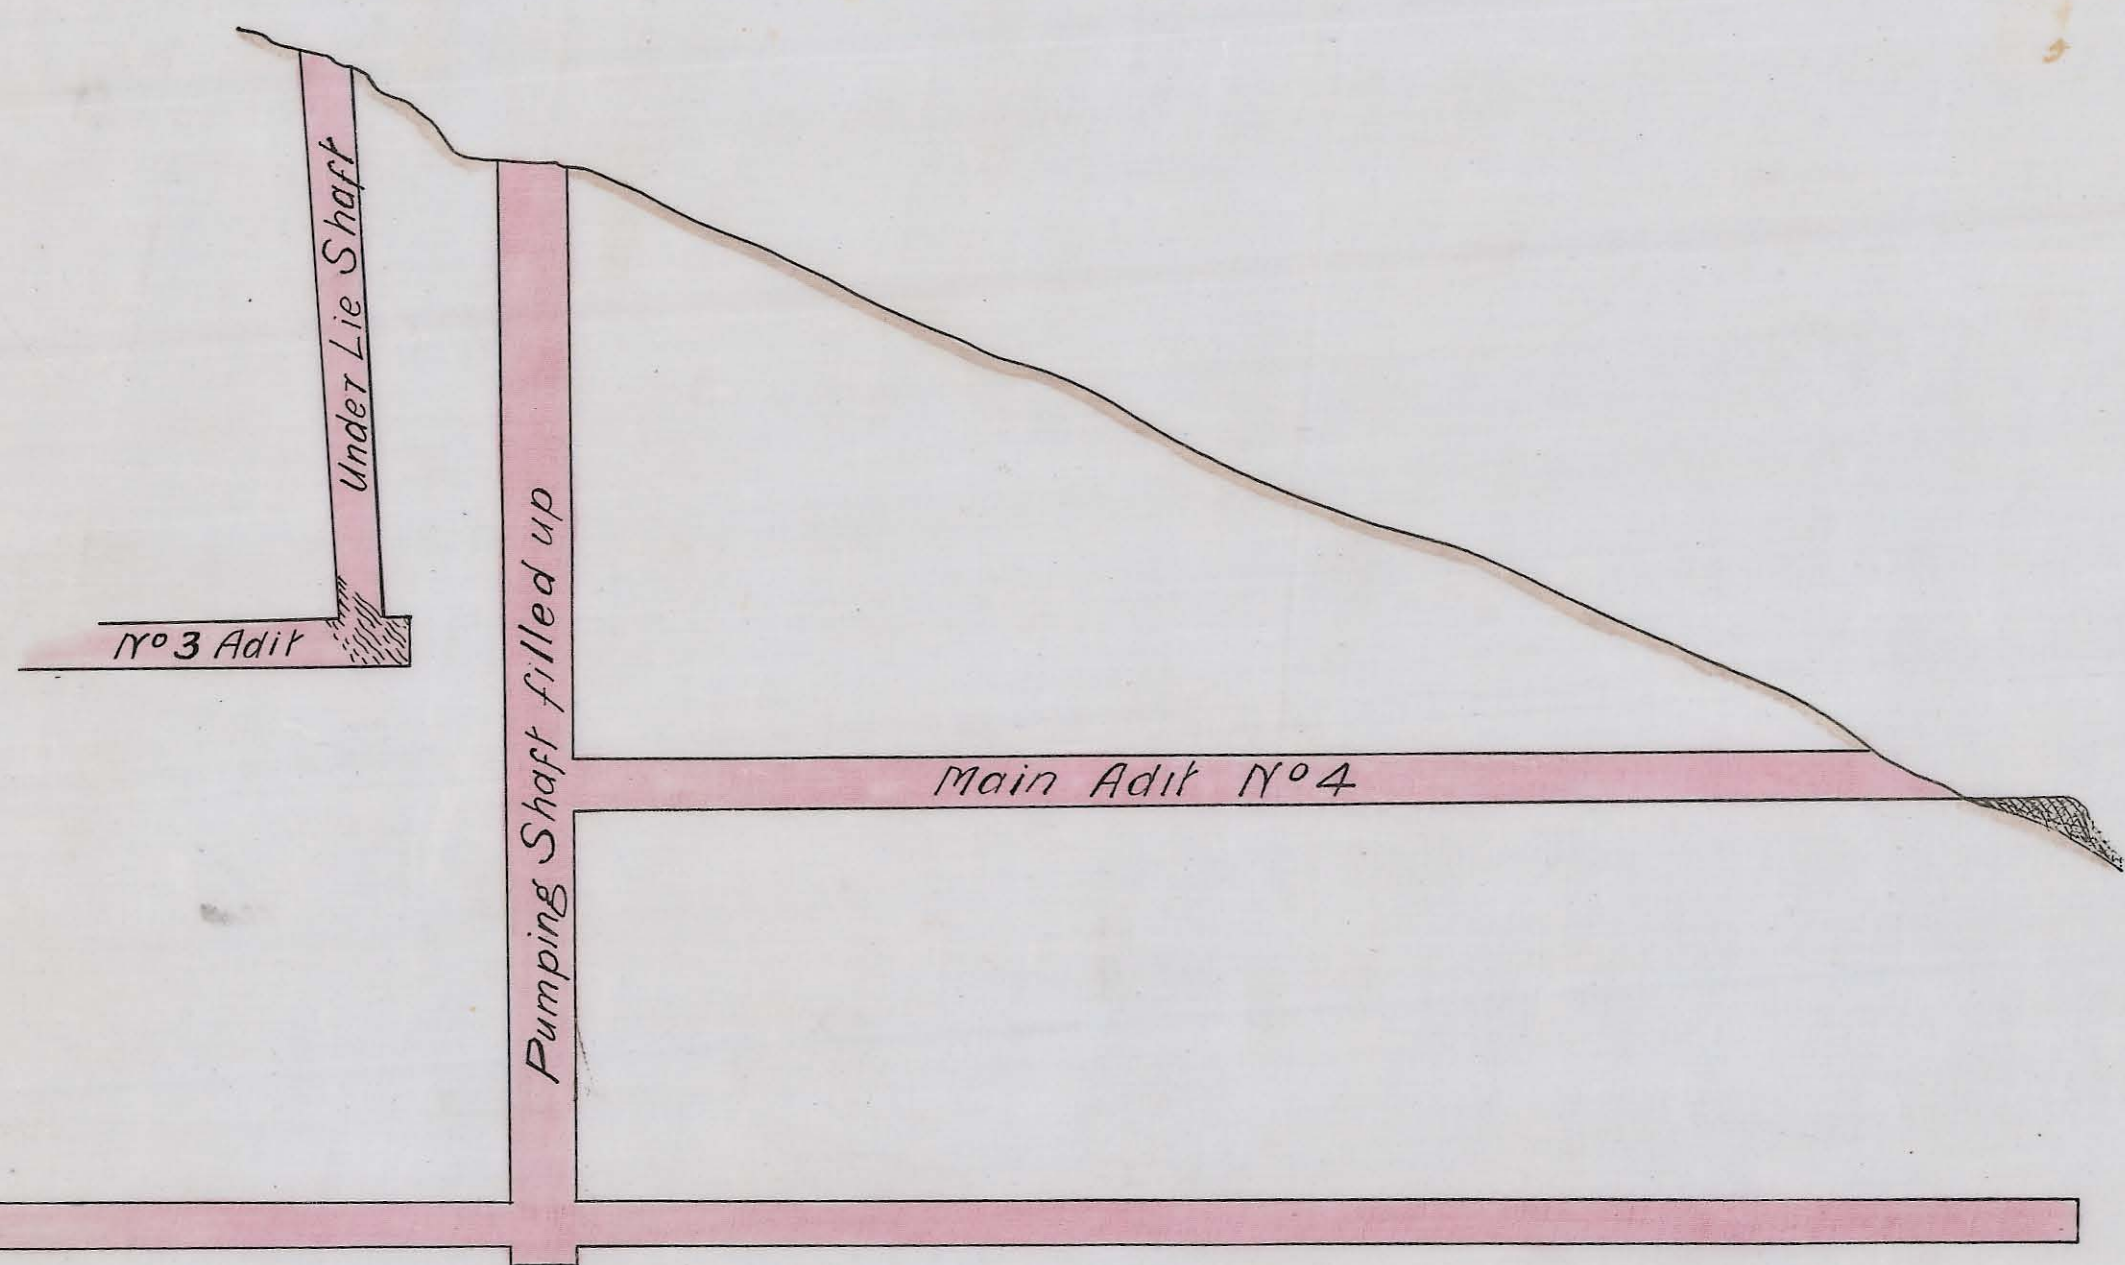

Section of old workings

6cm

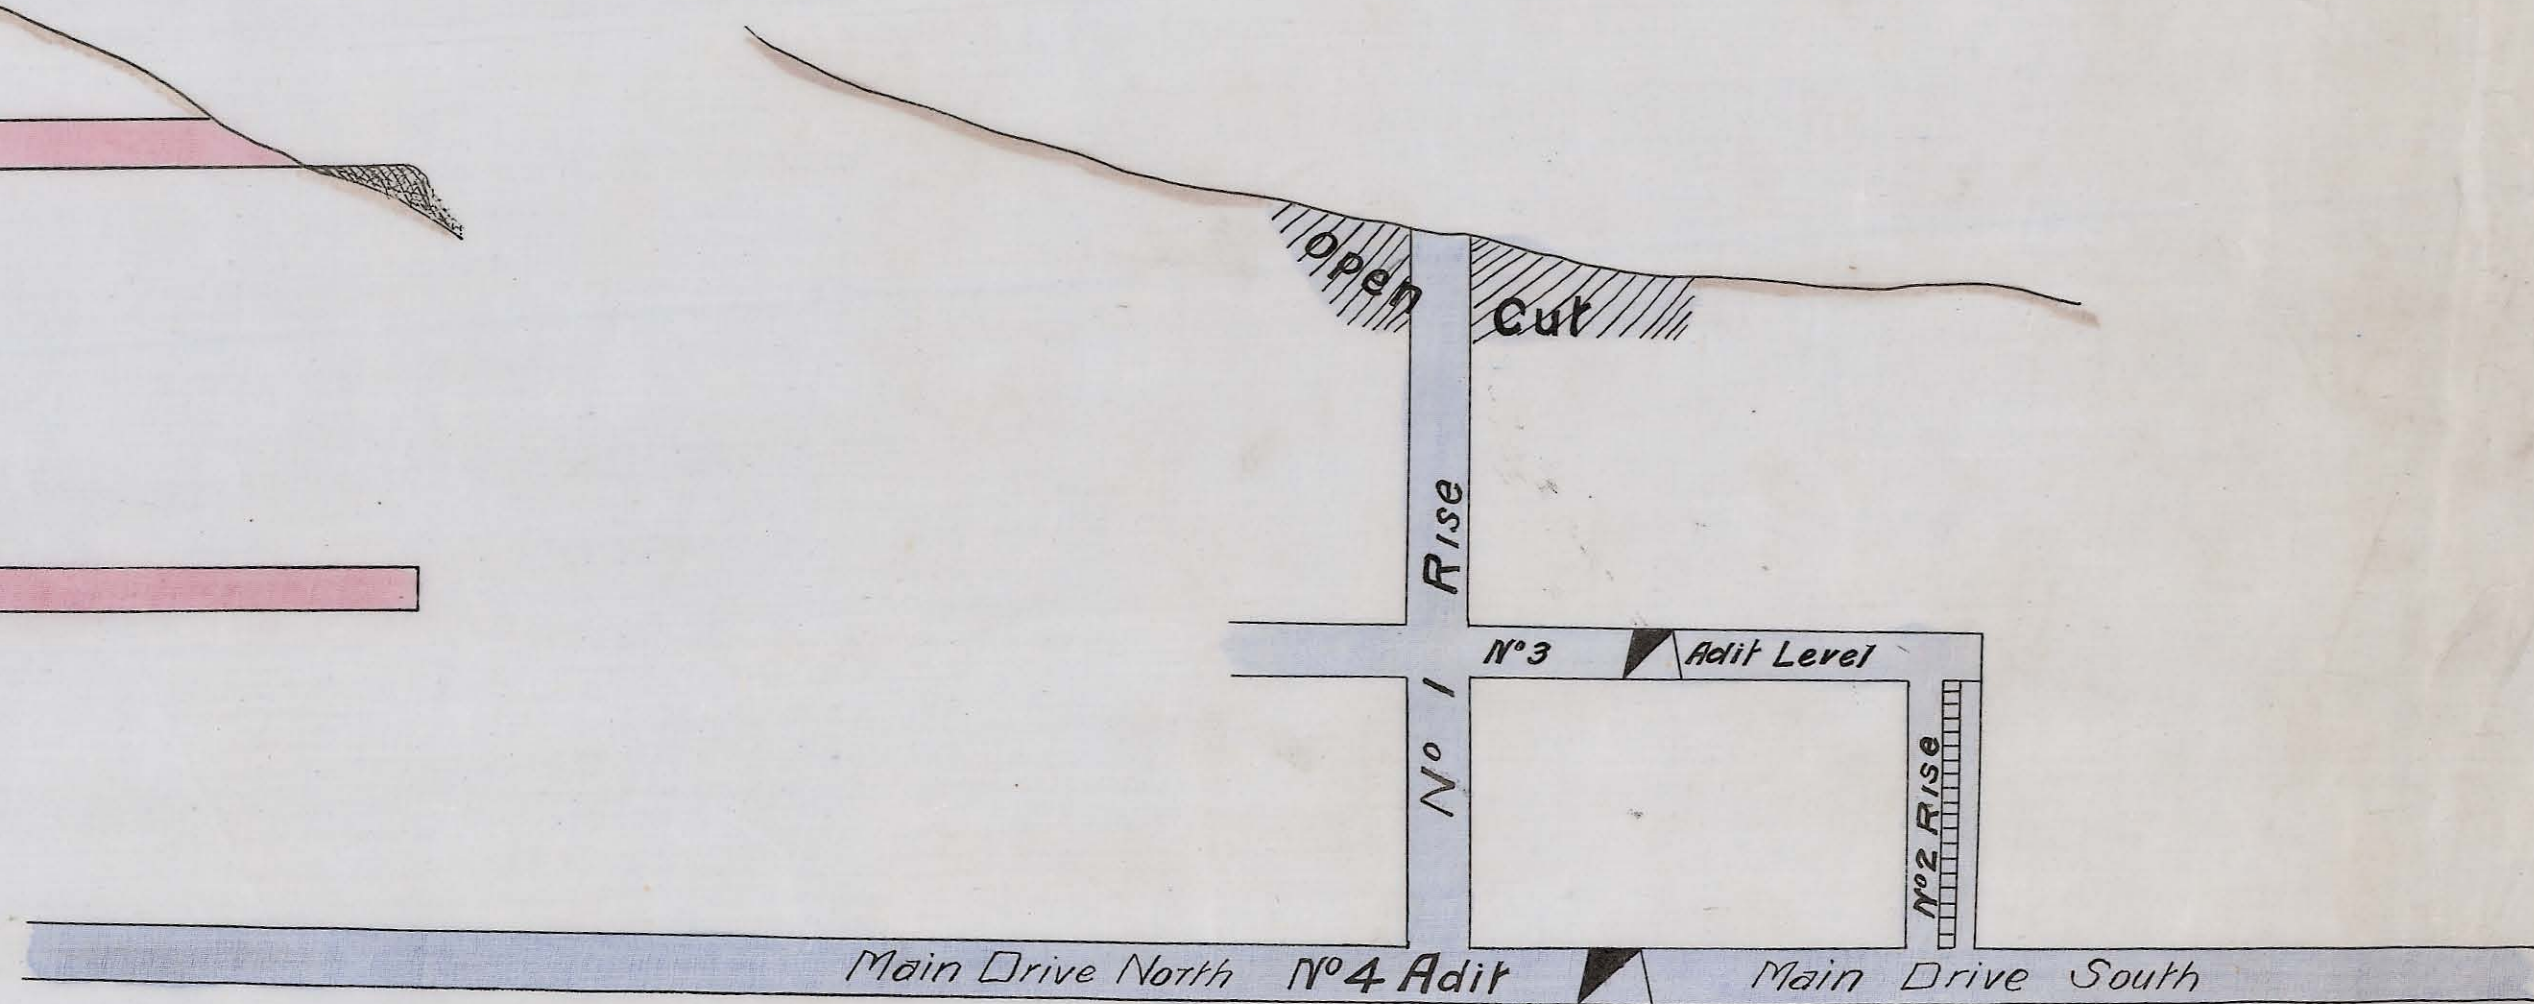

Section of our Workings