
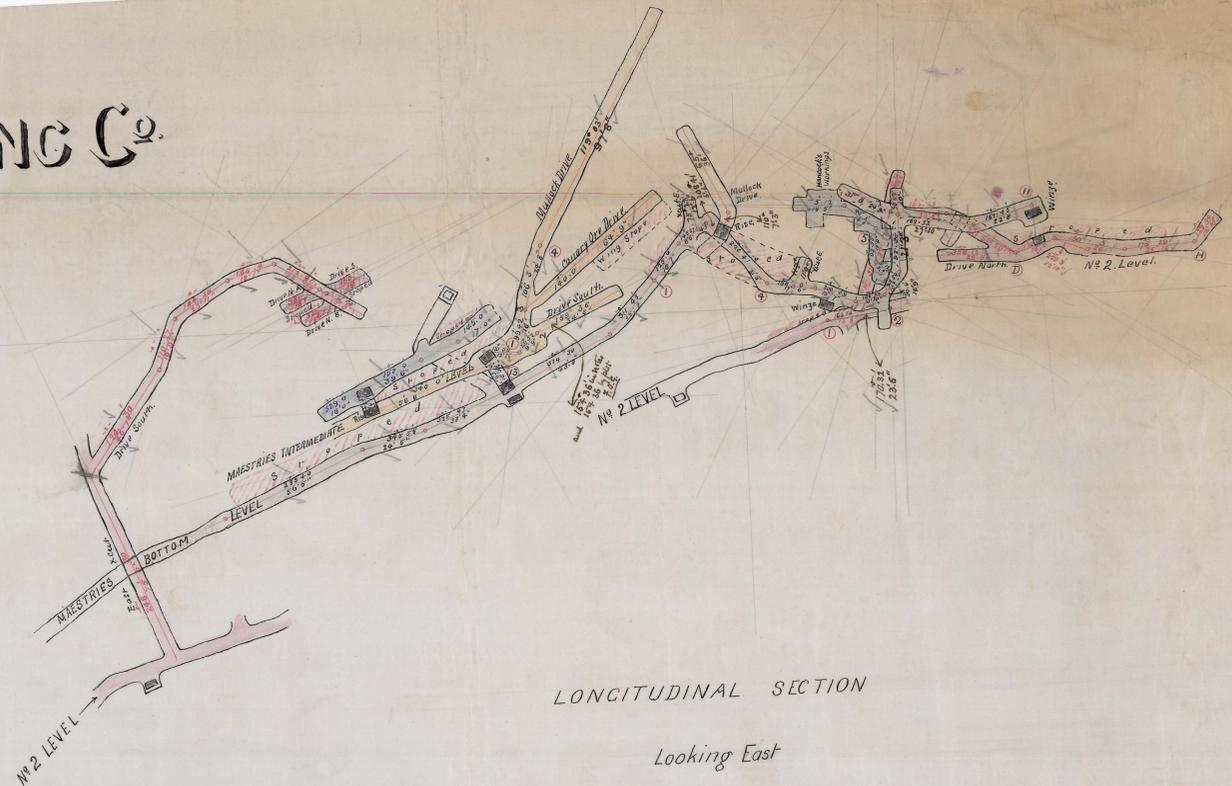
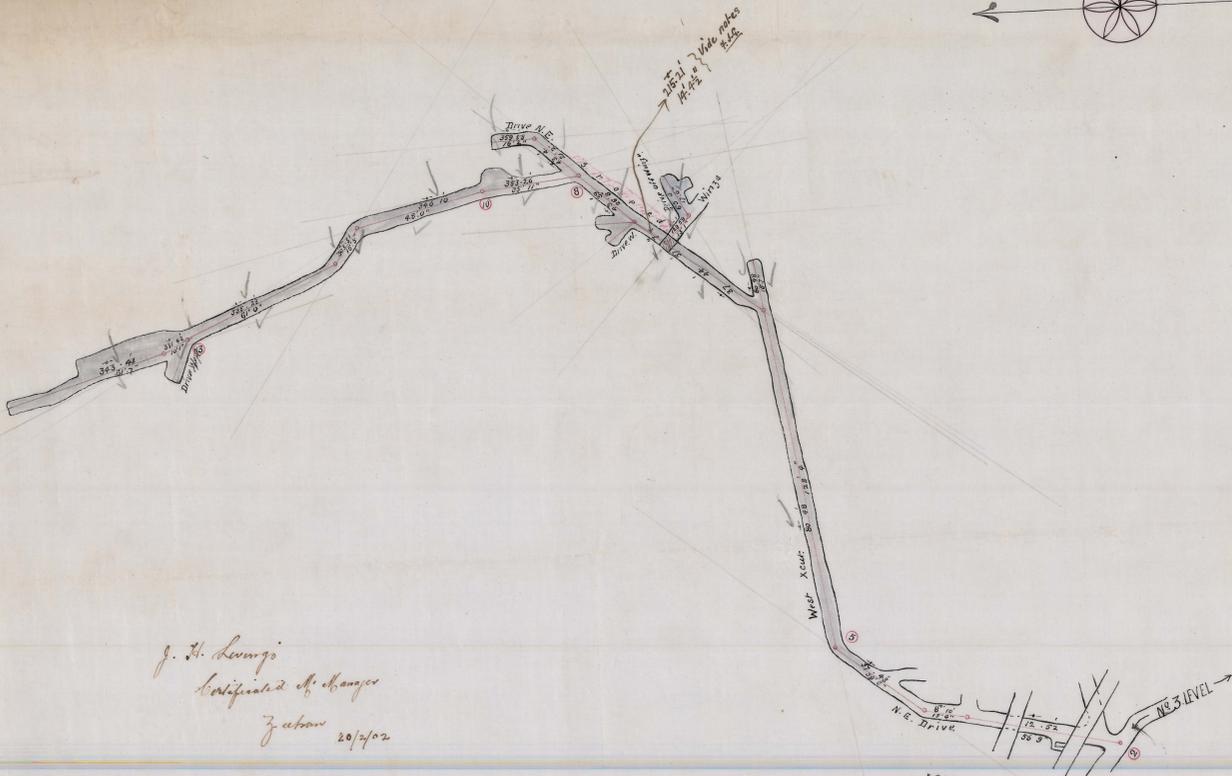


THE COMET SILVER MINING CO.


NO LIABILITY.

Scale.
1 Inch = 25 Feet

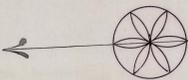

LONGITUDINAL SECTION
Looking East

J. H. Leming
Inspector of Mines
Zachary 20/2/02

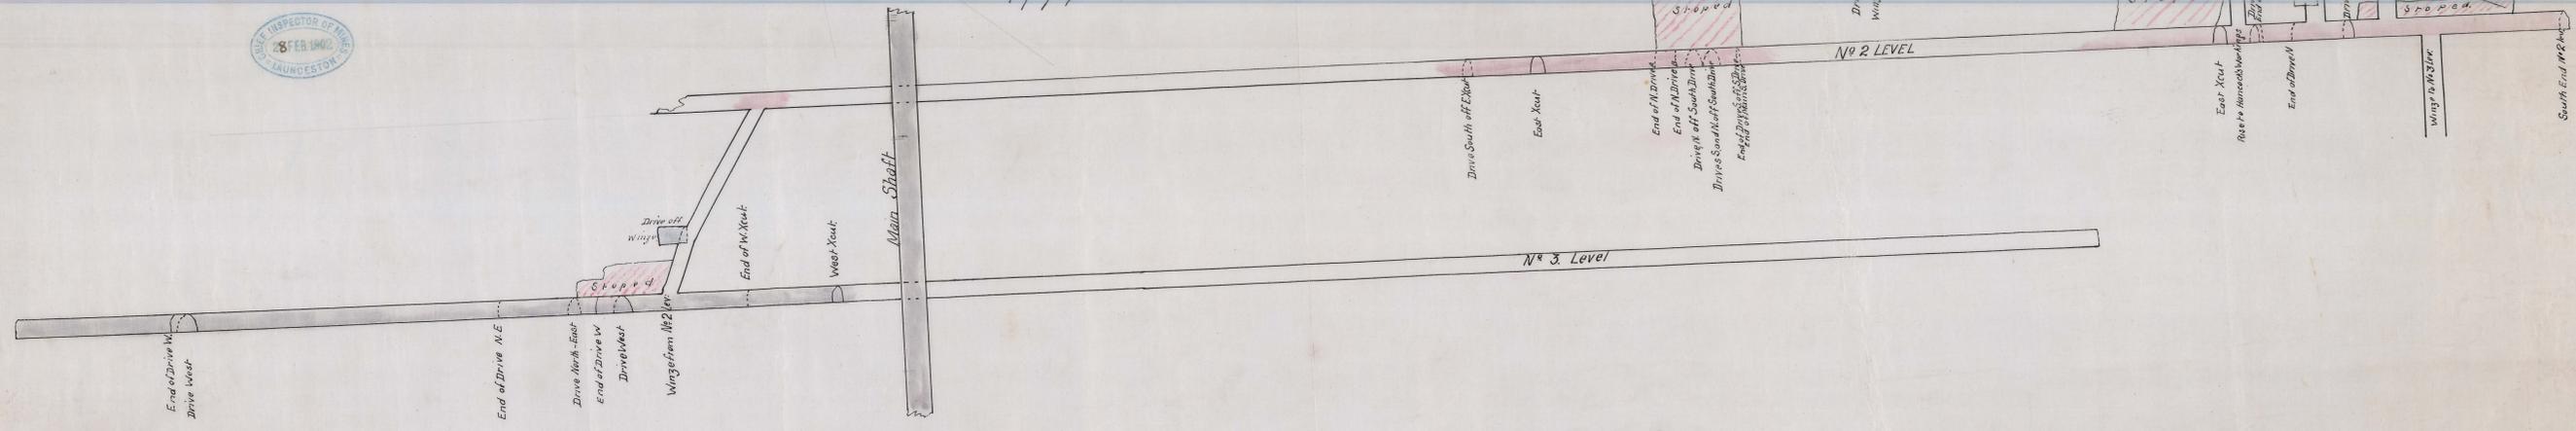

80
55
52

100 ft 1902

100 ft 1902

22