

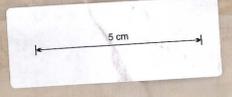


355
11

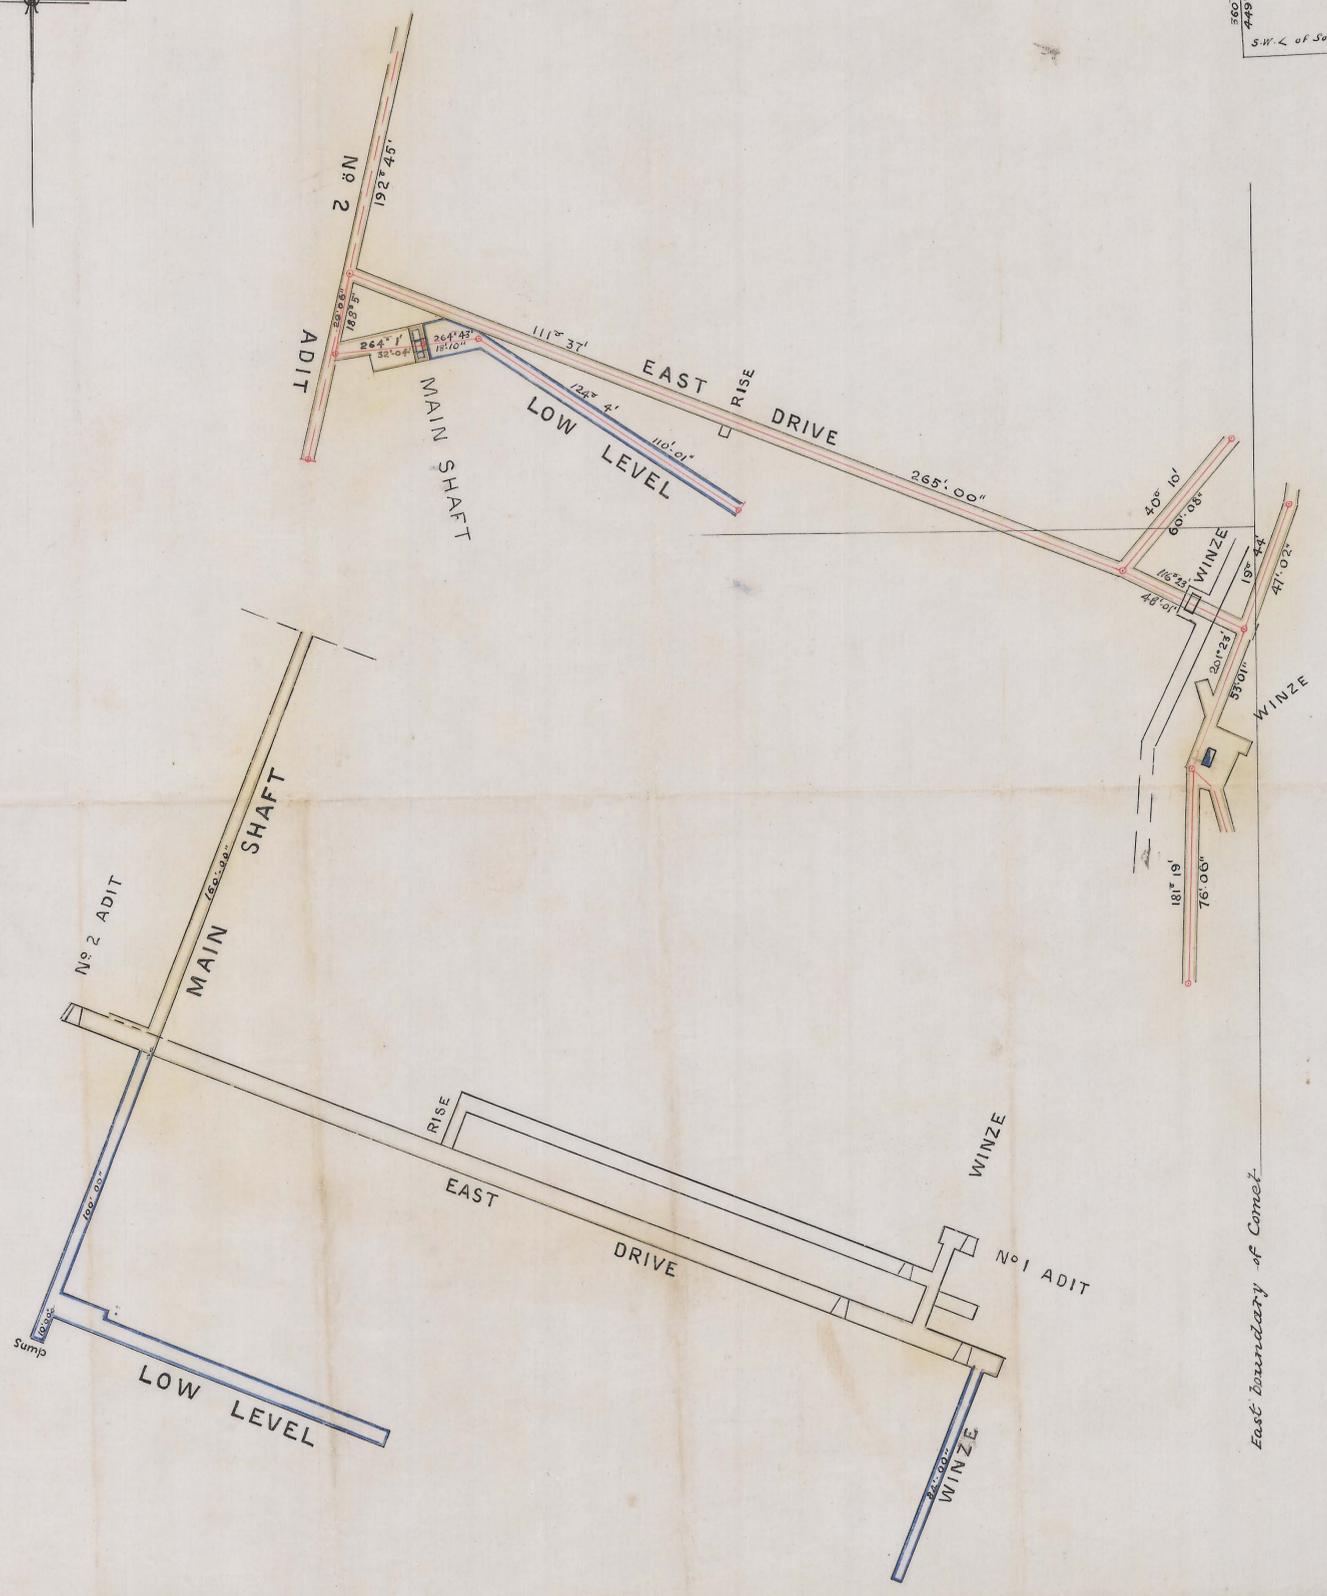

COMET S. M. MINING WORKS

Scale 30 feet to an inch

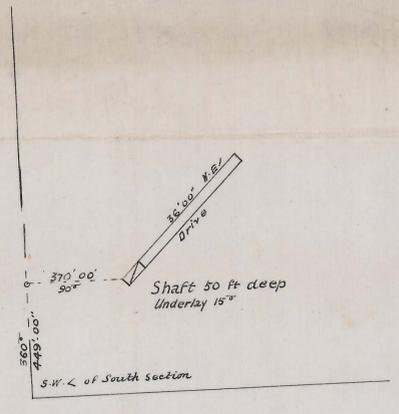

East boundary of Comet

Choklov
Anto Surveys
Leekham Jan 94

55