



COMET S.M.
MINING WORKS
DUNDAS

Scale 20 feet to an inch

10th April
1895.
LAURISTON

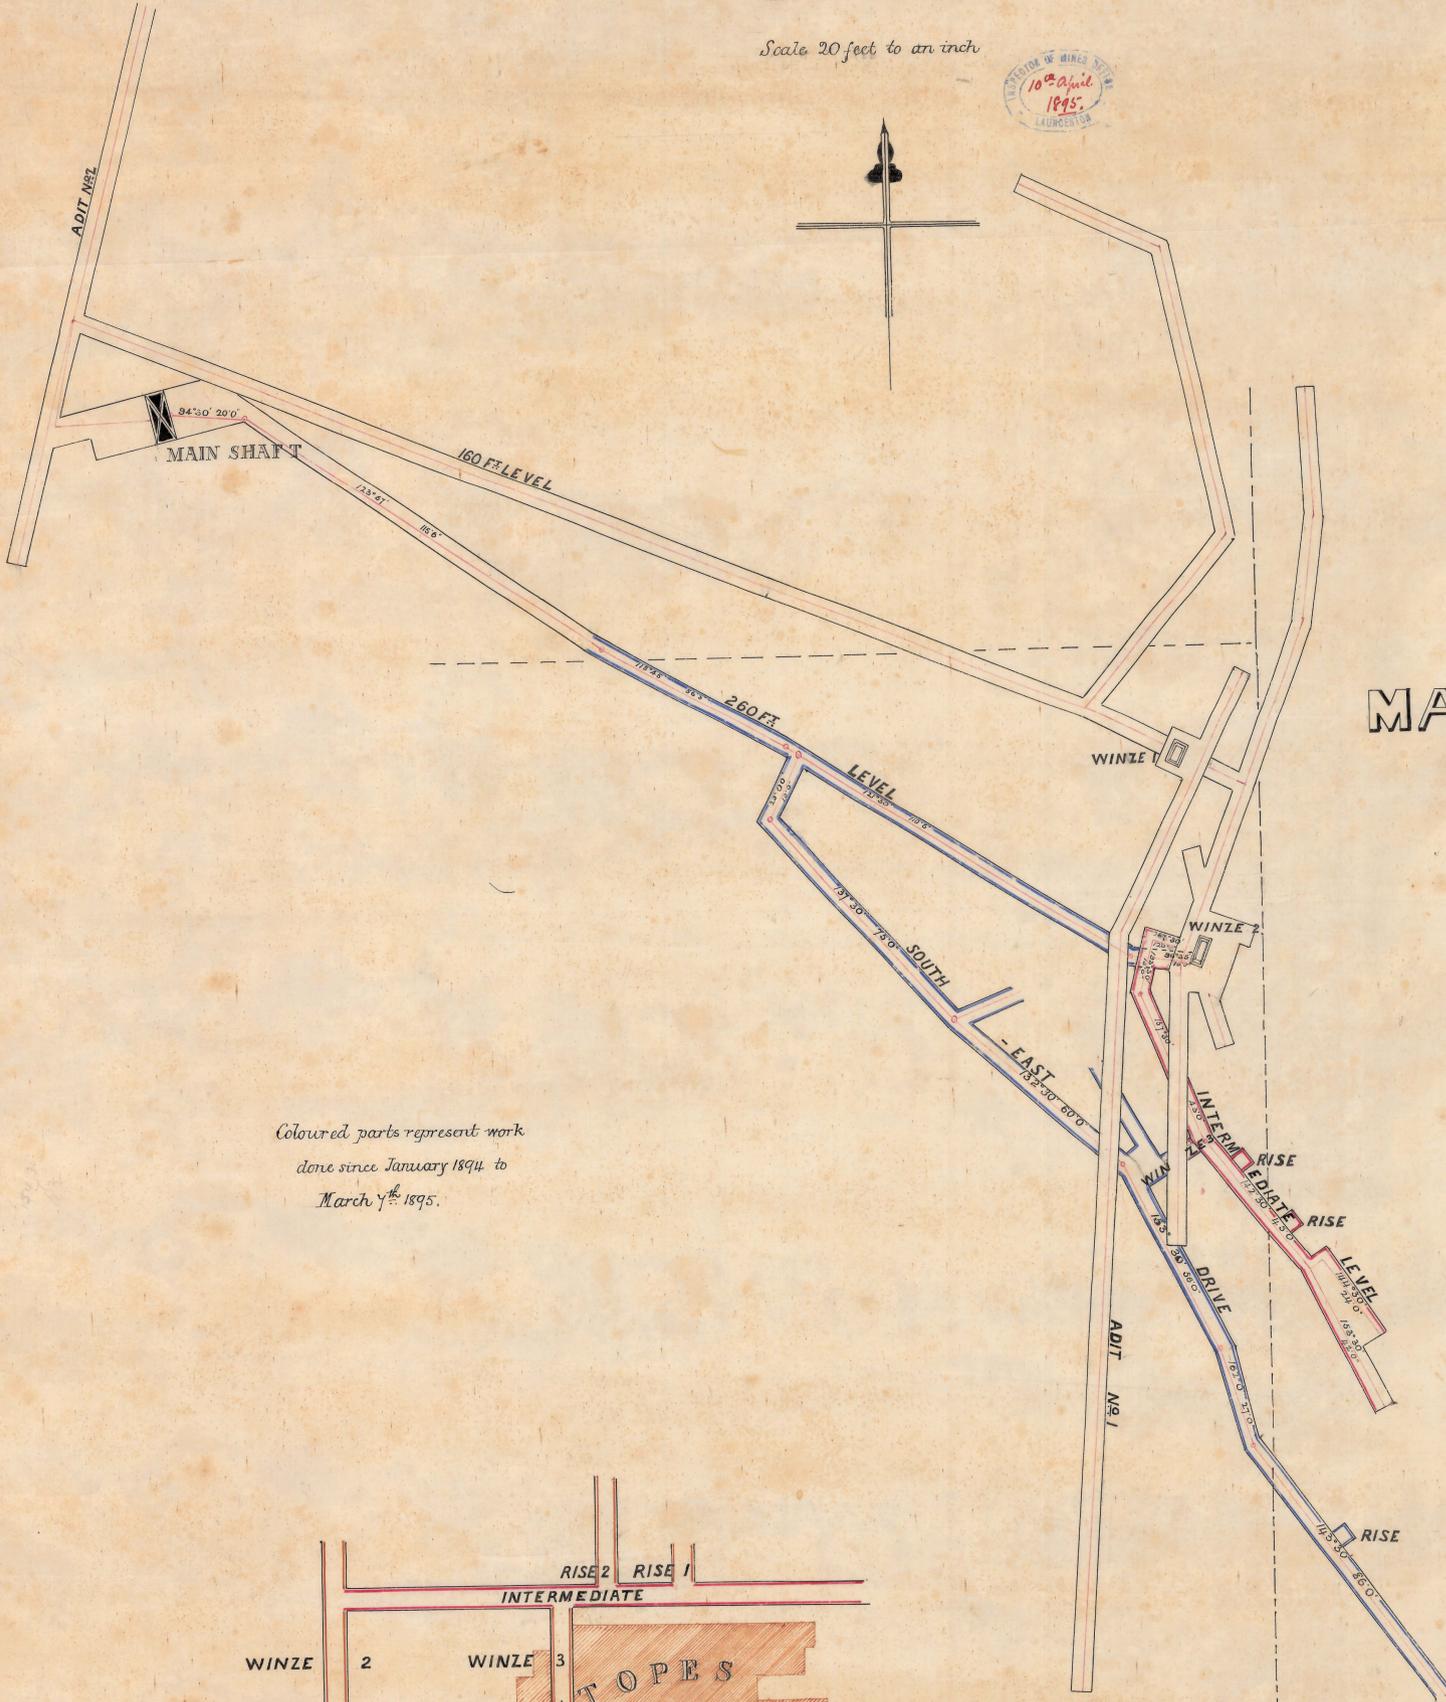

Coloured parts represent work done since January 1894 to March 7th 1895.

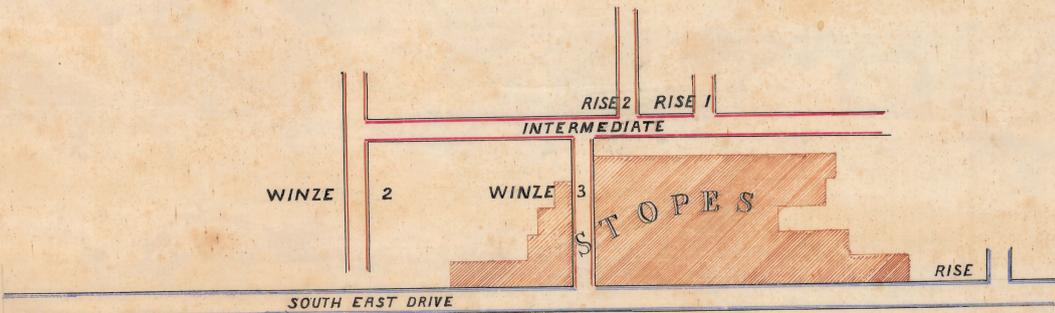

W. Budden, g.
Mining Engineer