


COMET S.M.C. WORKING PLAN

Scale 20 feet to an inch.



LONGITUDINAL SECTION.

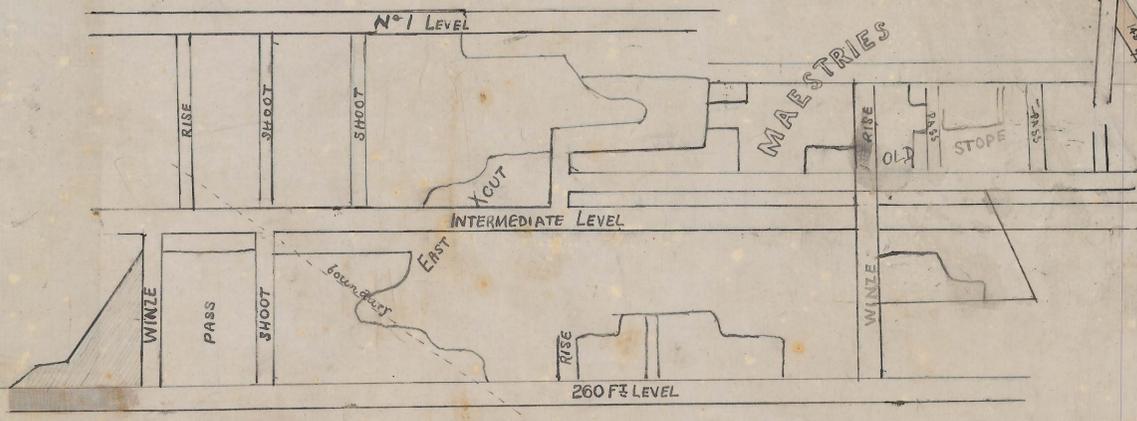

7.3.13 (67.9)
 MAP NO
 27-11.2

AIR SHAFT
 external off-scale