


0555-027

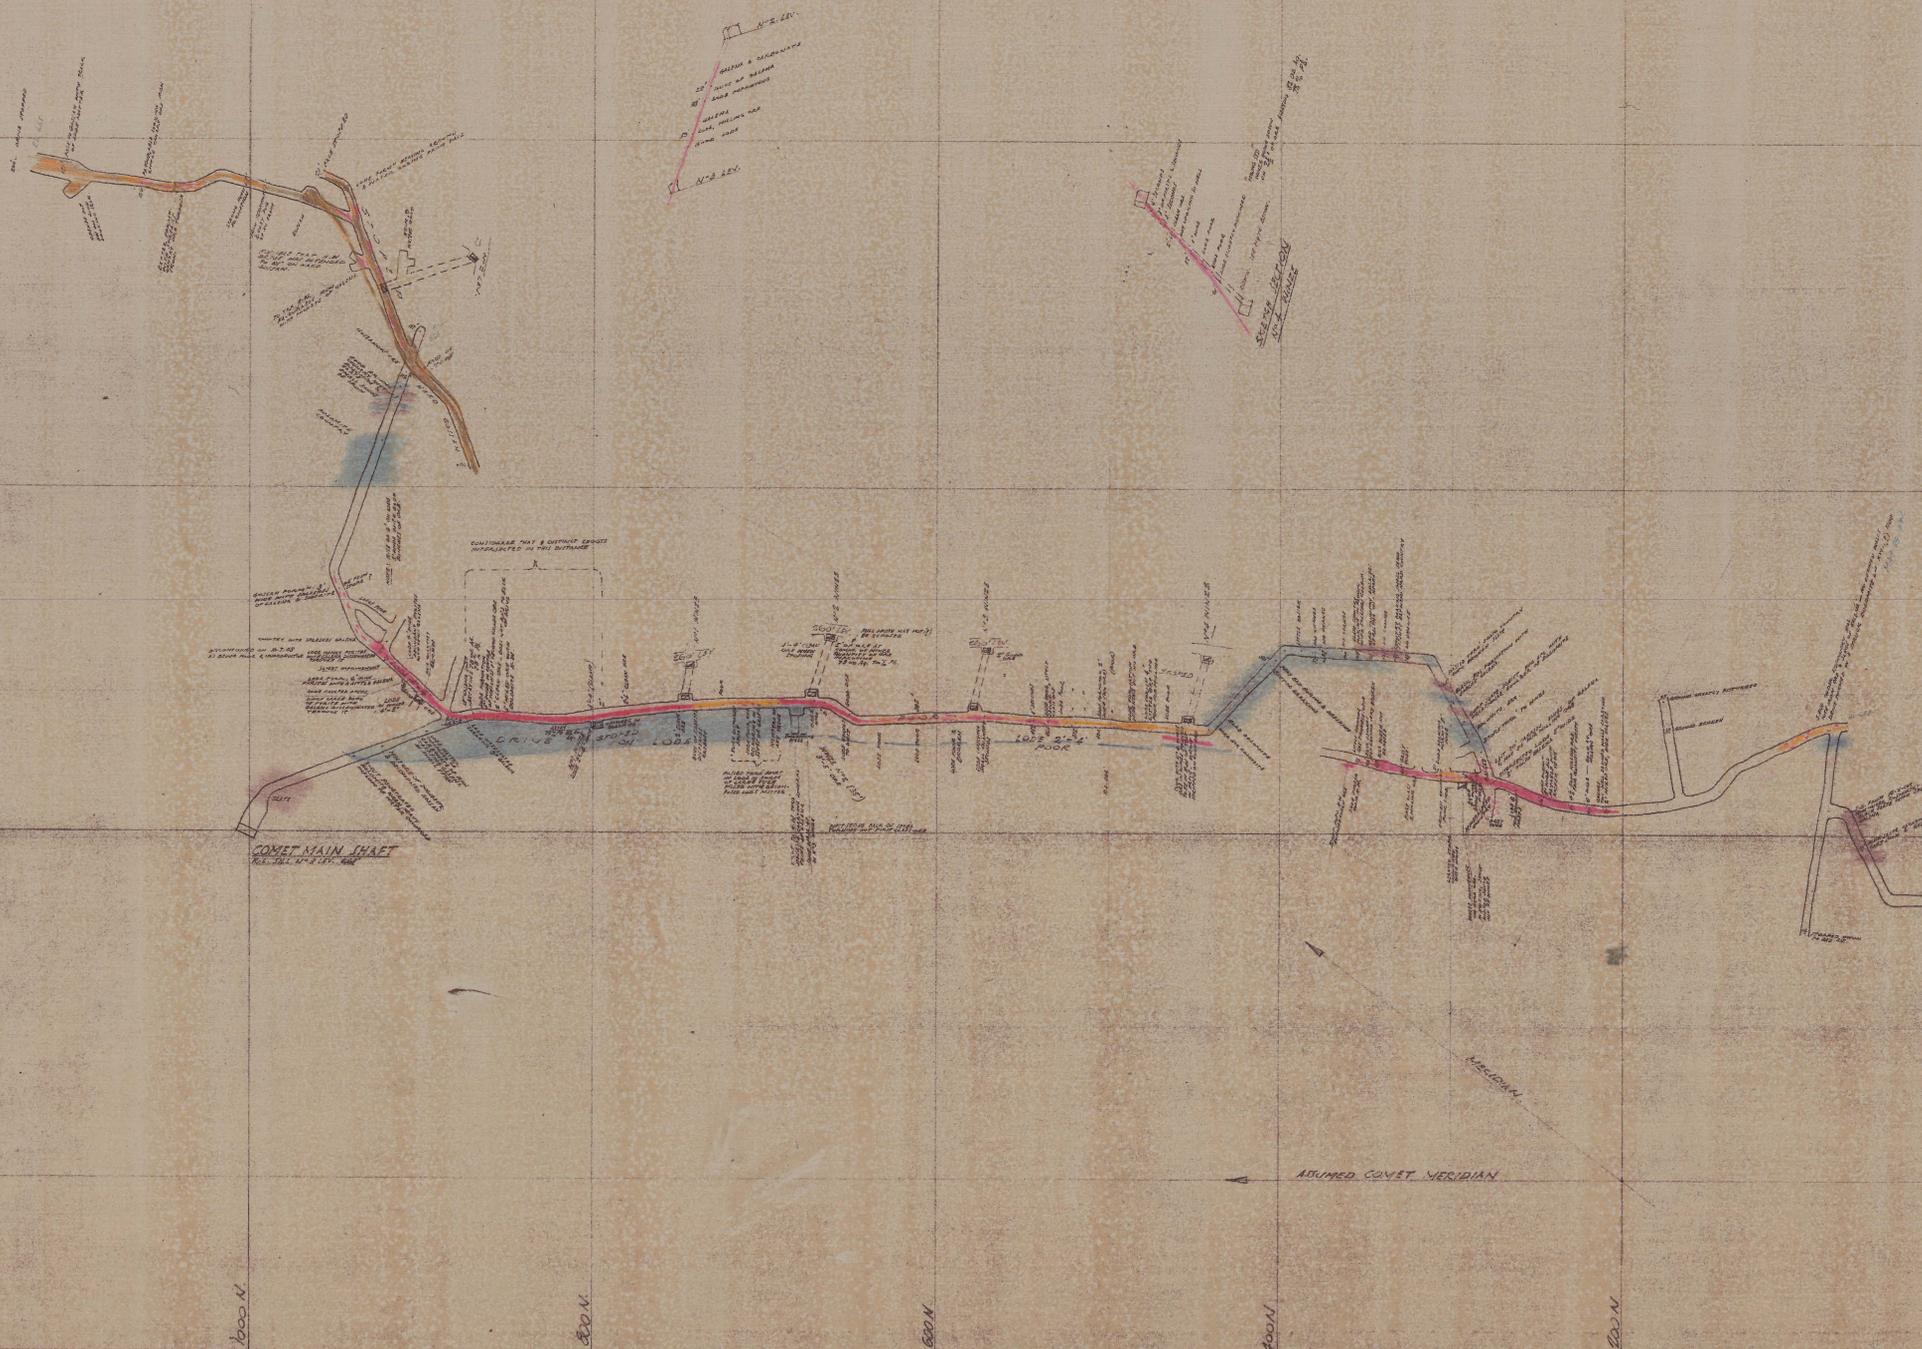

SCALE: 1" = 40'

COMET MINE
NO. 3 LEVEL HORIZON

N^o 1-C/10
DATE: APR. '48

7-3-13 (657)