


0355-028

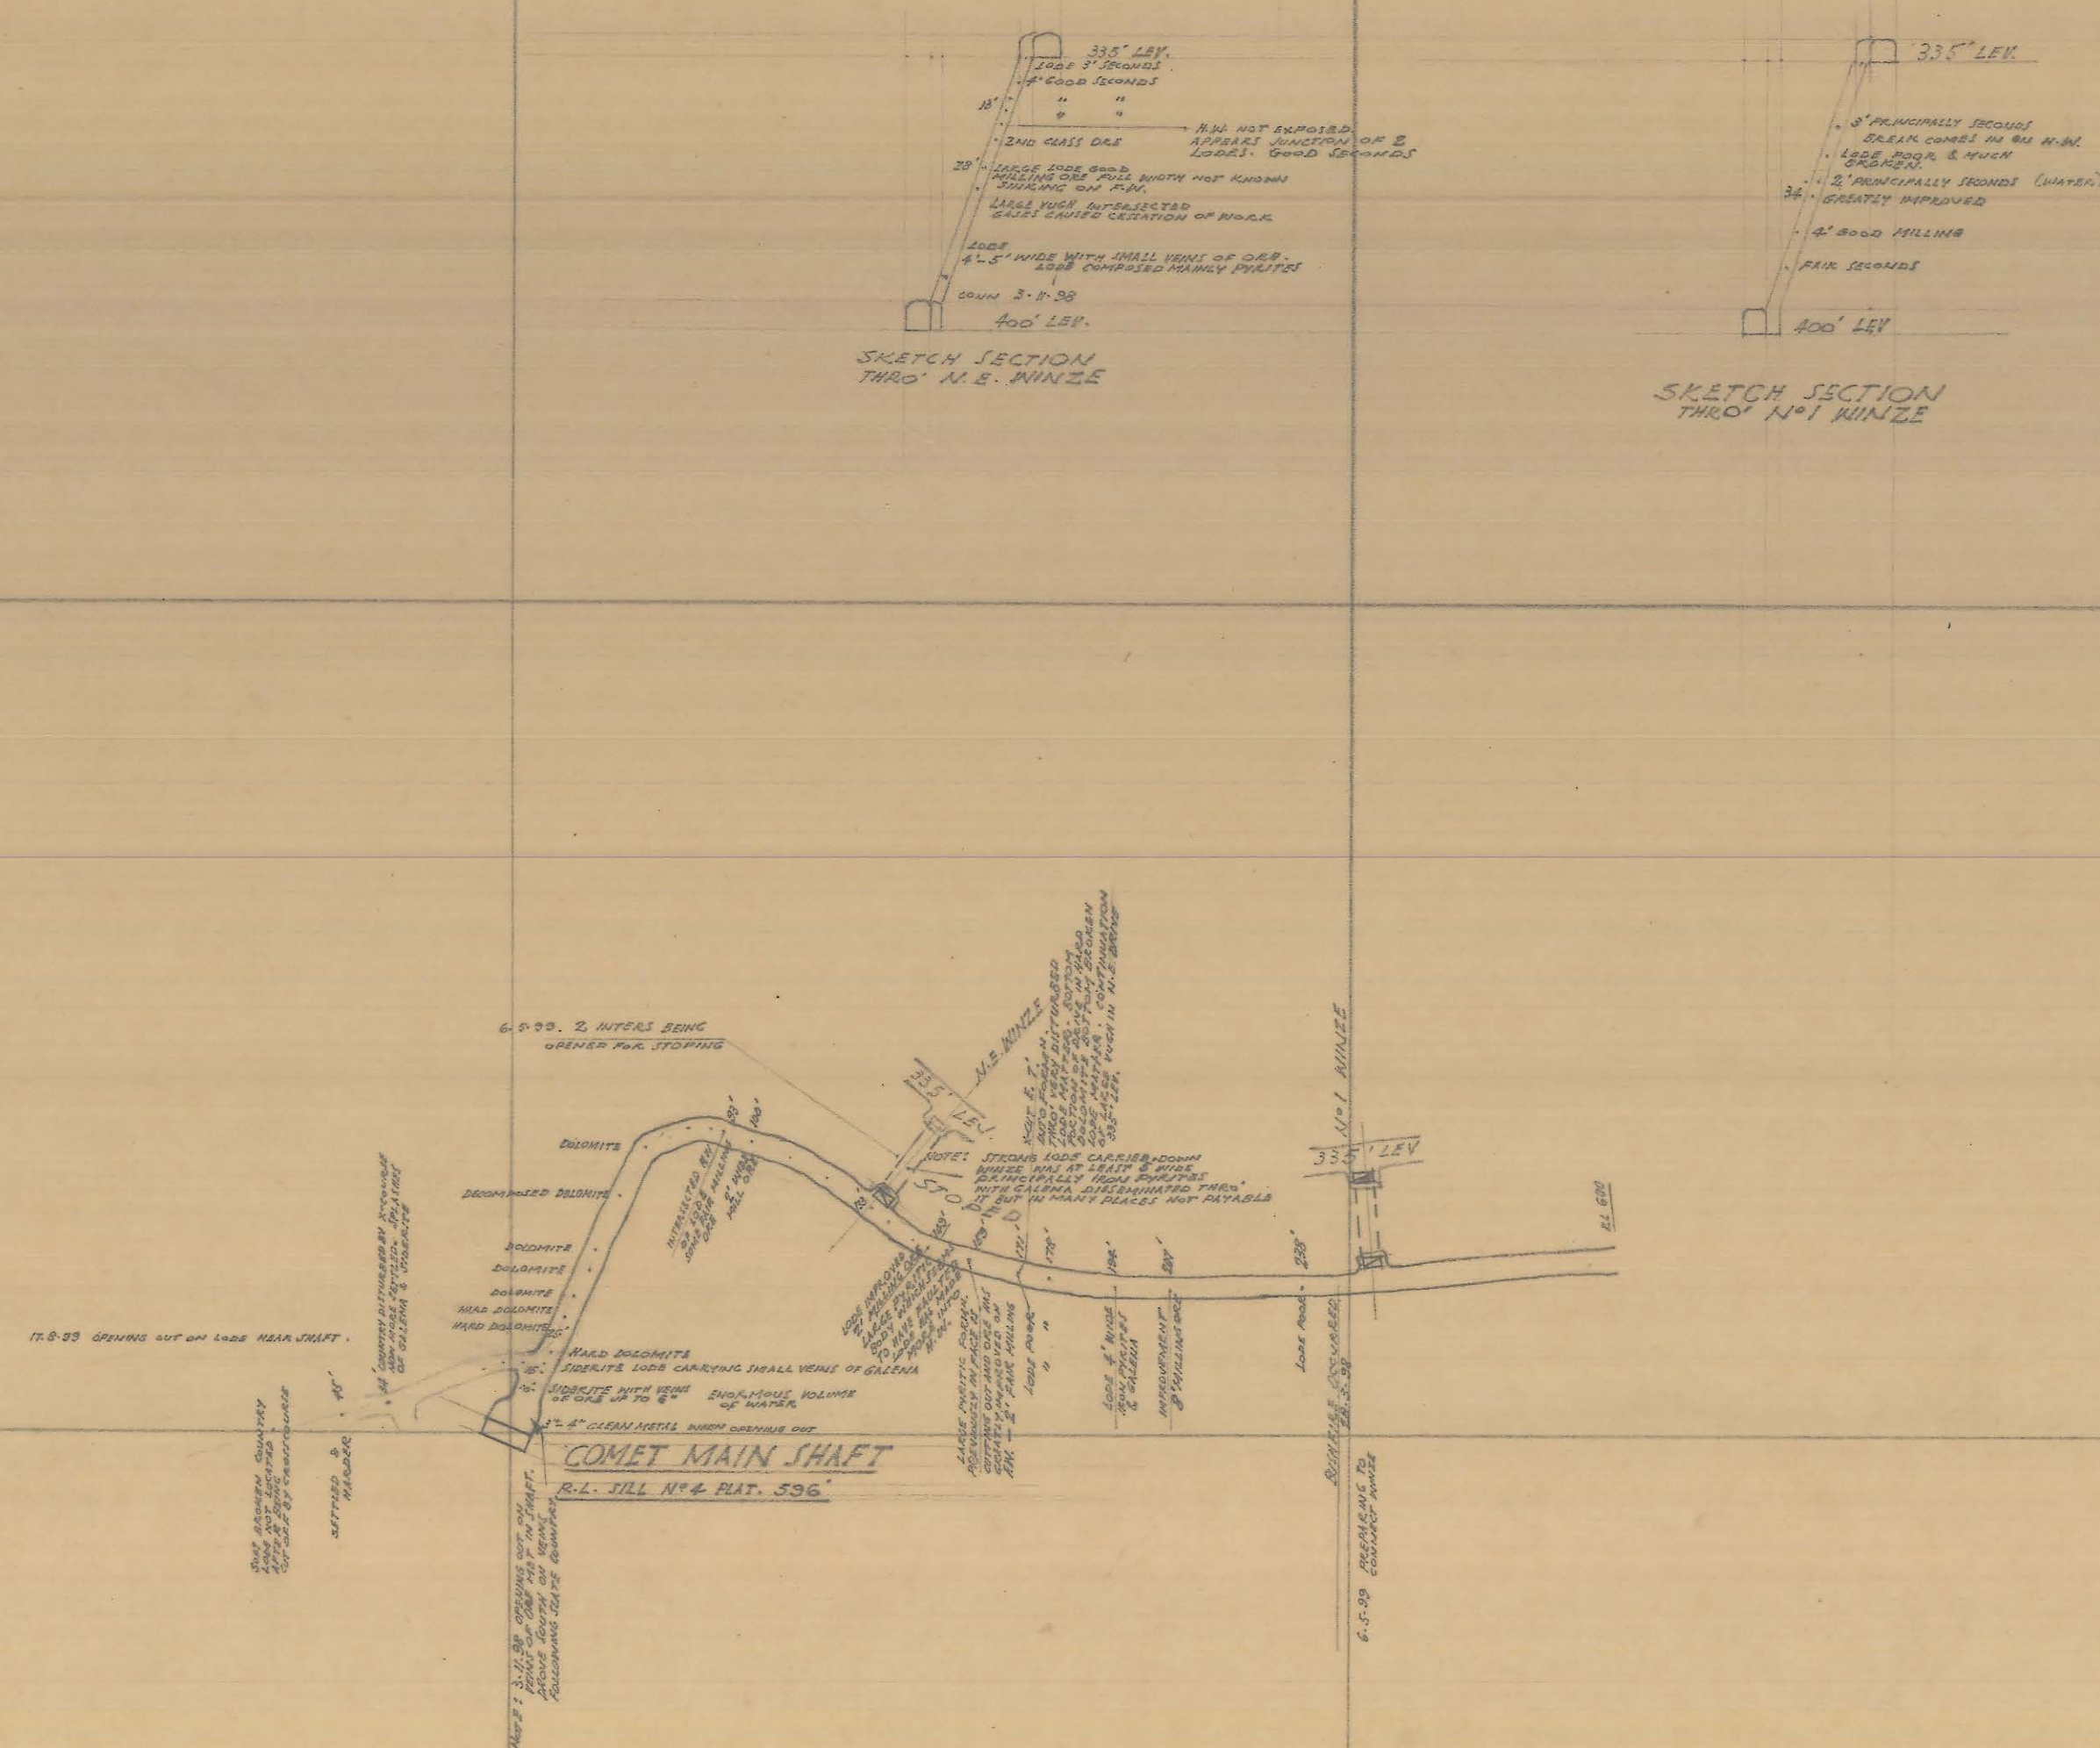

SCALE: 1" = 40'

COMET MINE
No. 4 LEVEL HORIZON

No. 1-C/6
DATE: APR. '48

7-3-13 664

TRIM PRINTS TO THIS BORDER