


0355-041

5 cm

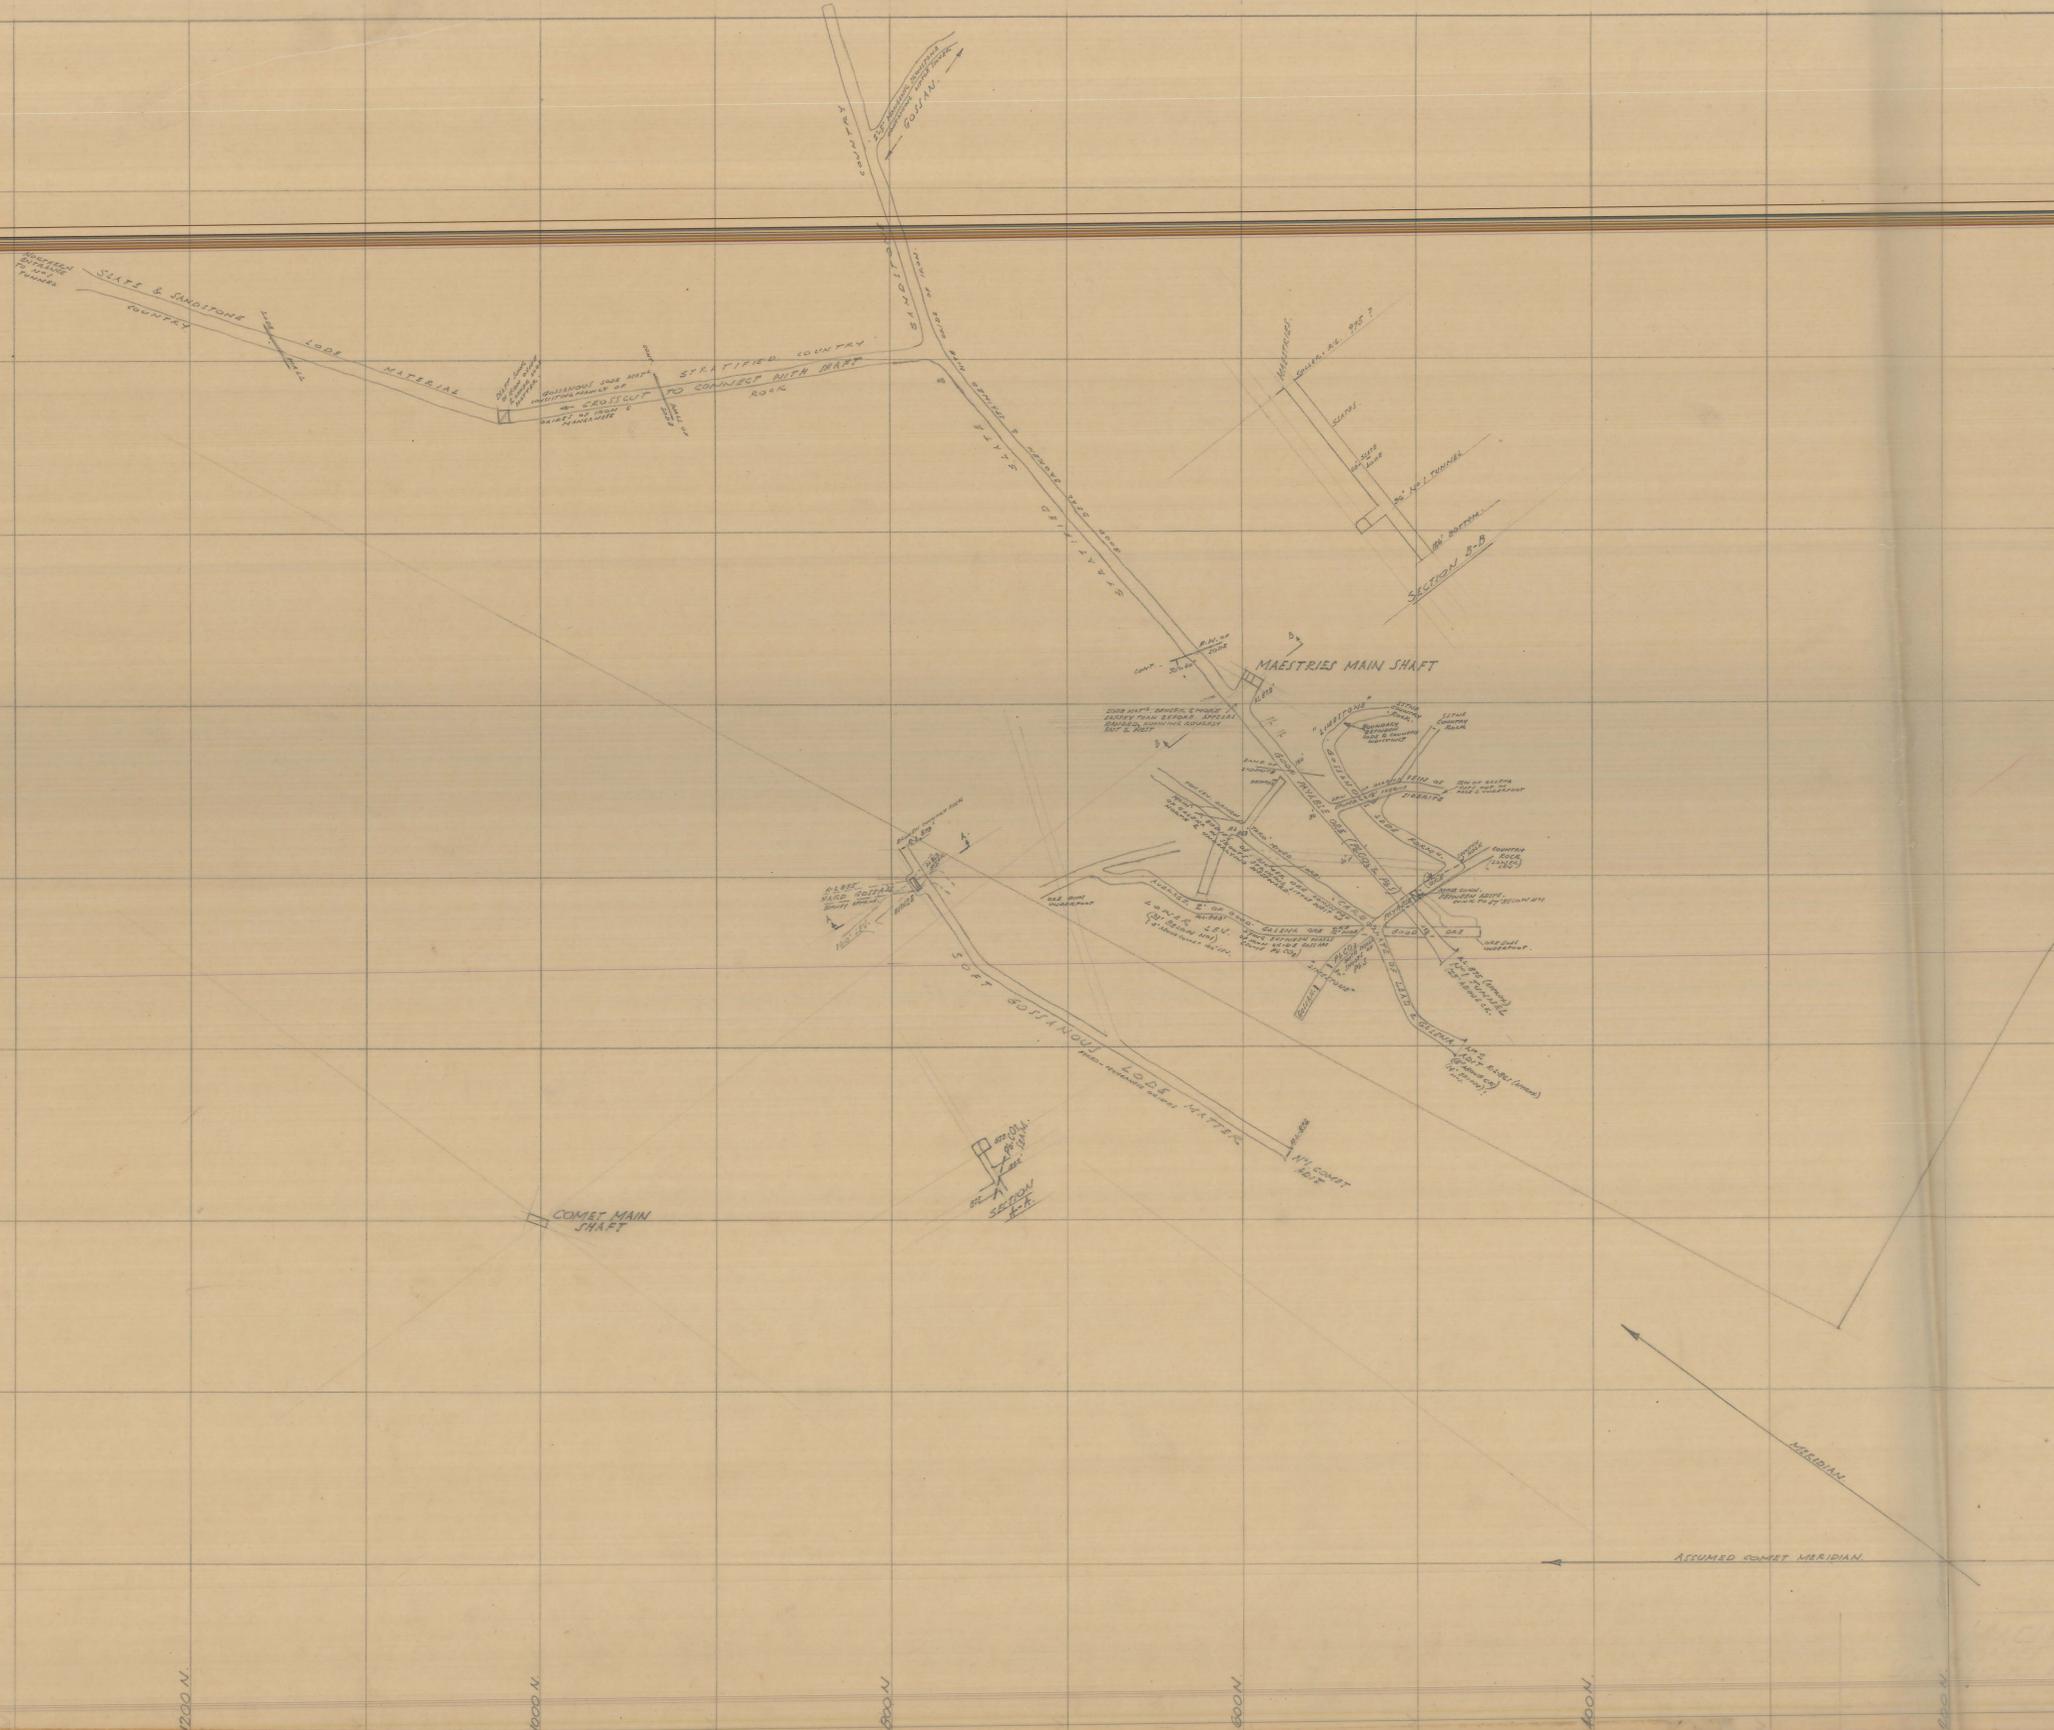

SCALE: 1" = 40'

COMET MINE  
ADIT WORKINGS

Nº 1-C/2  
DATE: APR. '48

7-3-13 (666)

TRIM PRINT TO THIS EDGE

TRIM PRINT TO HERE